

SEEDING

EX. D. SA.

W/10/11/58


280 260 240 220 200 180 160 140 120 100 80 60 40

NO. OF SHEETS	STATE	PROJECT	47
2	OHIO	ACI-1103 (21)	488

This sheet supersedes sheet no. 17 of the original plan.

LAKE COUNTY
LAK-1-12.89

END AREA	CUT	FILL	YDS.
CUT	FILL	CUT	FILL

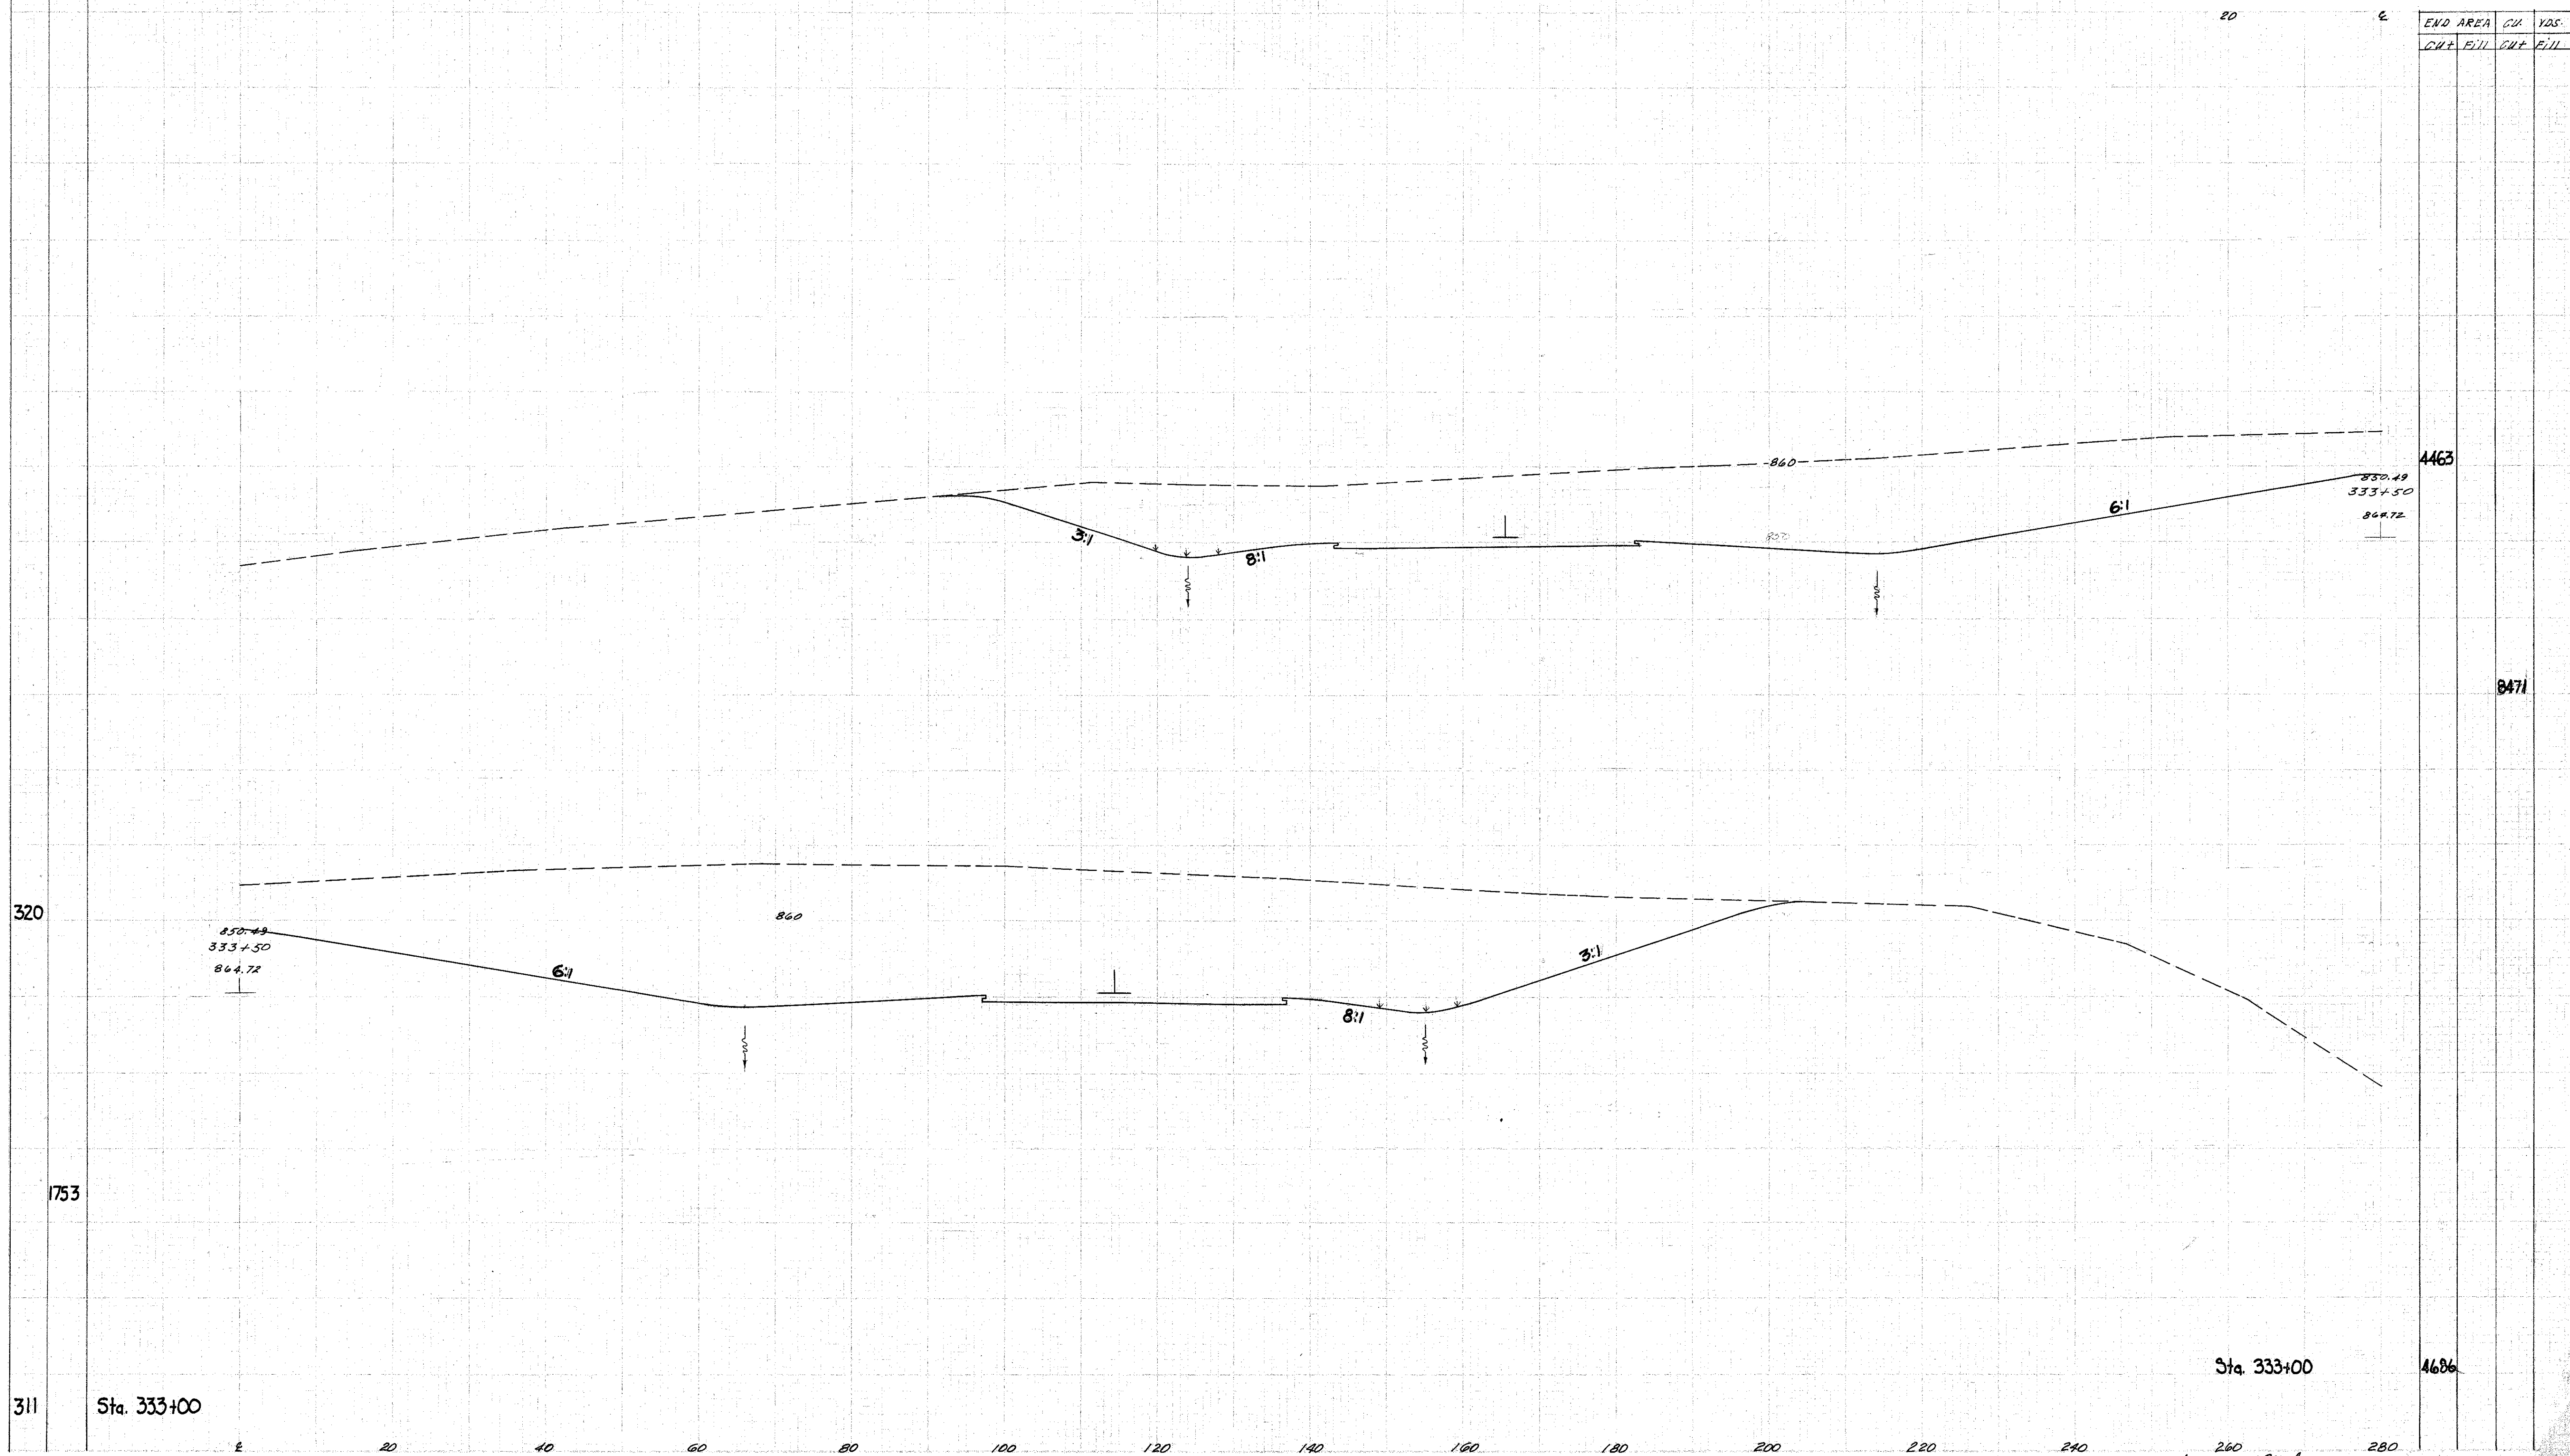

320

1753

311

Sta. 333+00

Sta. 333+00

4463

850.49
333+50
864.72

850.49
333+50
864.72

27 Oct. '58
Sta. 333+50