

SEEDING

280 260 240 220 200 180 160 140 120 100 80 60 40


END STA.

NO. PROJECT	STATE	PROJECT
2	OHIO	ACI-1103 (21)

48
488

This sheet supersedes sheet no. A.B
of the original plan.

LAKE COUNTY
LAK-1-12.89

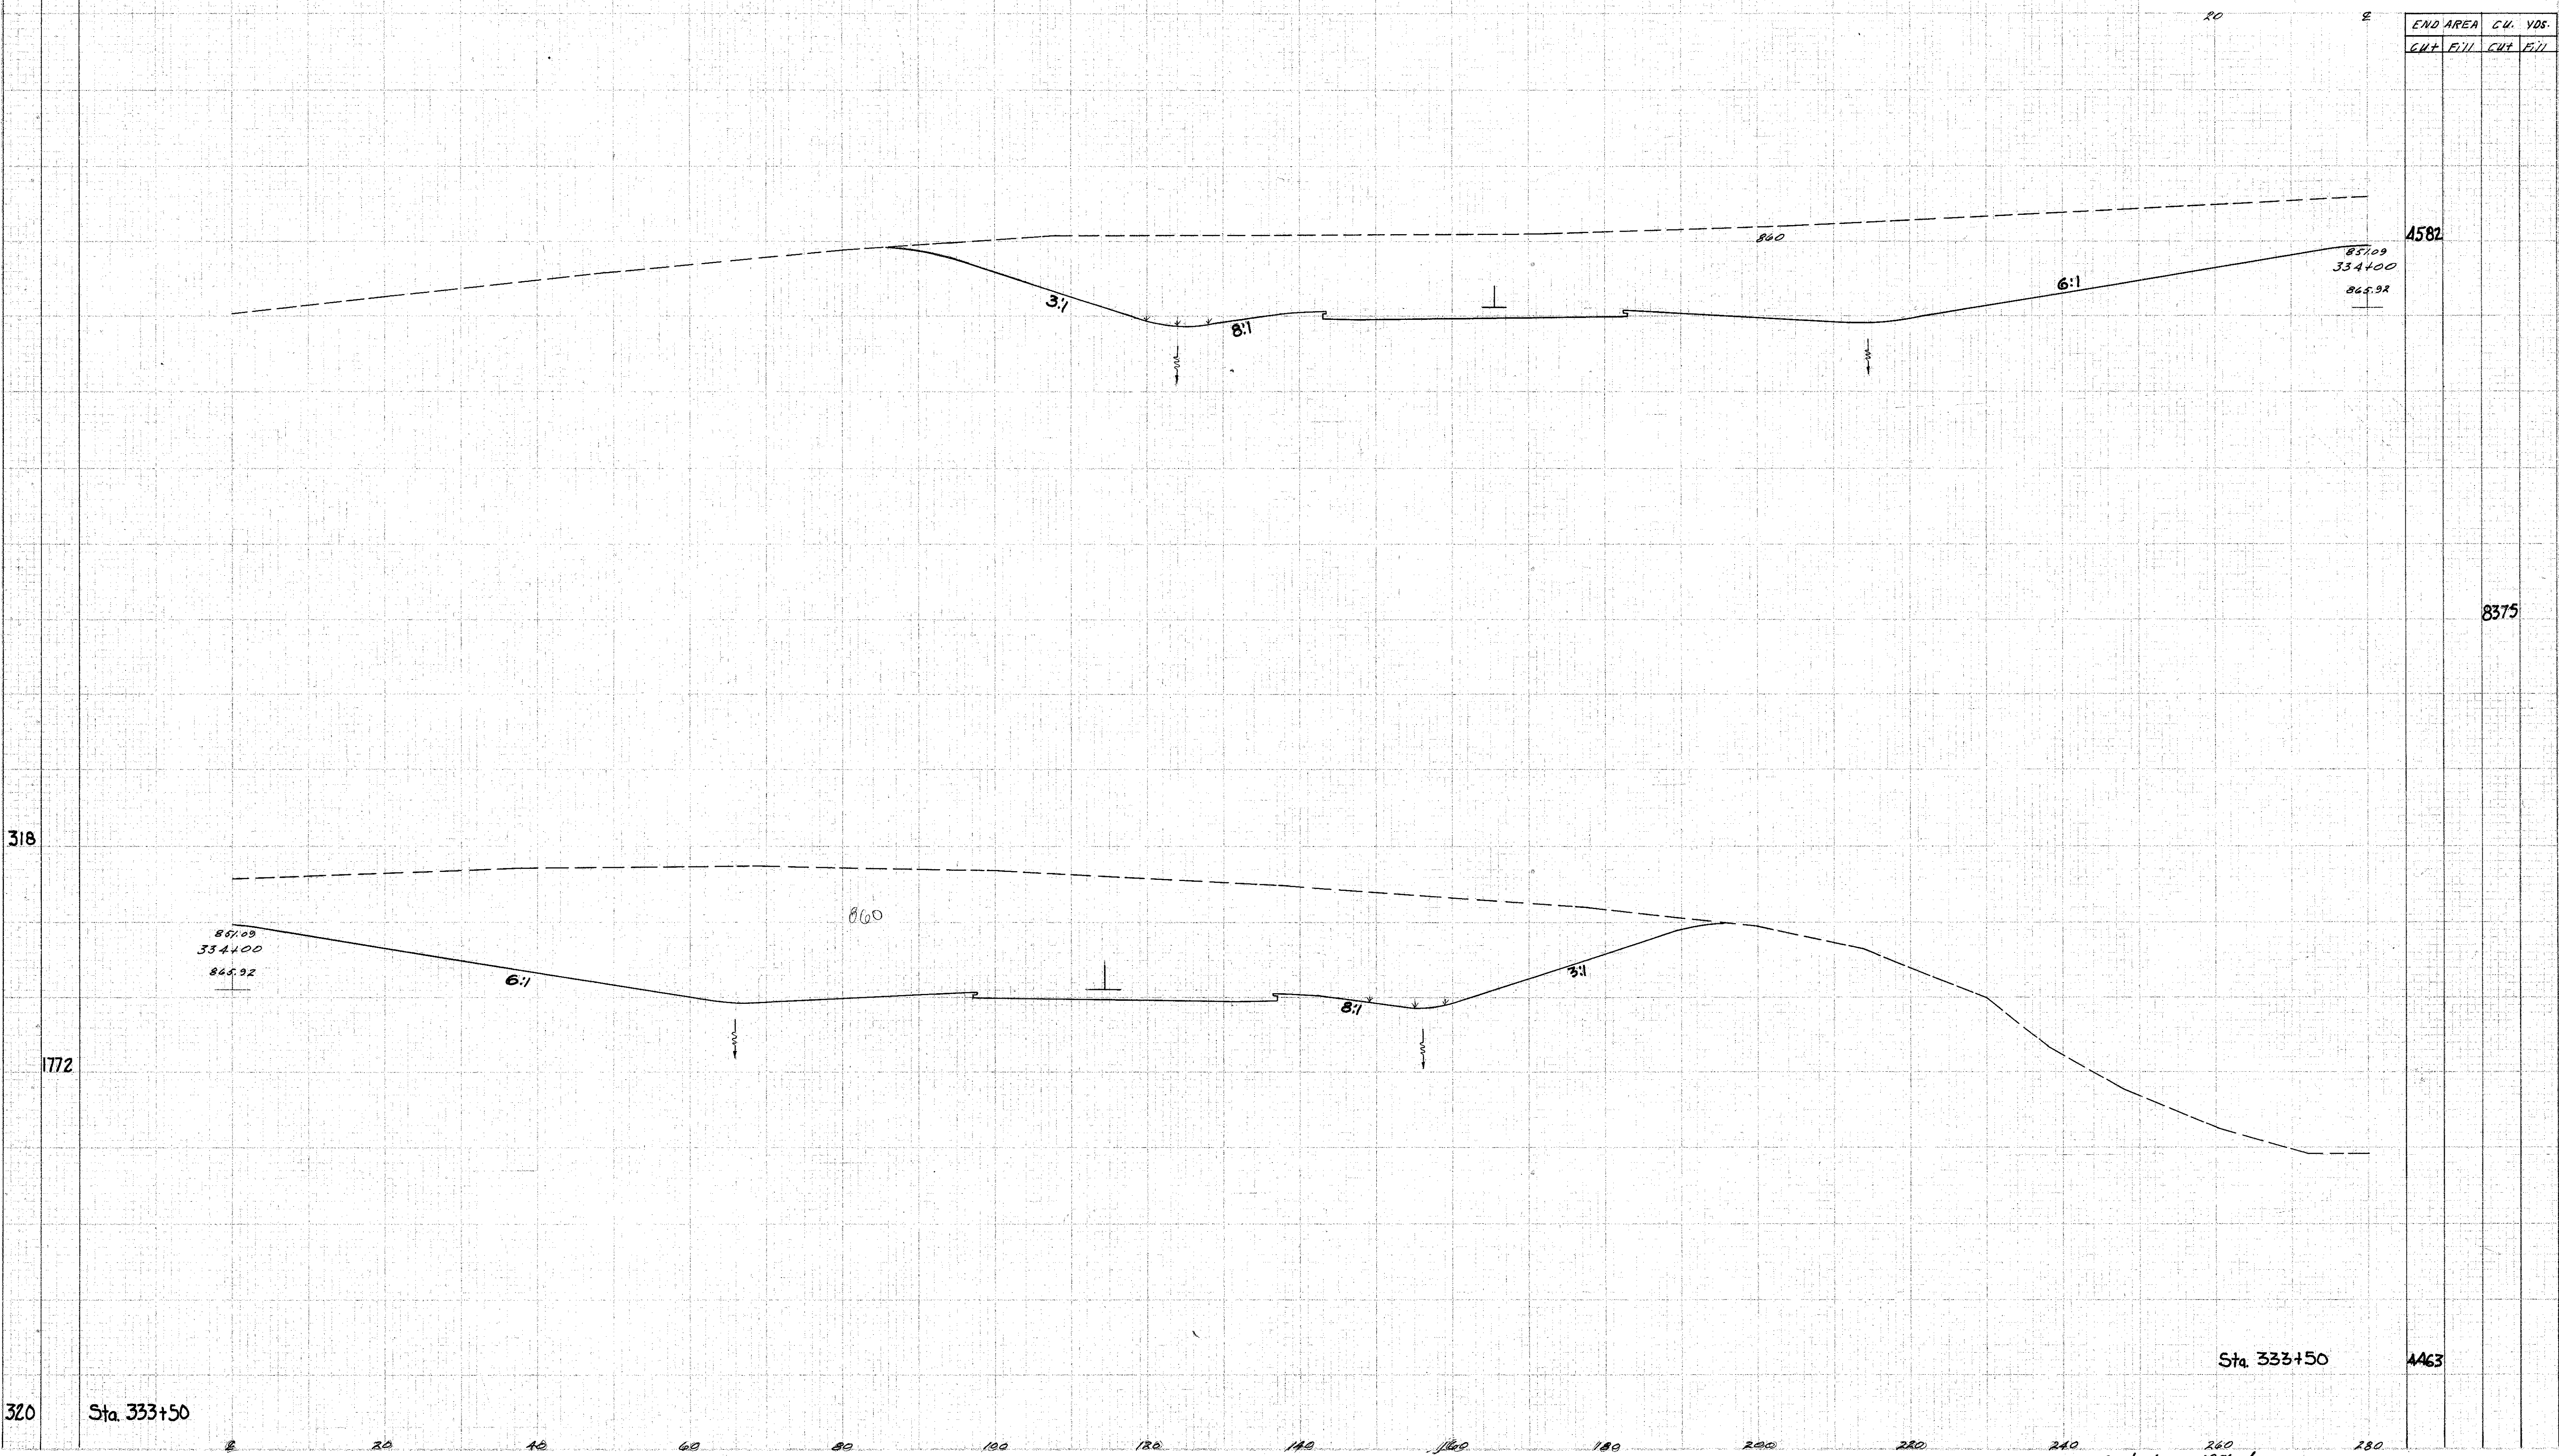

318

1772

320

Sta. 333+50

Sta. 333+50

4463

27 Oct. '58 F.M.J. Sta. 334+00