

SEEDING


280 260 240 220 200 180 160 140 120 100 80 60 40

| | | |
|----------|-------|---------------|
| REP. NO. | STATE | PROJECT |
| 2 | OHIO | ACI-1103 (21) |

53
488

This sheet supersedes sheet no. 53 of the original plan.

LAKE COUNTY
LAK-1-12.89

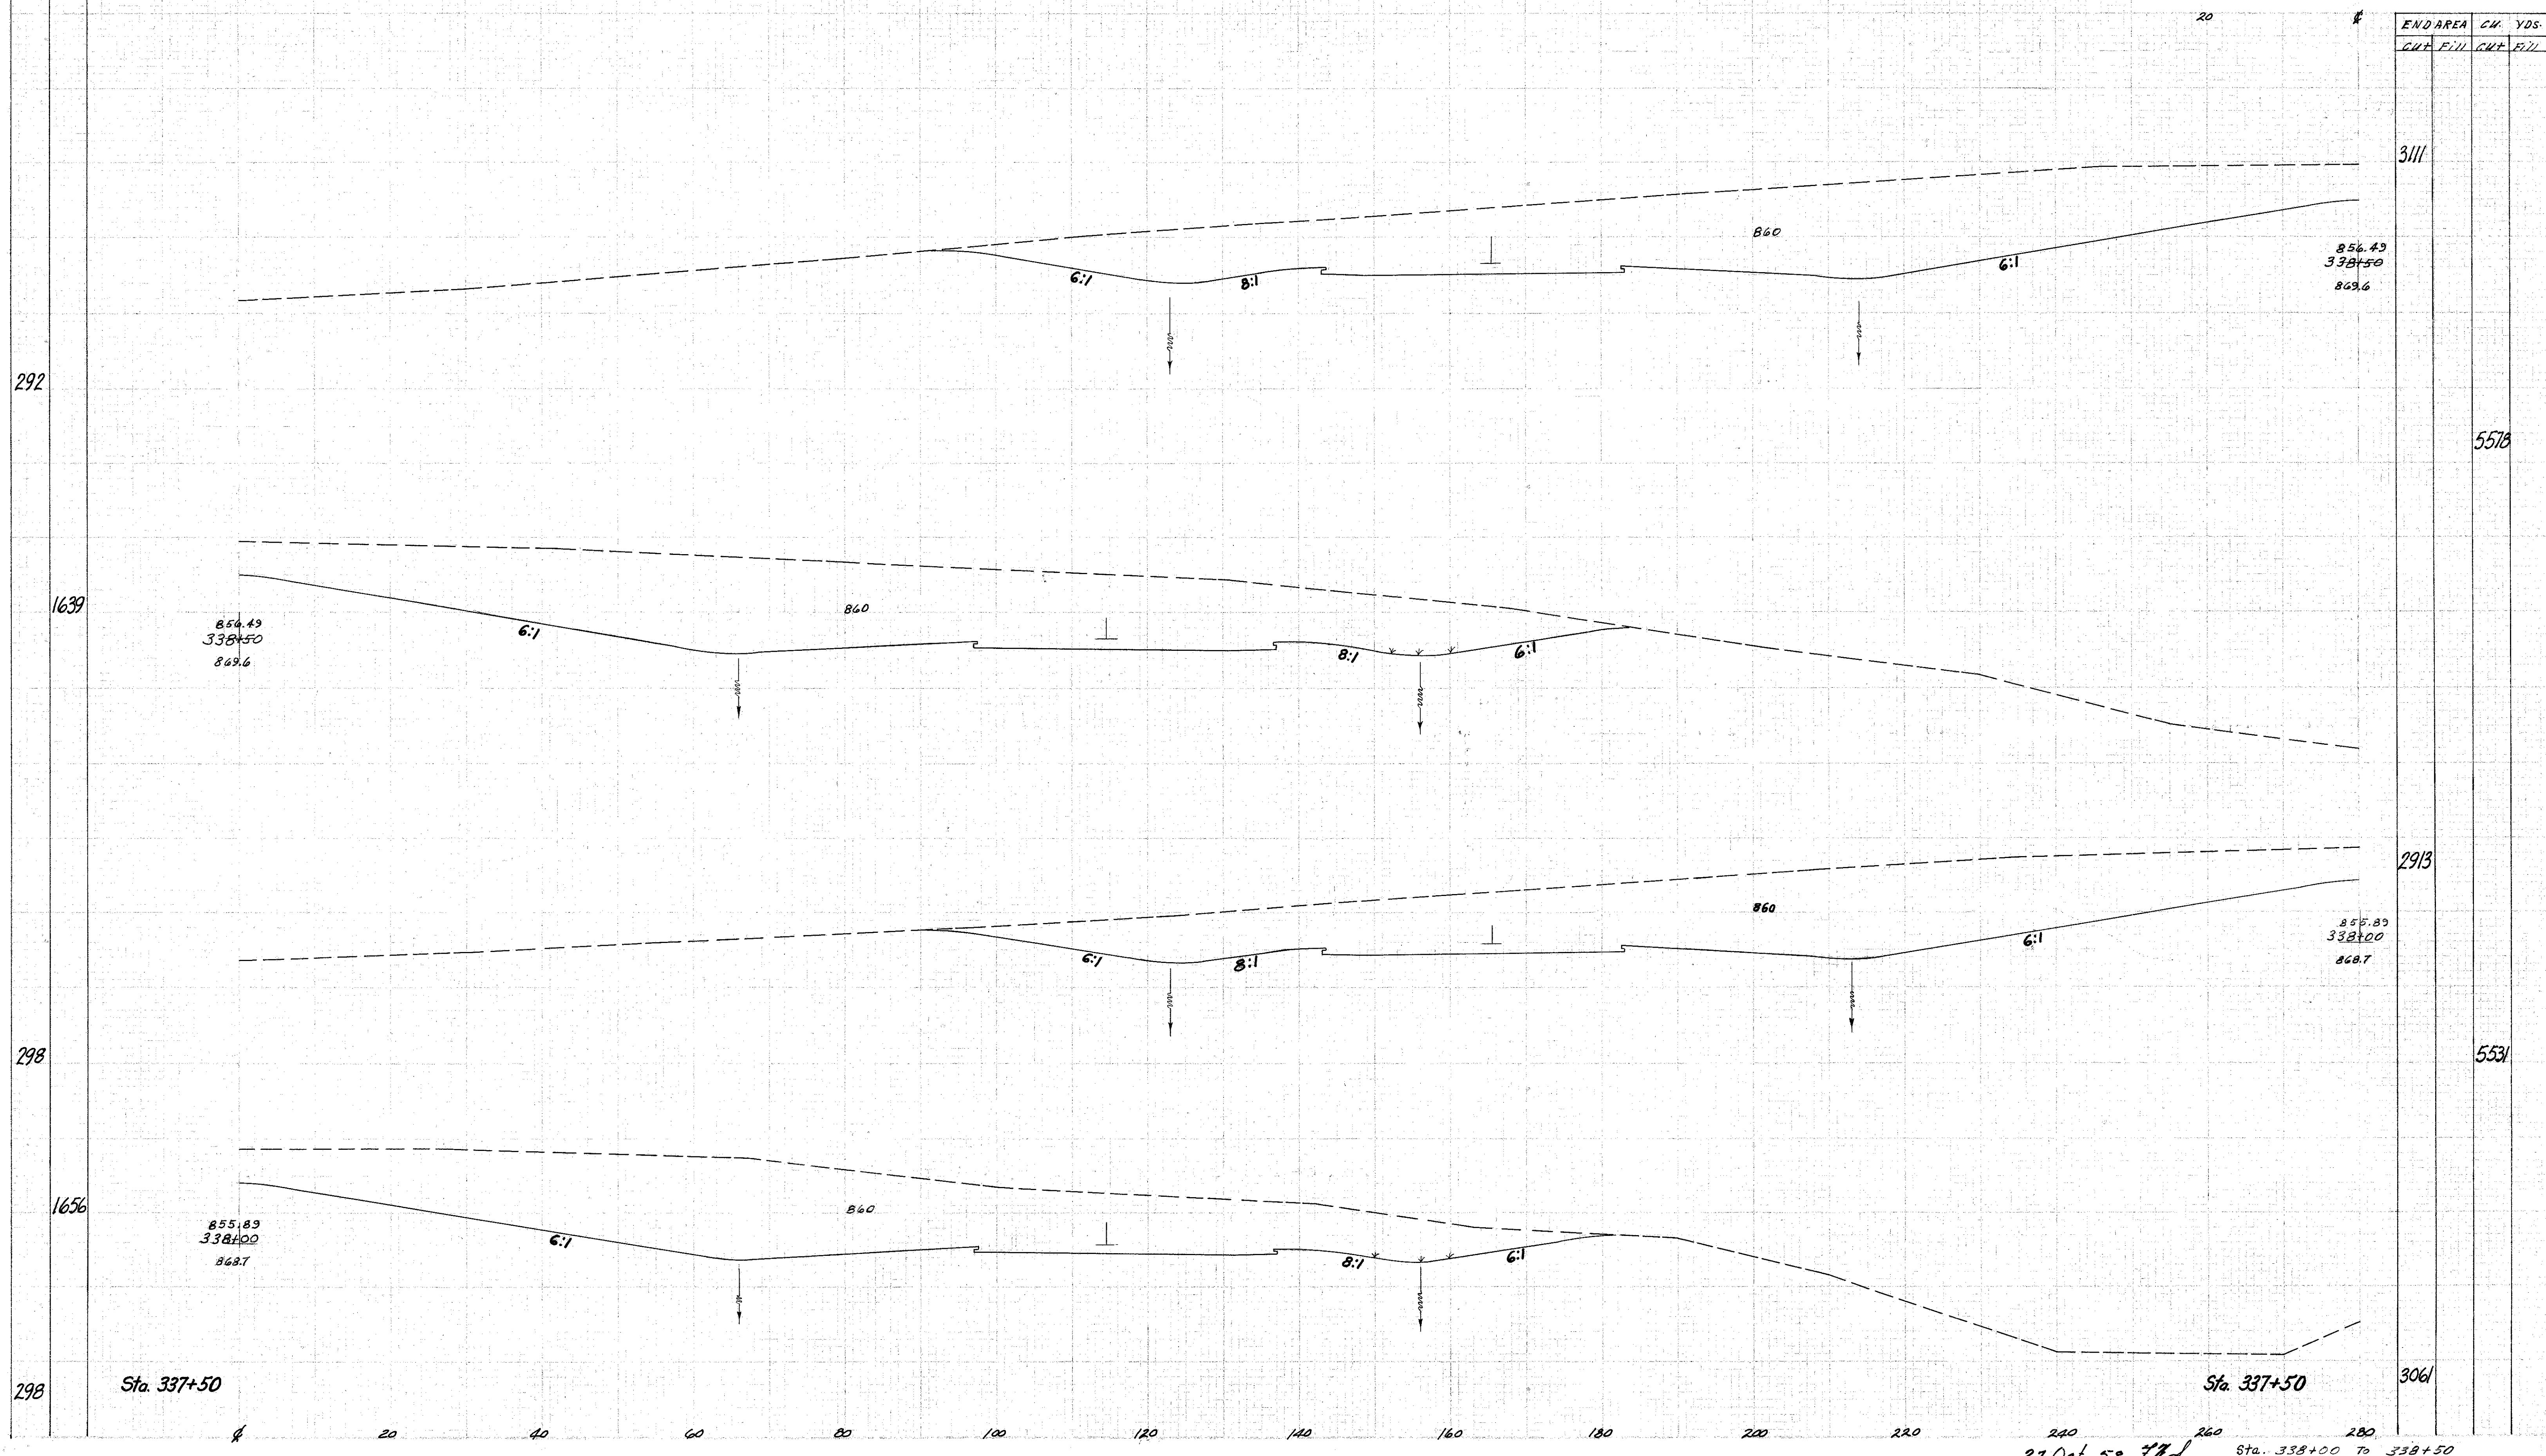

Sta. 337+50

Sta. 337+50

27 Oct. 58 *File* Sta. 338+00 To 338+50