

SEEDING


END AREA  
338

280 260 240 220 200 180 160 140 120 100 80 60 40

2	OHIO	ACI-1103 (21)	54 488
---	------	---------------	-----------

This sheet supersedes sheet no. 54 of the original plan.

LAKE COUNTY  
LAK - 1 - 12.89

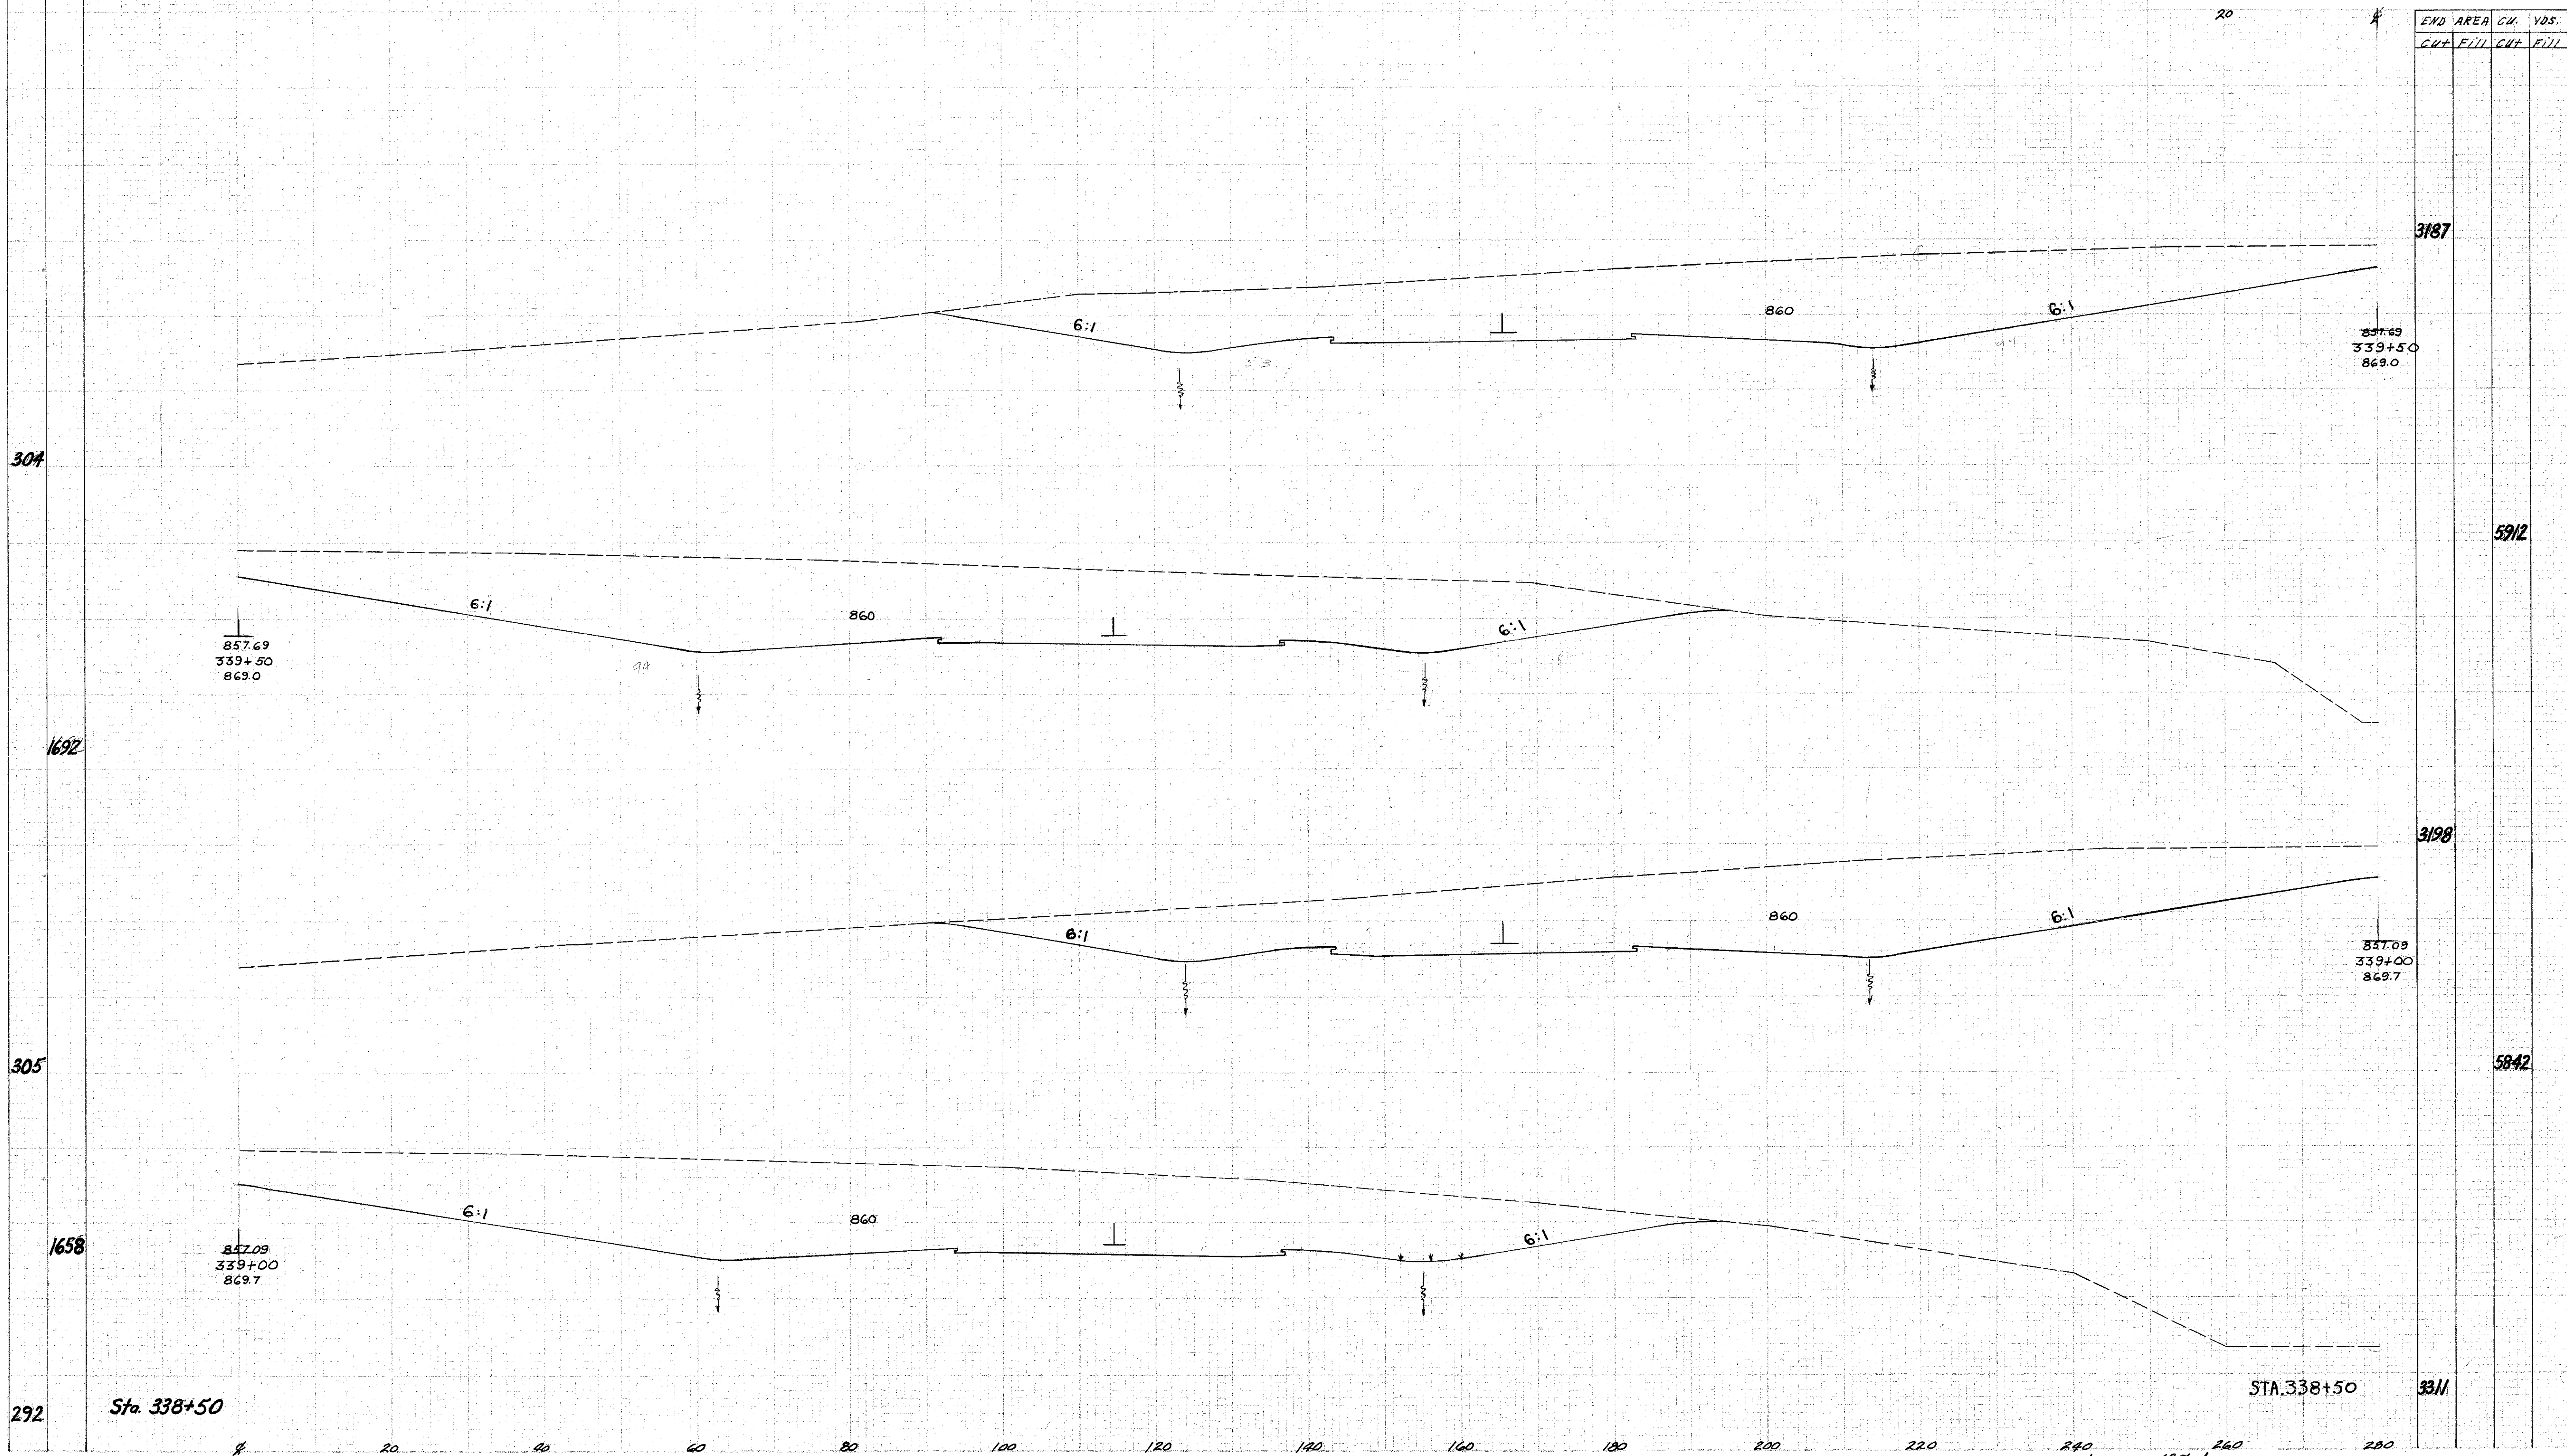

Sta. 338+50

Sta. 338+50

3311

27 Oct. '58 *F.M.d.* Sta. 339+00 to 339+50