


SEEDING  
FOOTING

280 260 240 220 200 180 160 140 120 100 80 60 40

DES. NO.	STATE	PROJECT	55 488
2	OHIO	ACI-1103 (21)	

This sheet supersedes sheet no. 55 of the original plan.

LAKE COUNTY  
LAK-1-12.89

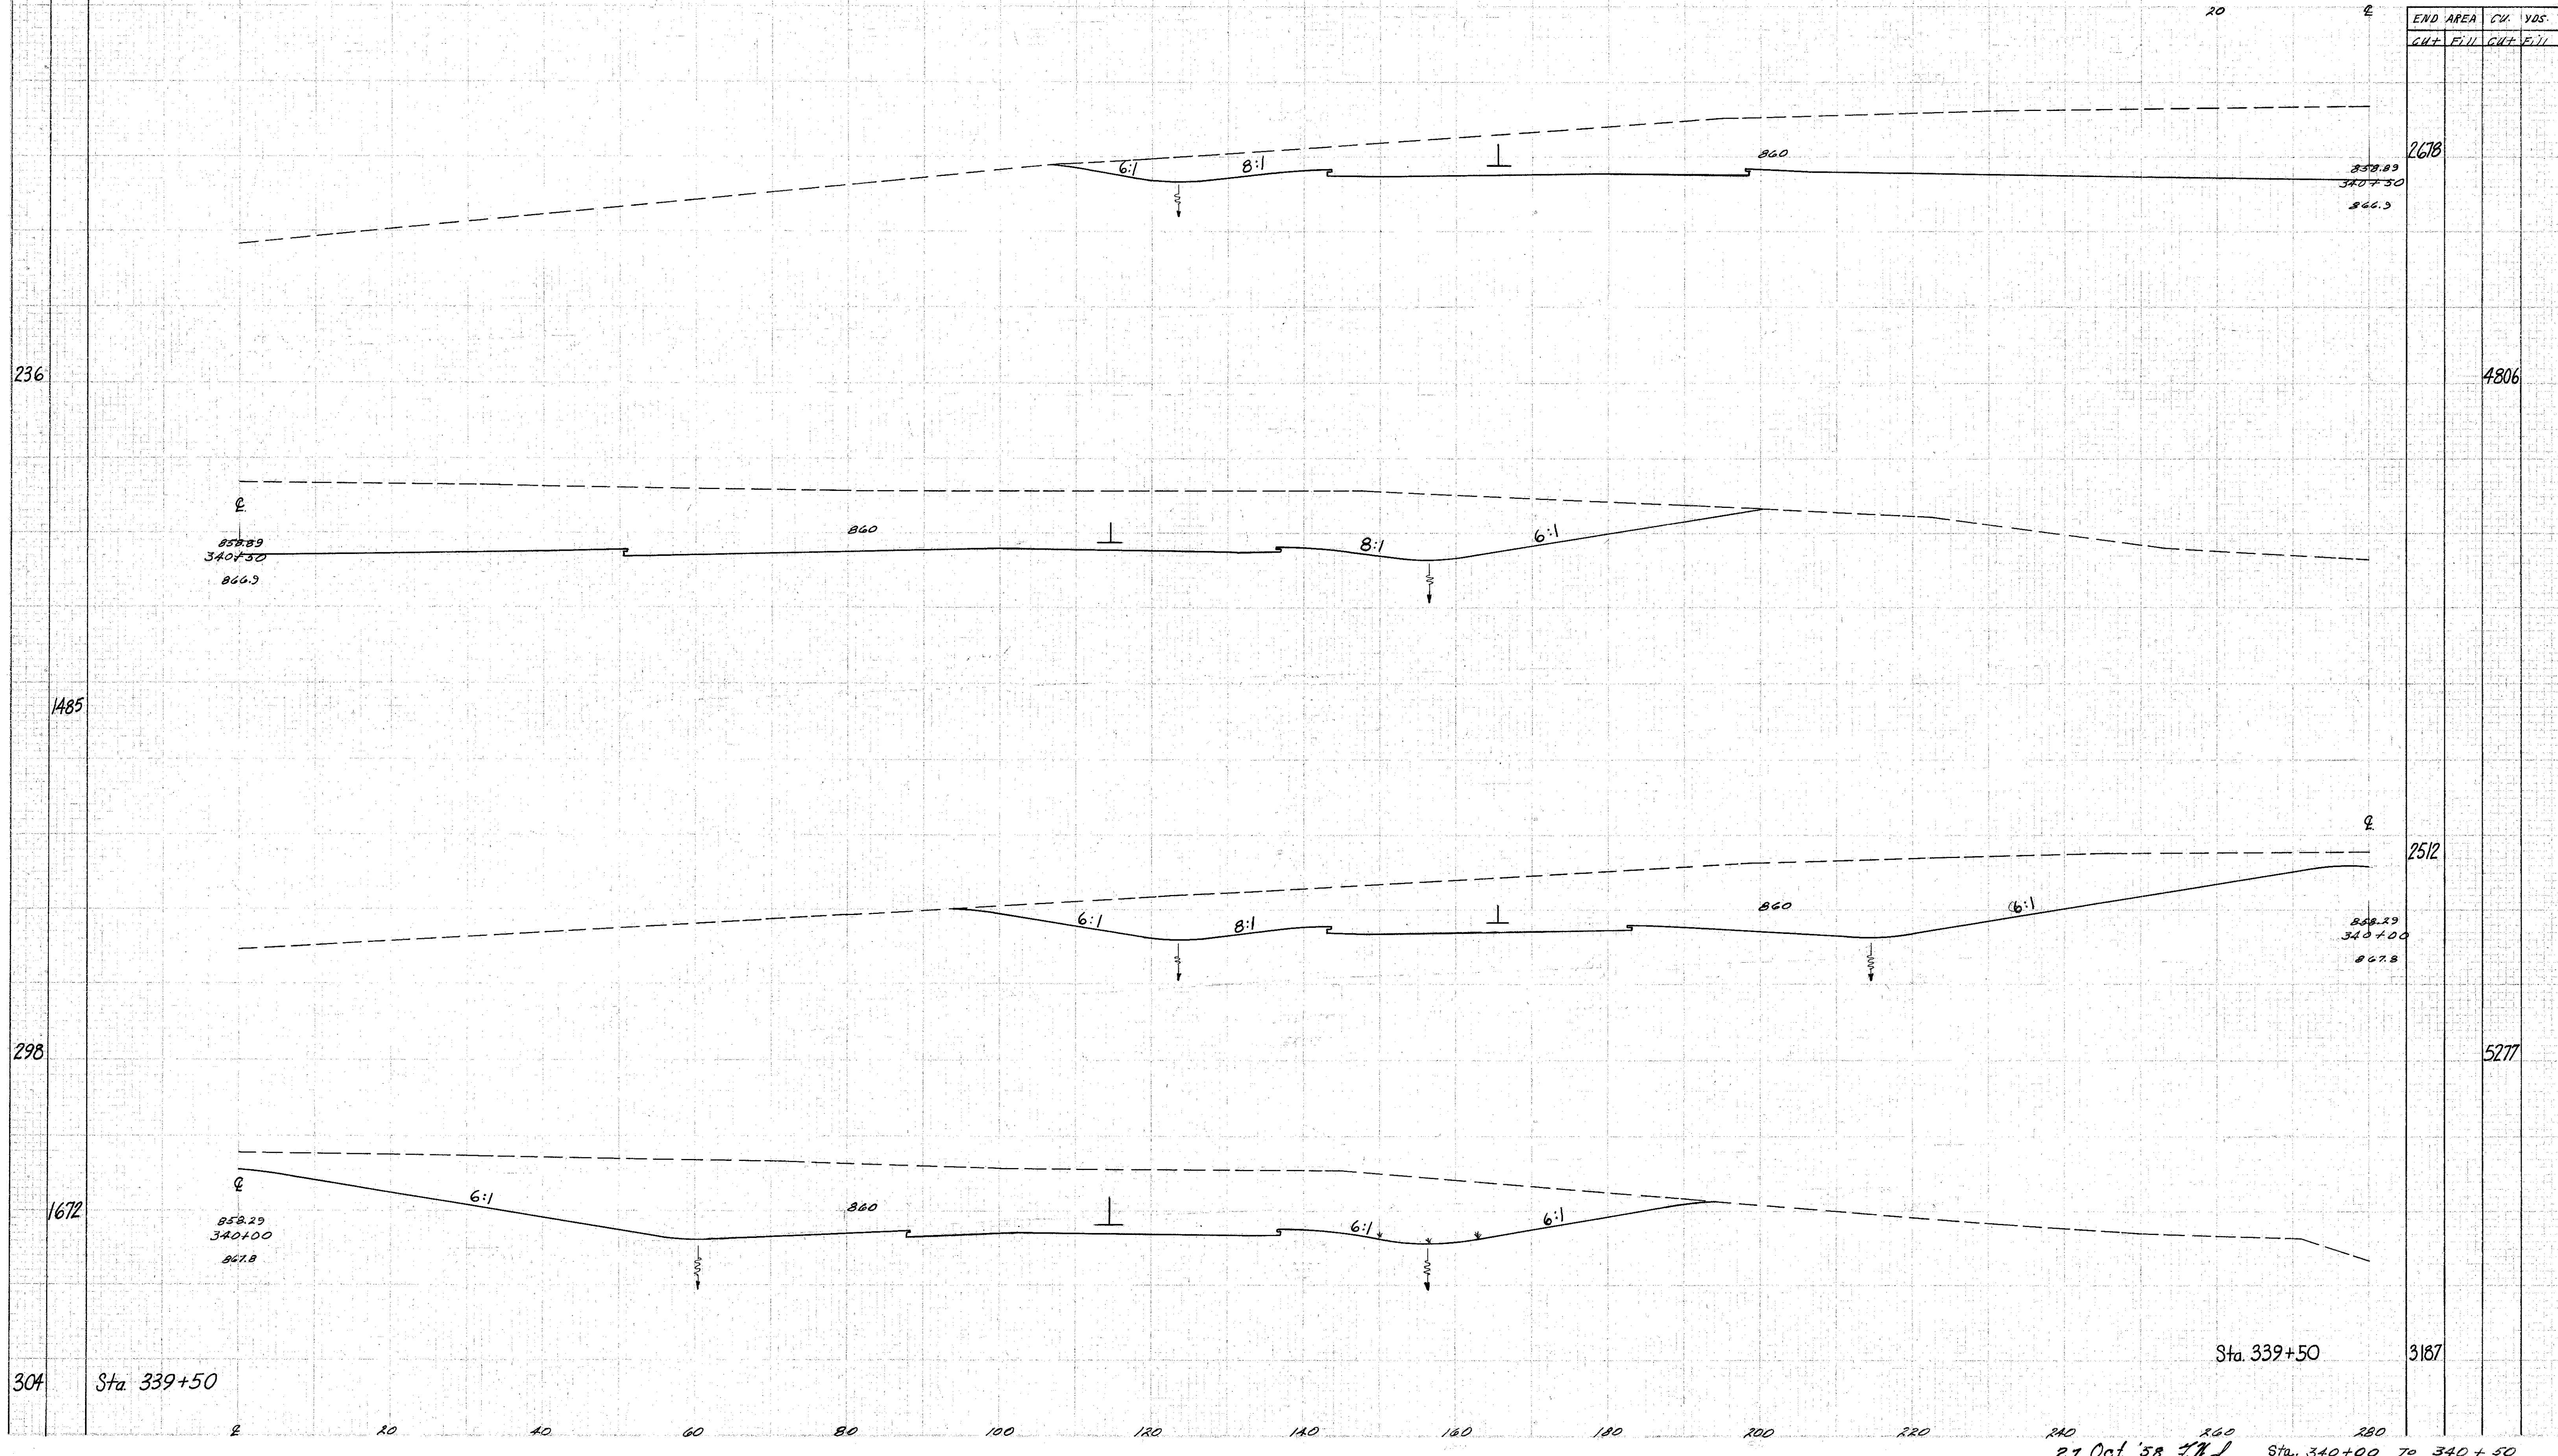

END AREA	CU. YDS.	
	CUT	FILL
2678		
4806		
2512		
5277		
3187		

304 Sta 339+50

Sta. 339+50

27 Oct '58 F.H. Sta. 340+00 to 340+50