SEEDING	
END WIDTH	SQ. YDS.
296	
1603	
281	
1434	
236	

This sheet supersedes sheet no. 56 of the original plan.

PER SO. DIVISION	STATE	PROJECT	
2	OHIO	ACI-1103(21)	

56
488

LAKE COUNTY
LAK-1-12.89

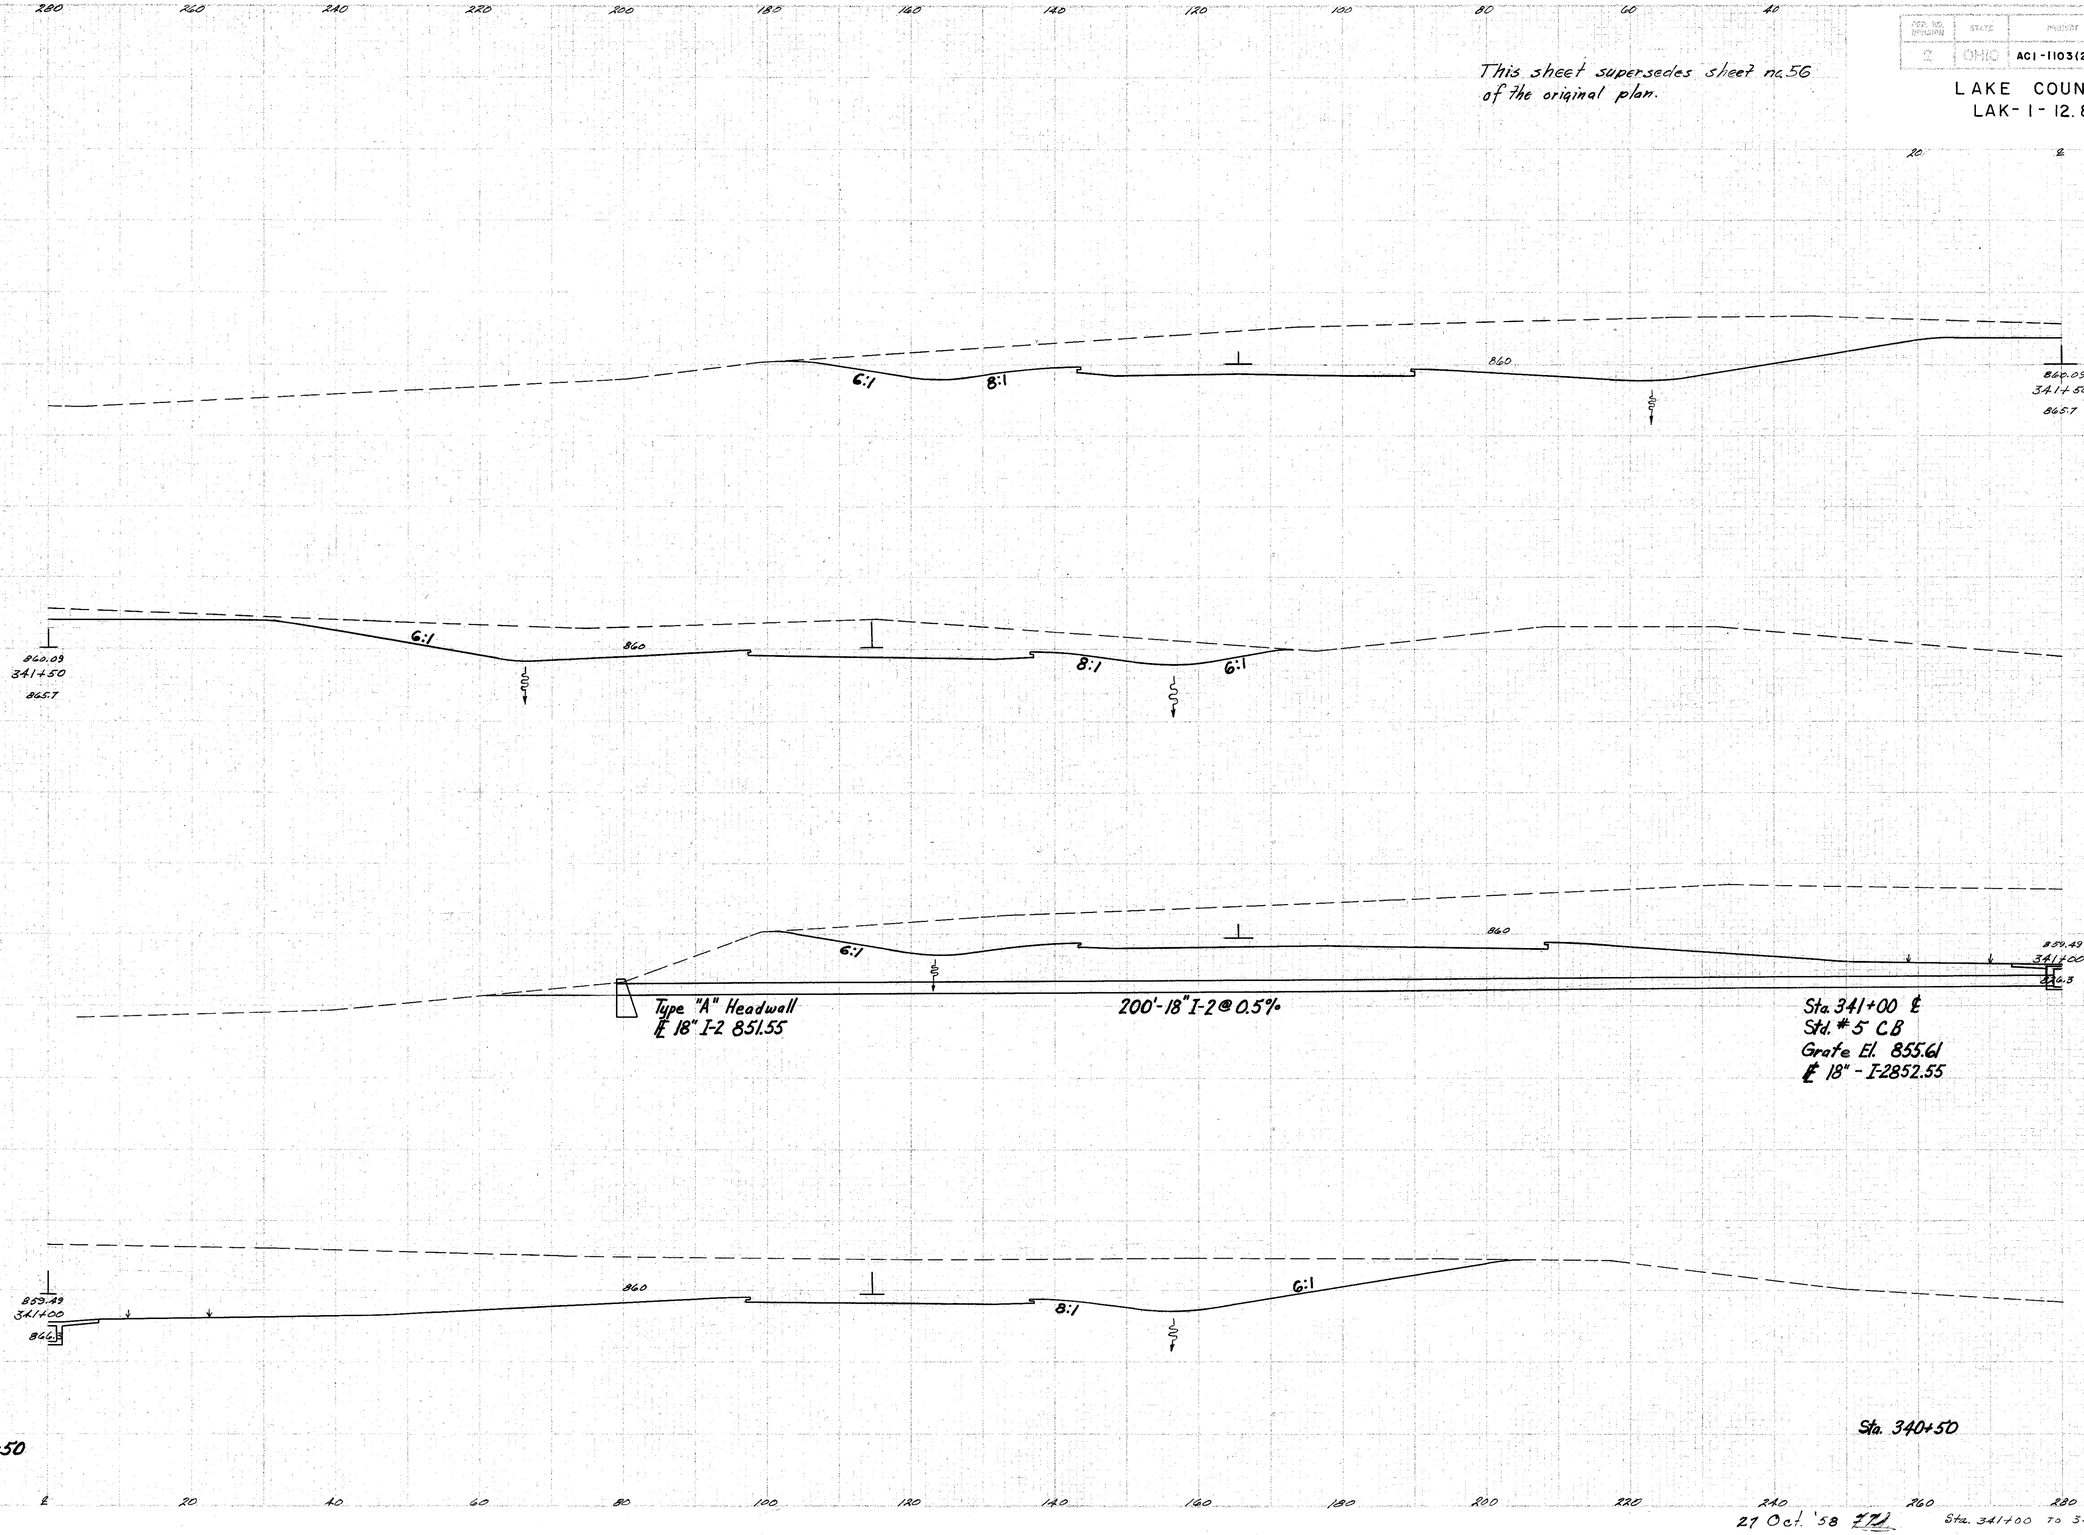

END AREA		CU. YDS.	
CUT	FILL	CUT	FILL
1442			
		3746	
2604			
		4891	
2678			

27 Oct. '58 ZJ

Sta. 341+00 TO 341+50