

SEEDING 280 260 240 220 200 180 160 140 120 100 80 60 40


END WIDTH YDS.

REV. NO.	STATE	PROJECT
2	OHIO	ACI-1103(21)

59  
488

This sheet supersedes sheet no. 59 of the original plan.

LAKE COUNTY  
LAK-1 - 12.89

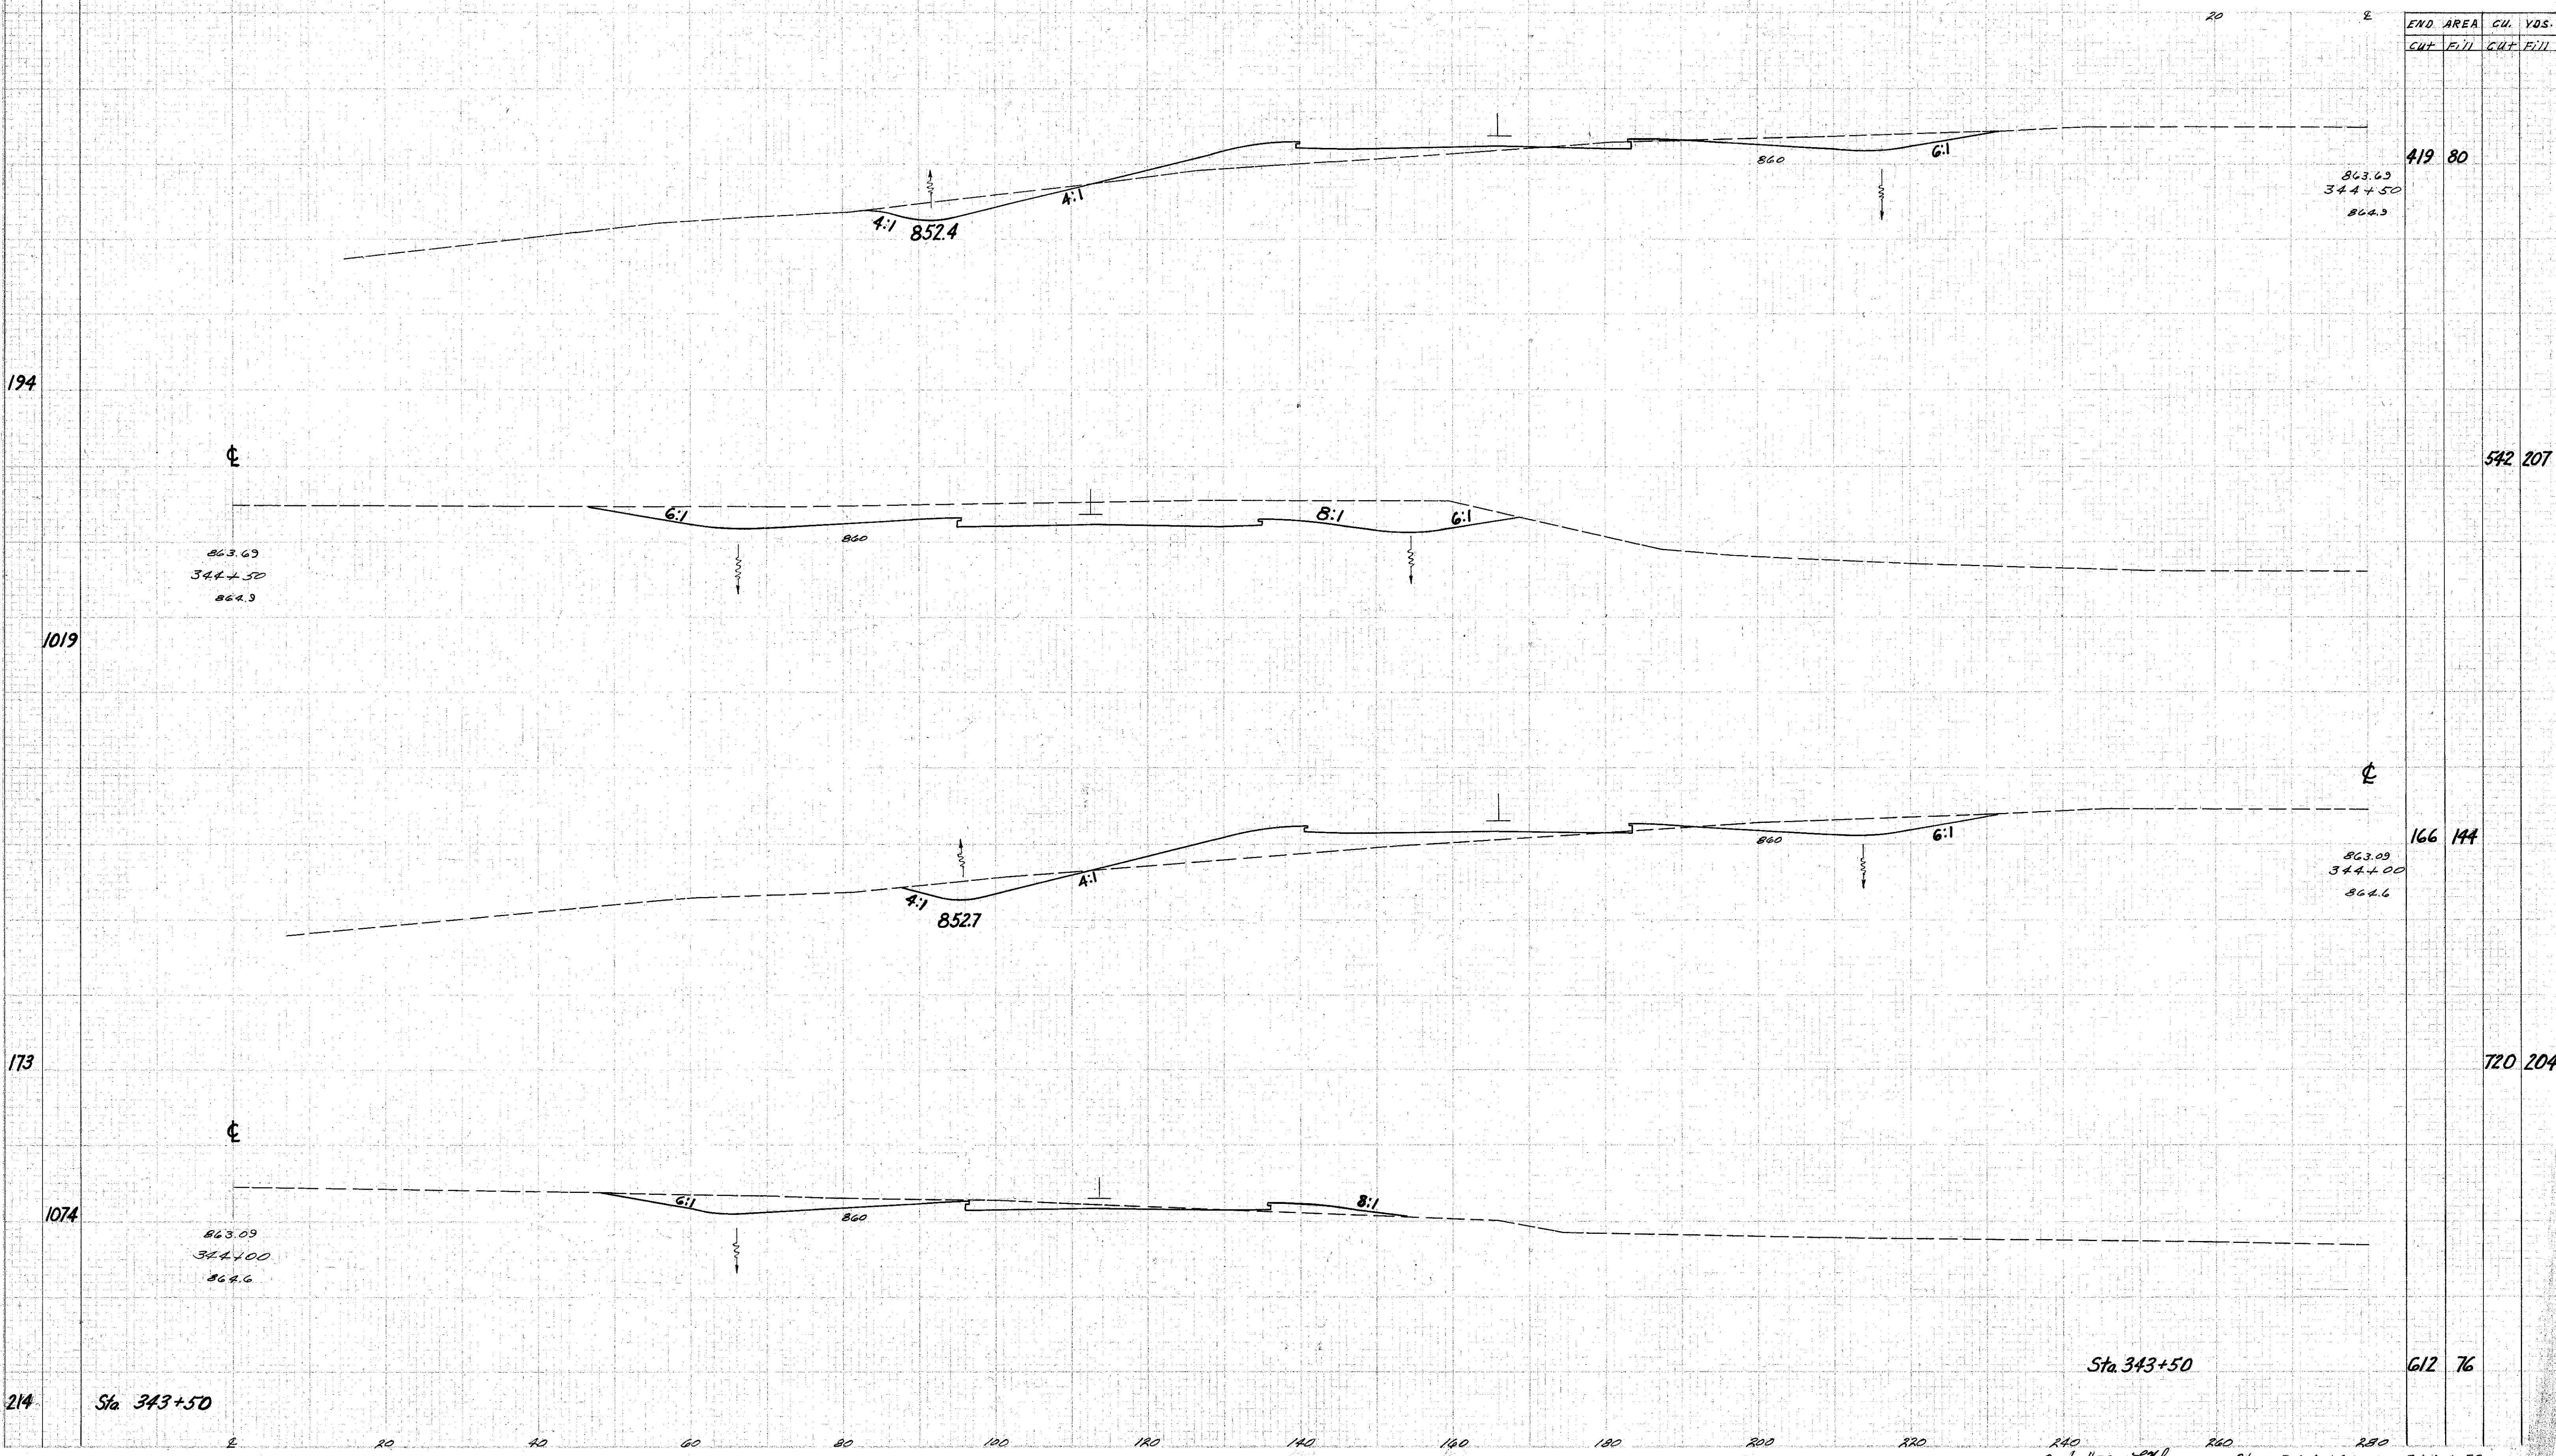

214 Sta 343+50

Sta 343+50

27 Oct. '58 *[Signature]* Sta. 344+00 to 344+50