


SEEDING
EXB. SQ.
WIDTH YDS.

SECTION	STATE	PROJECT	
2	OHIO	ACI-1103 (21)	

60
488

This sheet supersedes sheet no. 60
of the original plan.

LAKE COUNTY
LAK-1-12.89

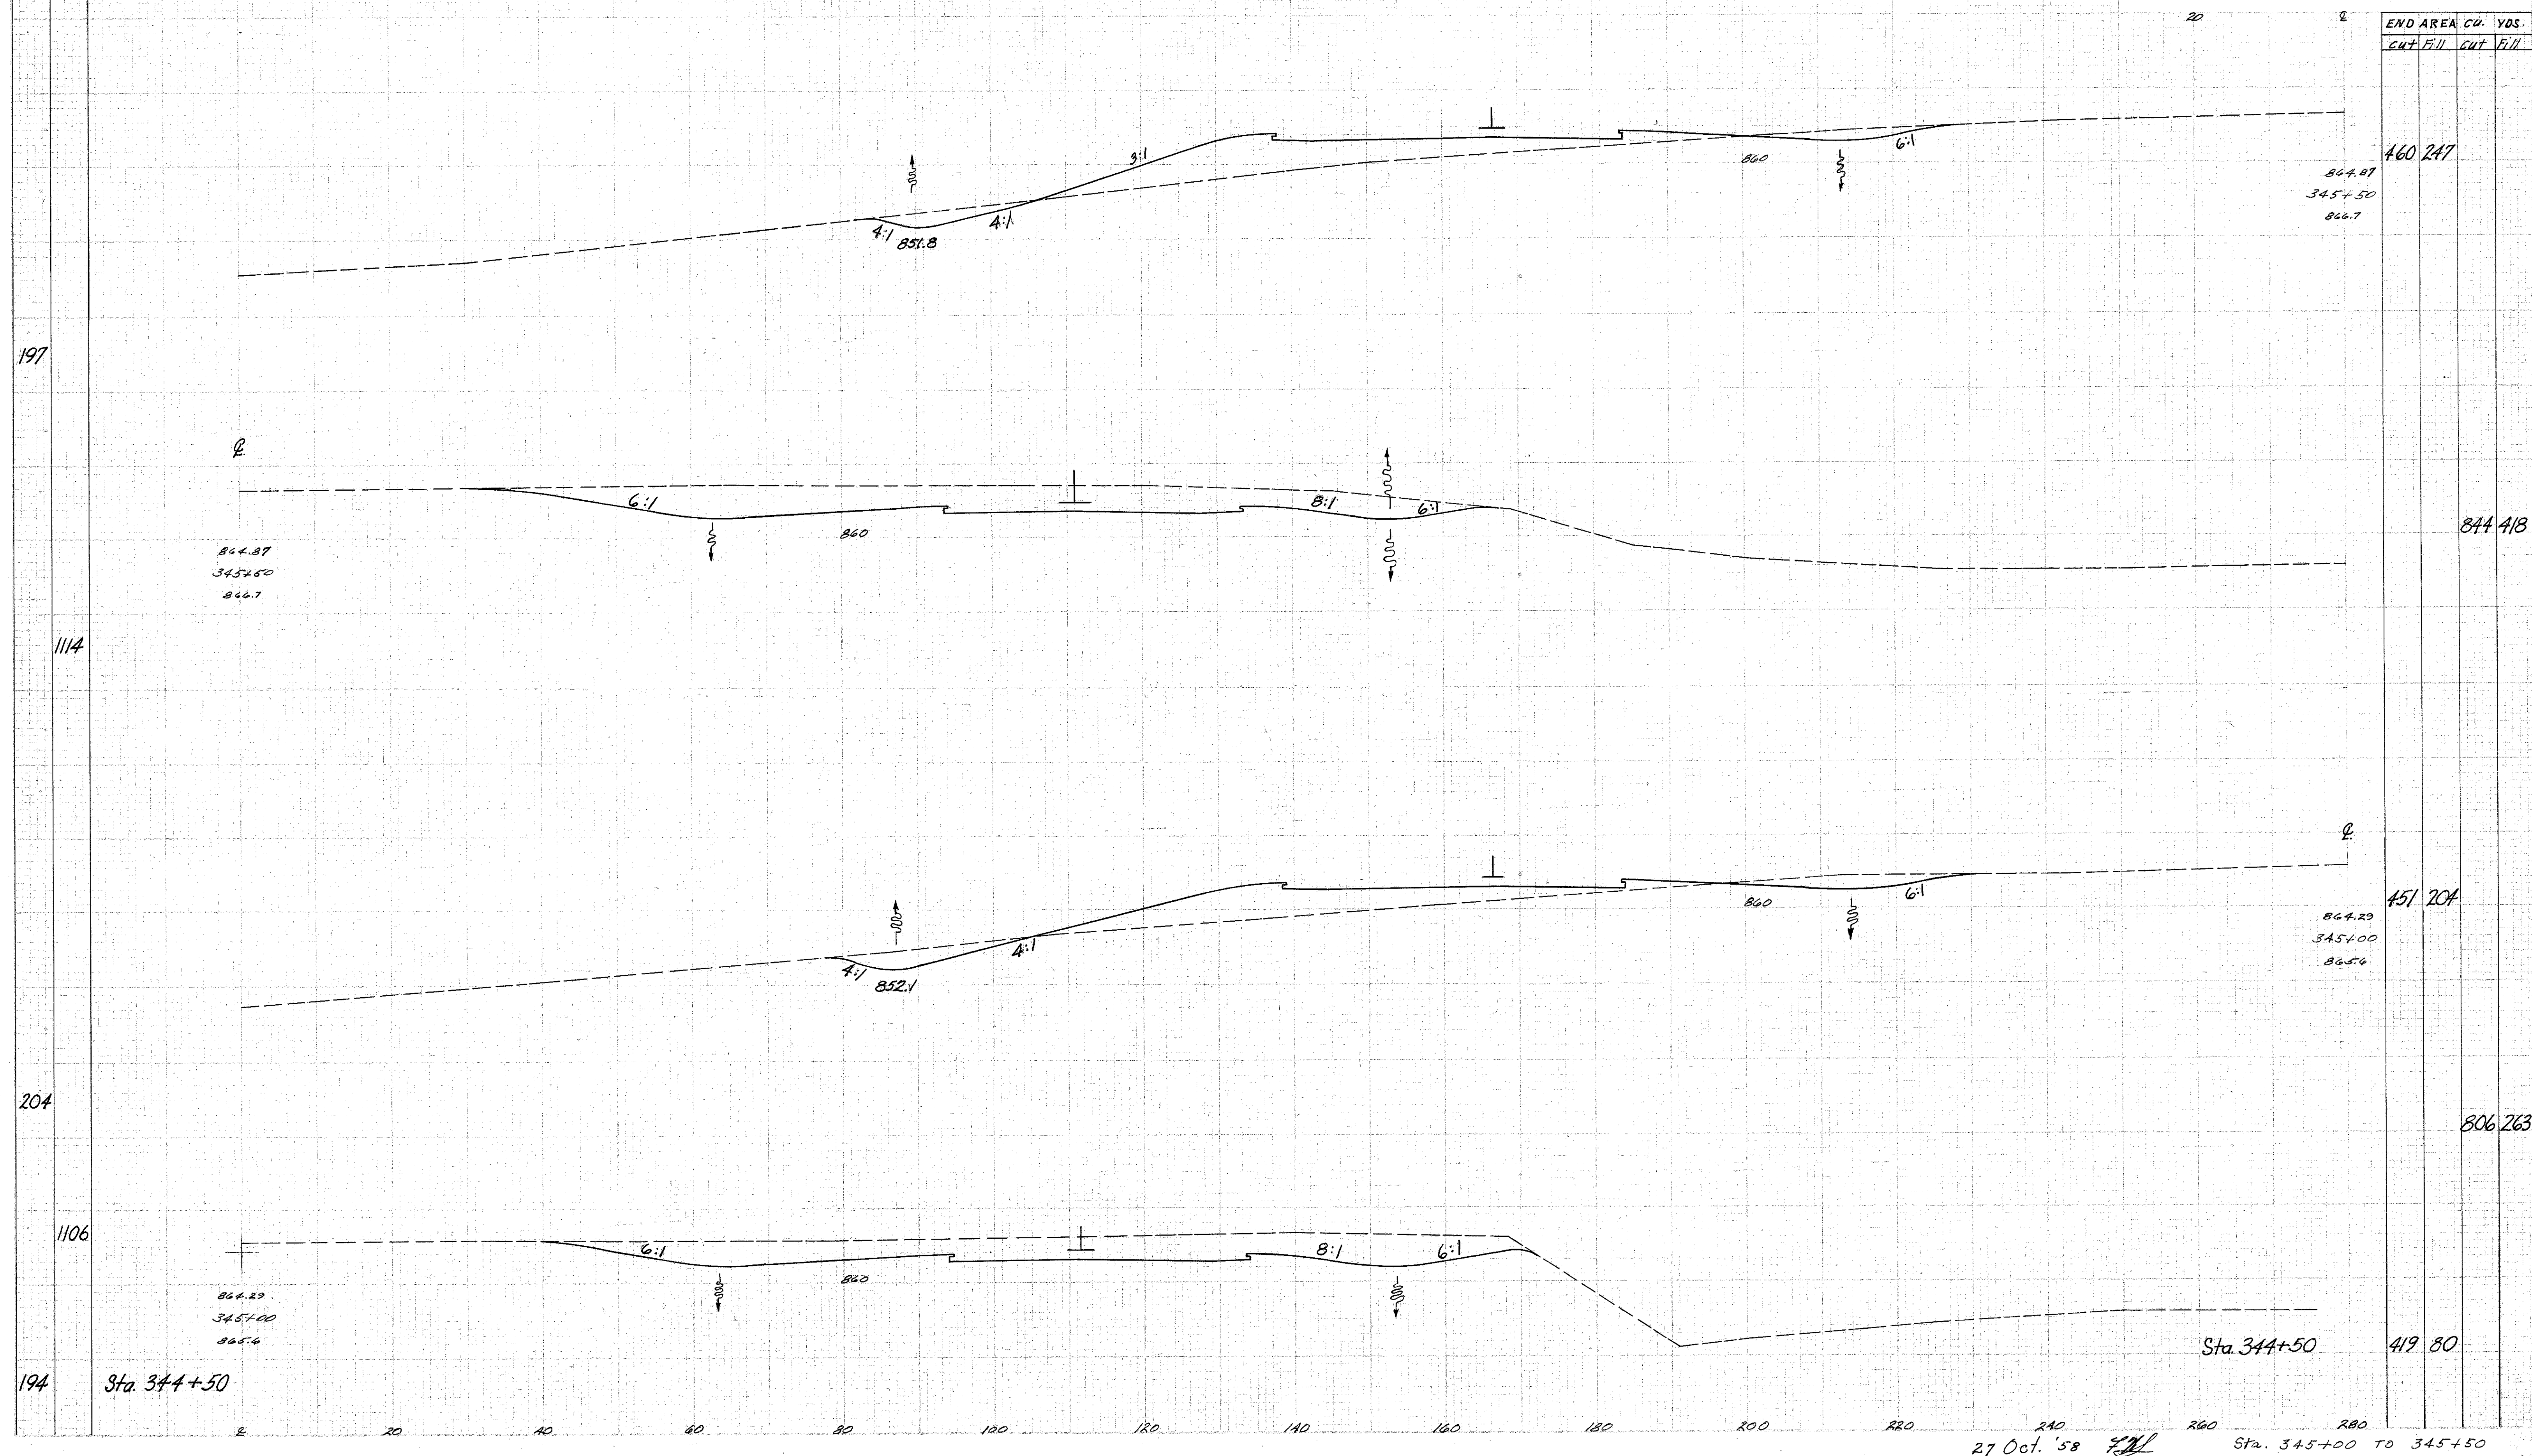

END AREA		CU. YDS.	
CUT	FILL	CUT	FILL

460 247
864.87
345+50
866.7

844 418

451 207
864.29
345+00
865.6

806 263

419 80