


SEEDING
END SQ
WIDTH YDS.

2	OHIO	ACI-1103 (21)
---	------	---------------

61
488

This sheet supersedes sheet no. G1
of the original plan.

LAKE COUNTY
LAK-1-12.89

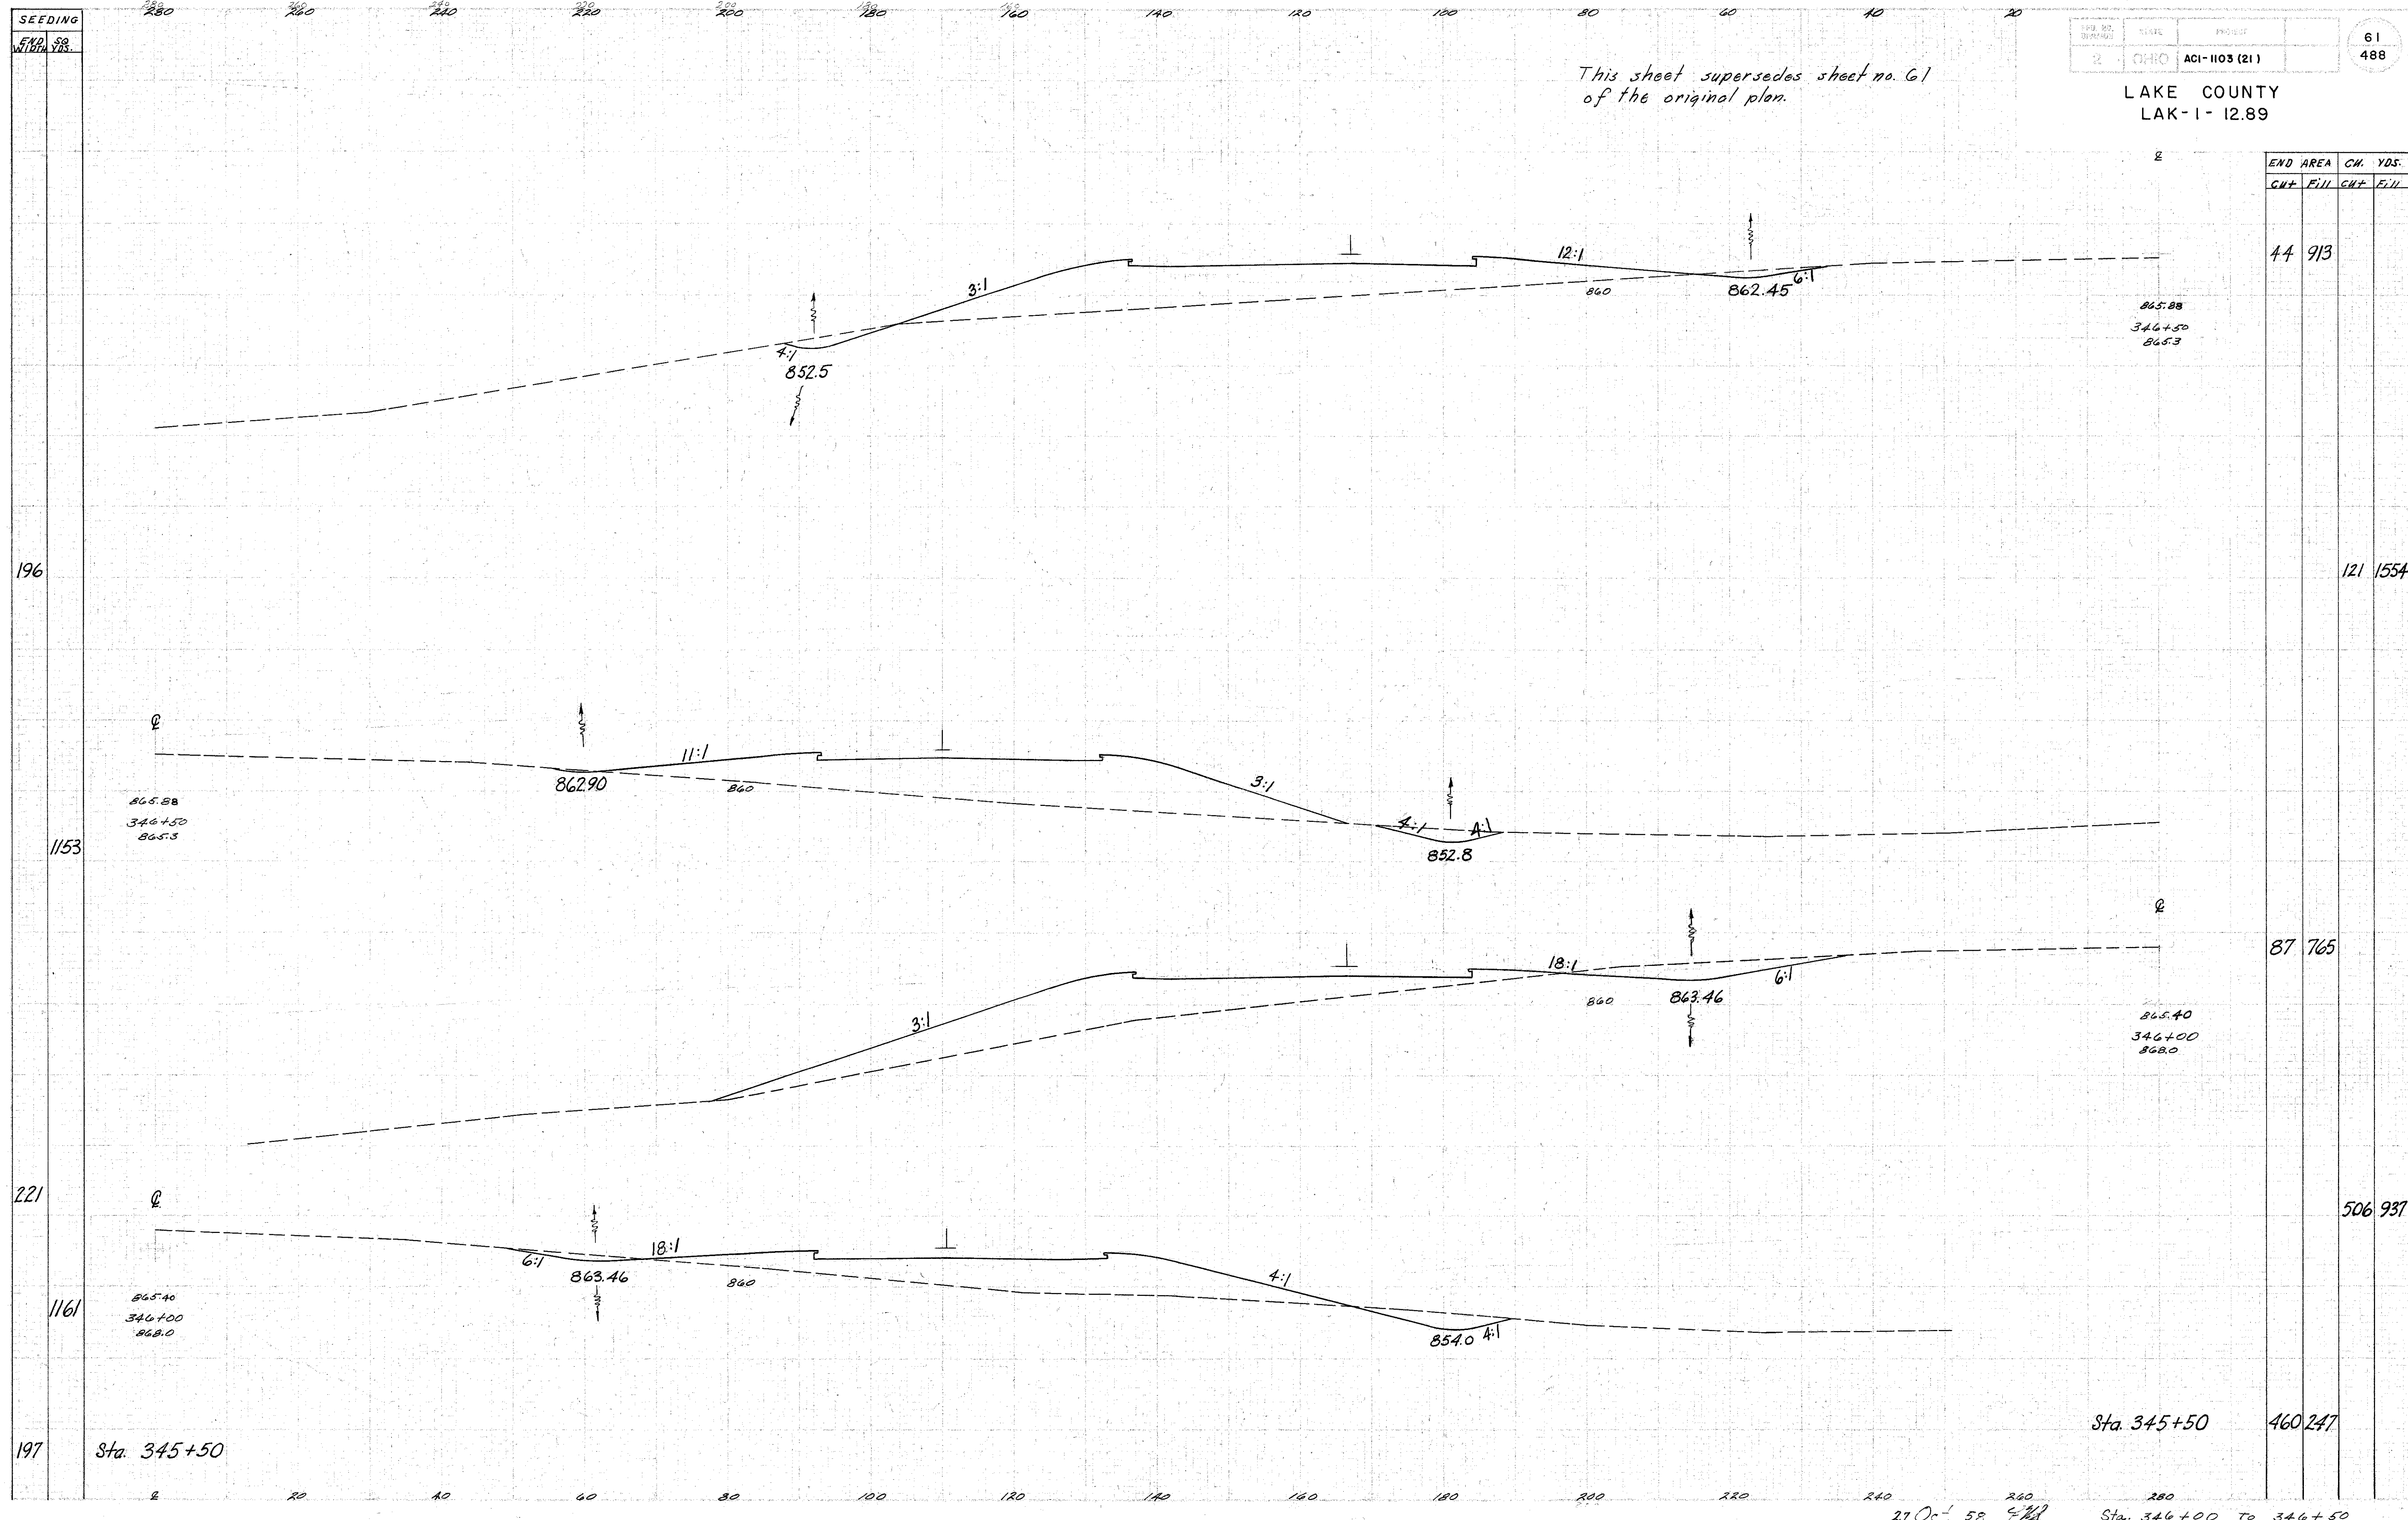

END AREA	CW.	YDS.	
CUT	FILL	CUT	FILL

44 913

121 1554

87 765

506 937

Sta. 345+50 460 247

27 Oct 58

Sta. 346+00 TO 346+50