


SEEDING 280 260 240 220 200 180 160 140 120 100 80 60 40

END WIDTH SA PER 100' END AREA CU. YDS.

2	OHIO	ACI-1103 (21)	65
			488

This sheet supersedes sheet no. 65 of the original plan.

LAKE COUNTY
LAK-1-12.89

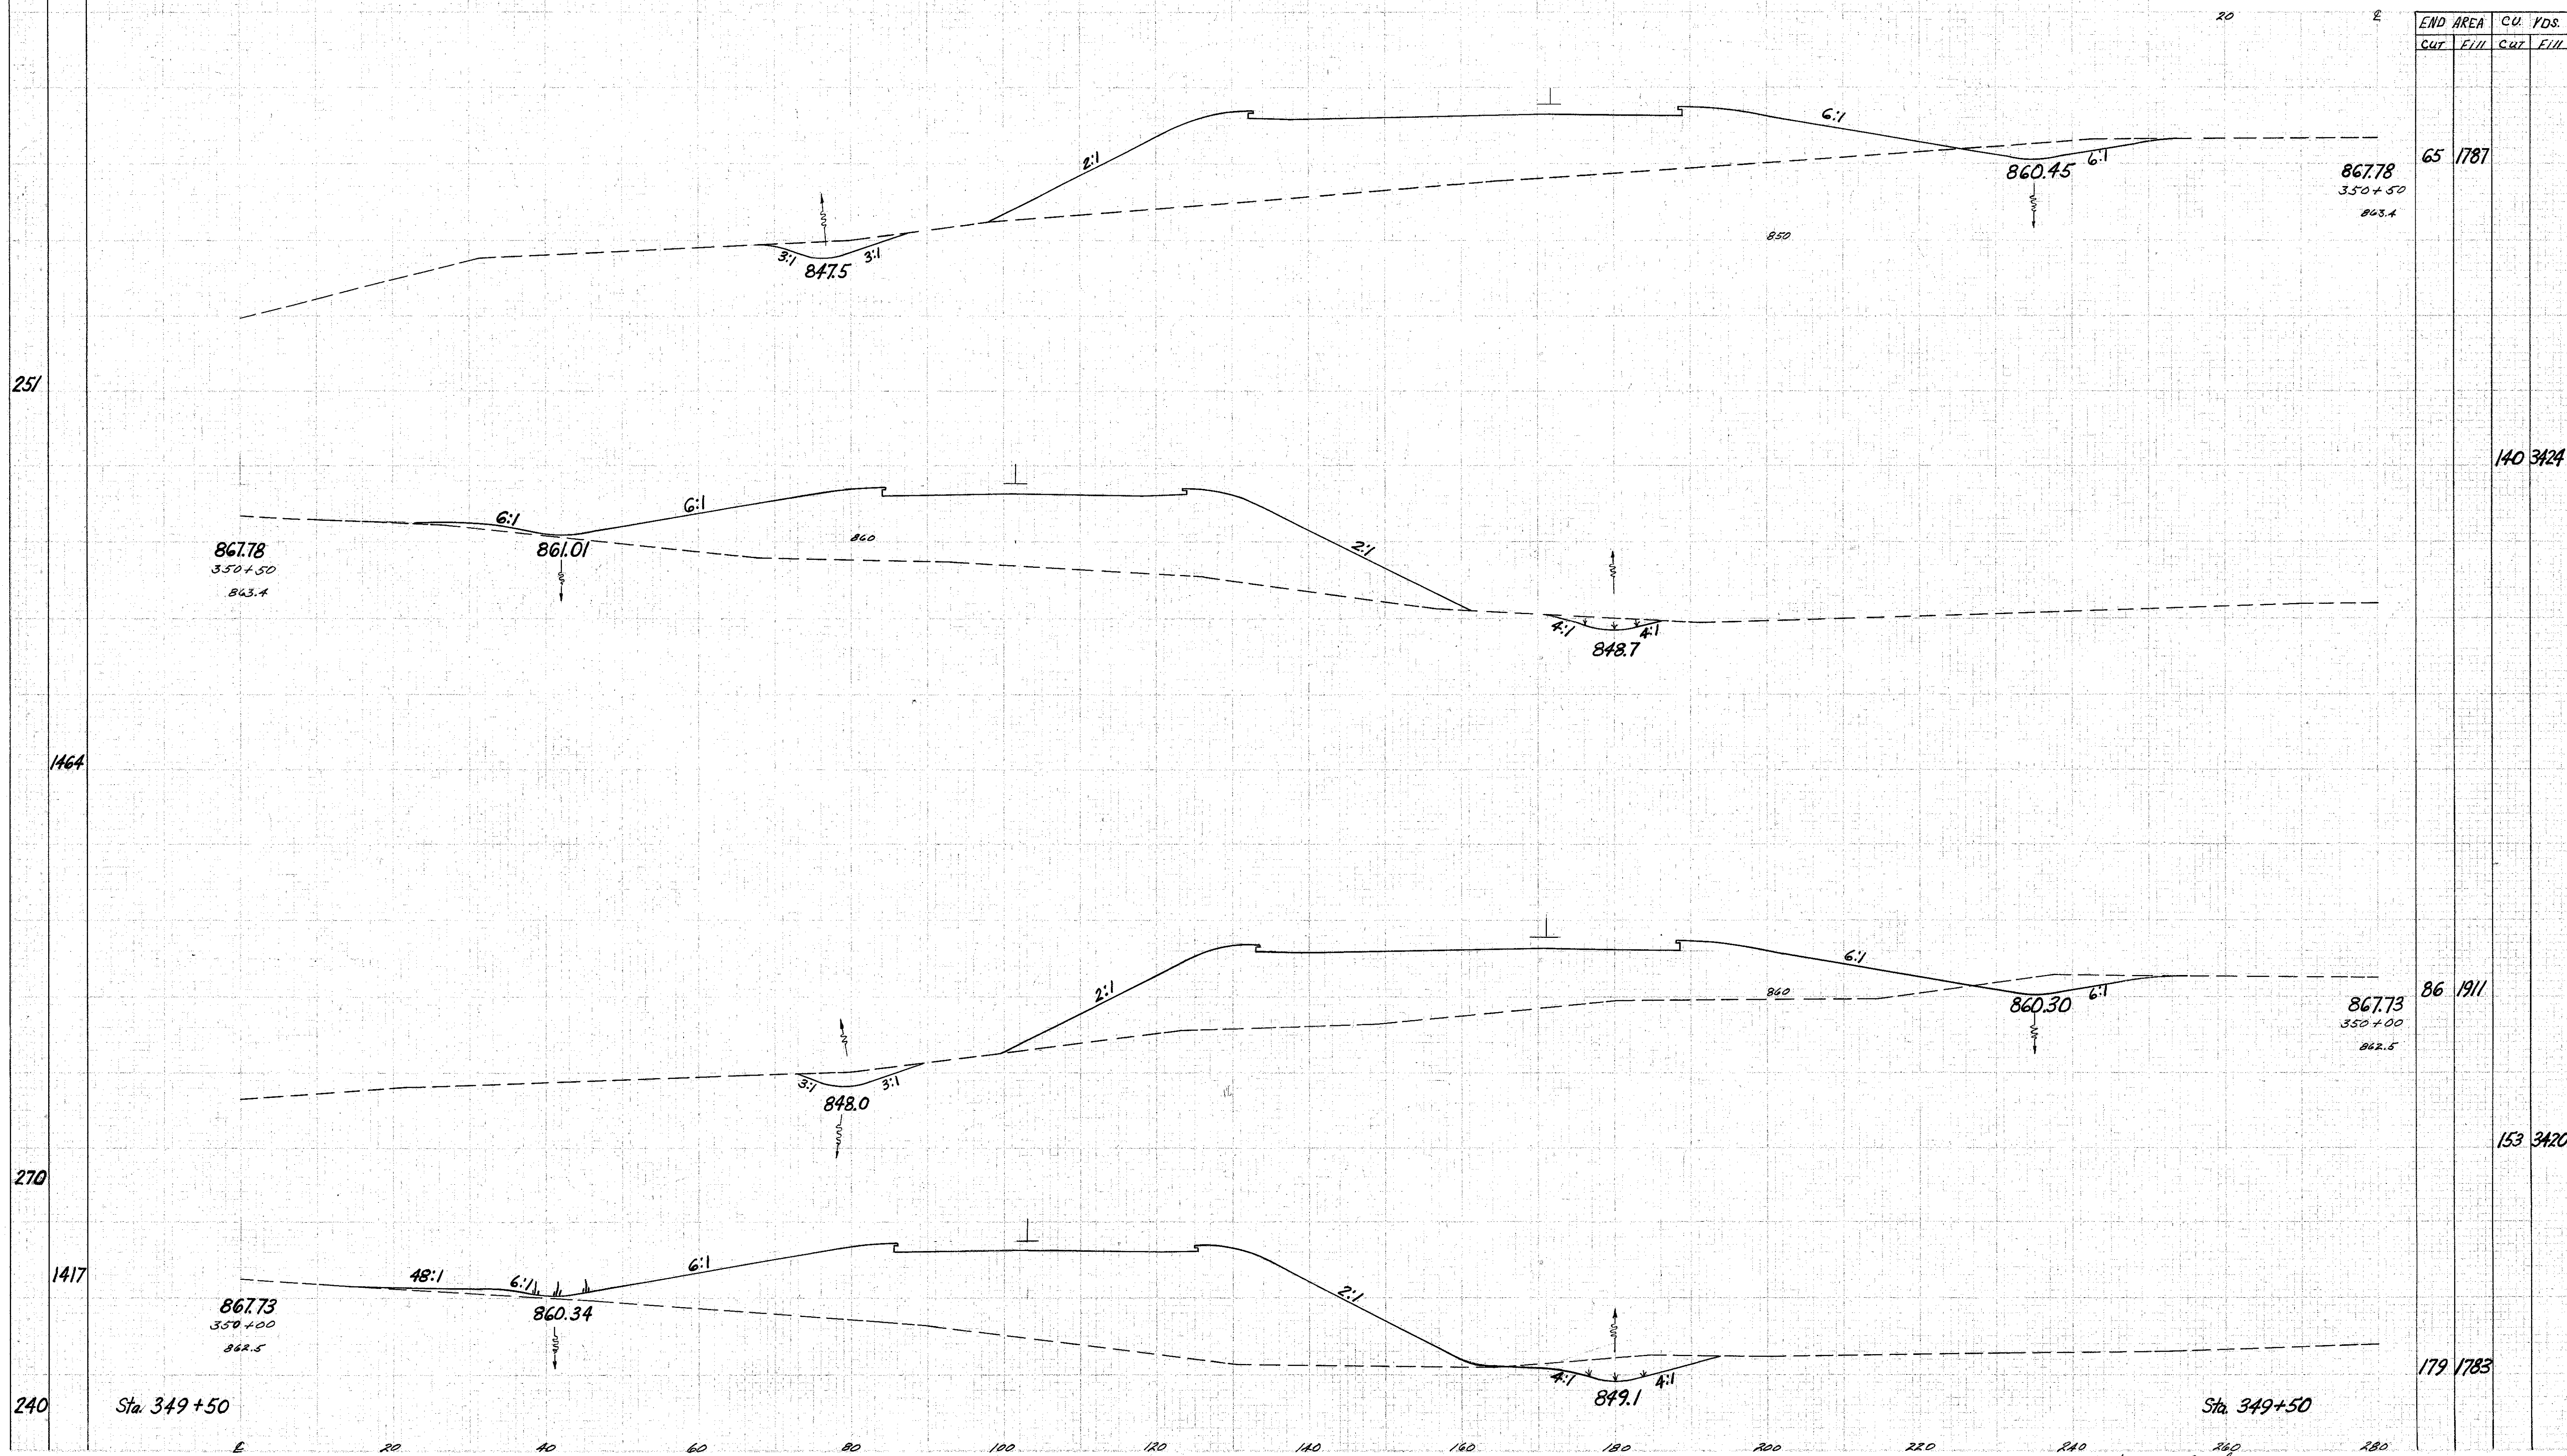

251

1464

270

1417

240

Sta. 349+50

Sta. 349+50

27 Oct. '58
Sta. 350+00 TO 350+50