


SEEDING 280 260 240 220 200 180 160 140 120 100 80 60 40

FILE NO.	STATE	PROJECT	68
2	OHIO	ACI-1103 (21)	488

This sheet supersedes sheet no. 68 of the original plan.

LAKE COUNTY  
LAK-1-12.89

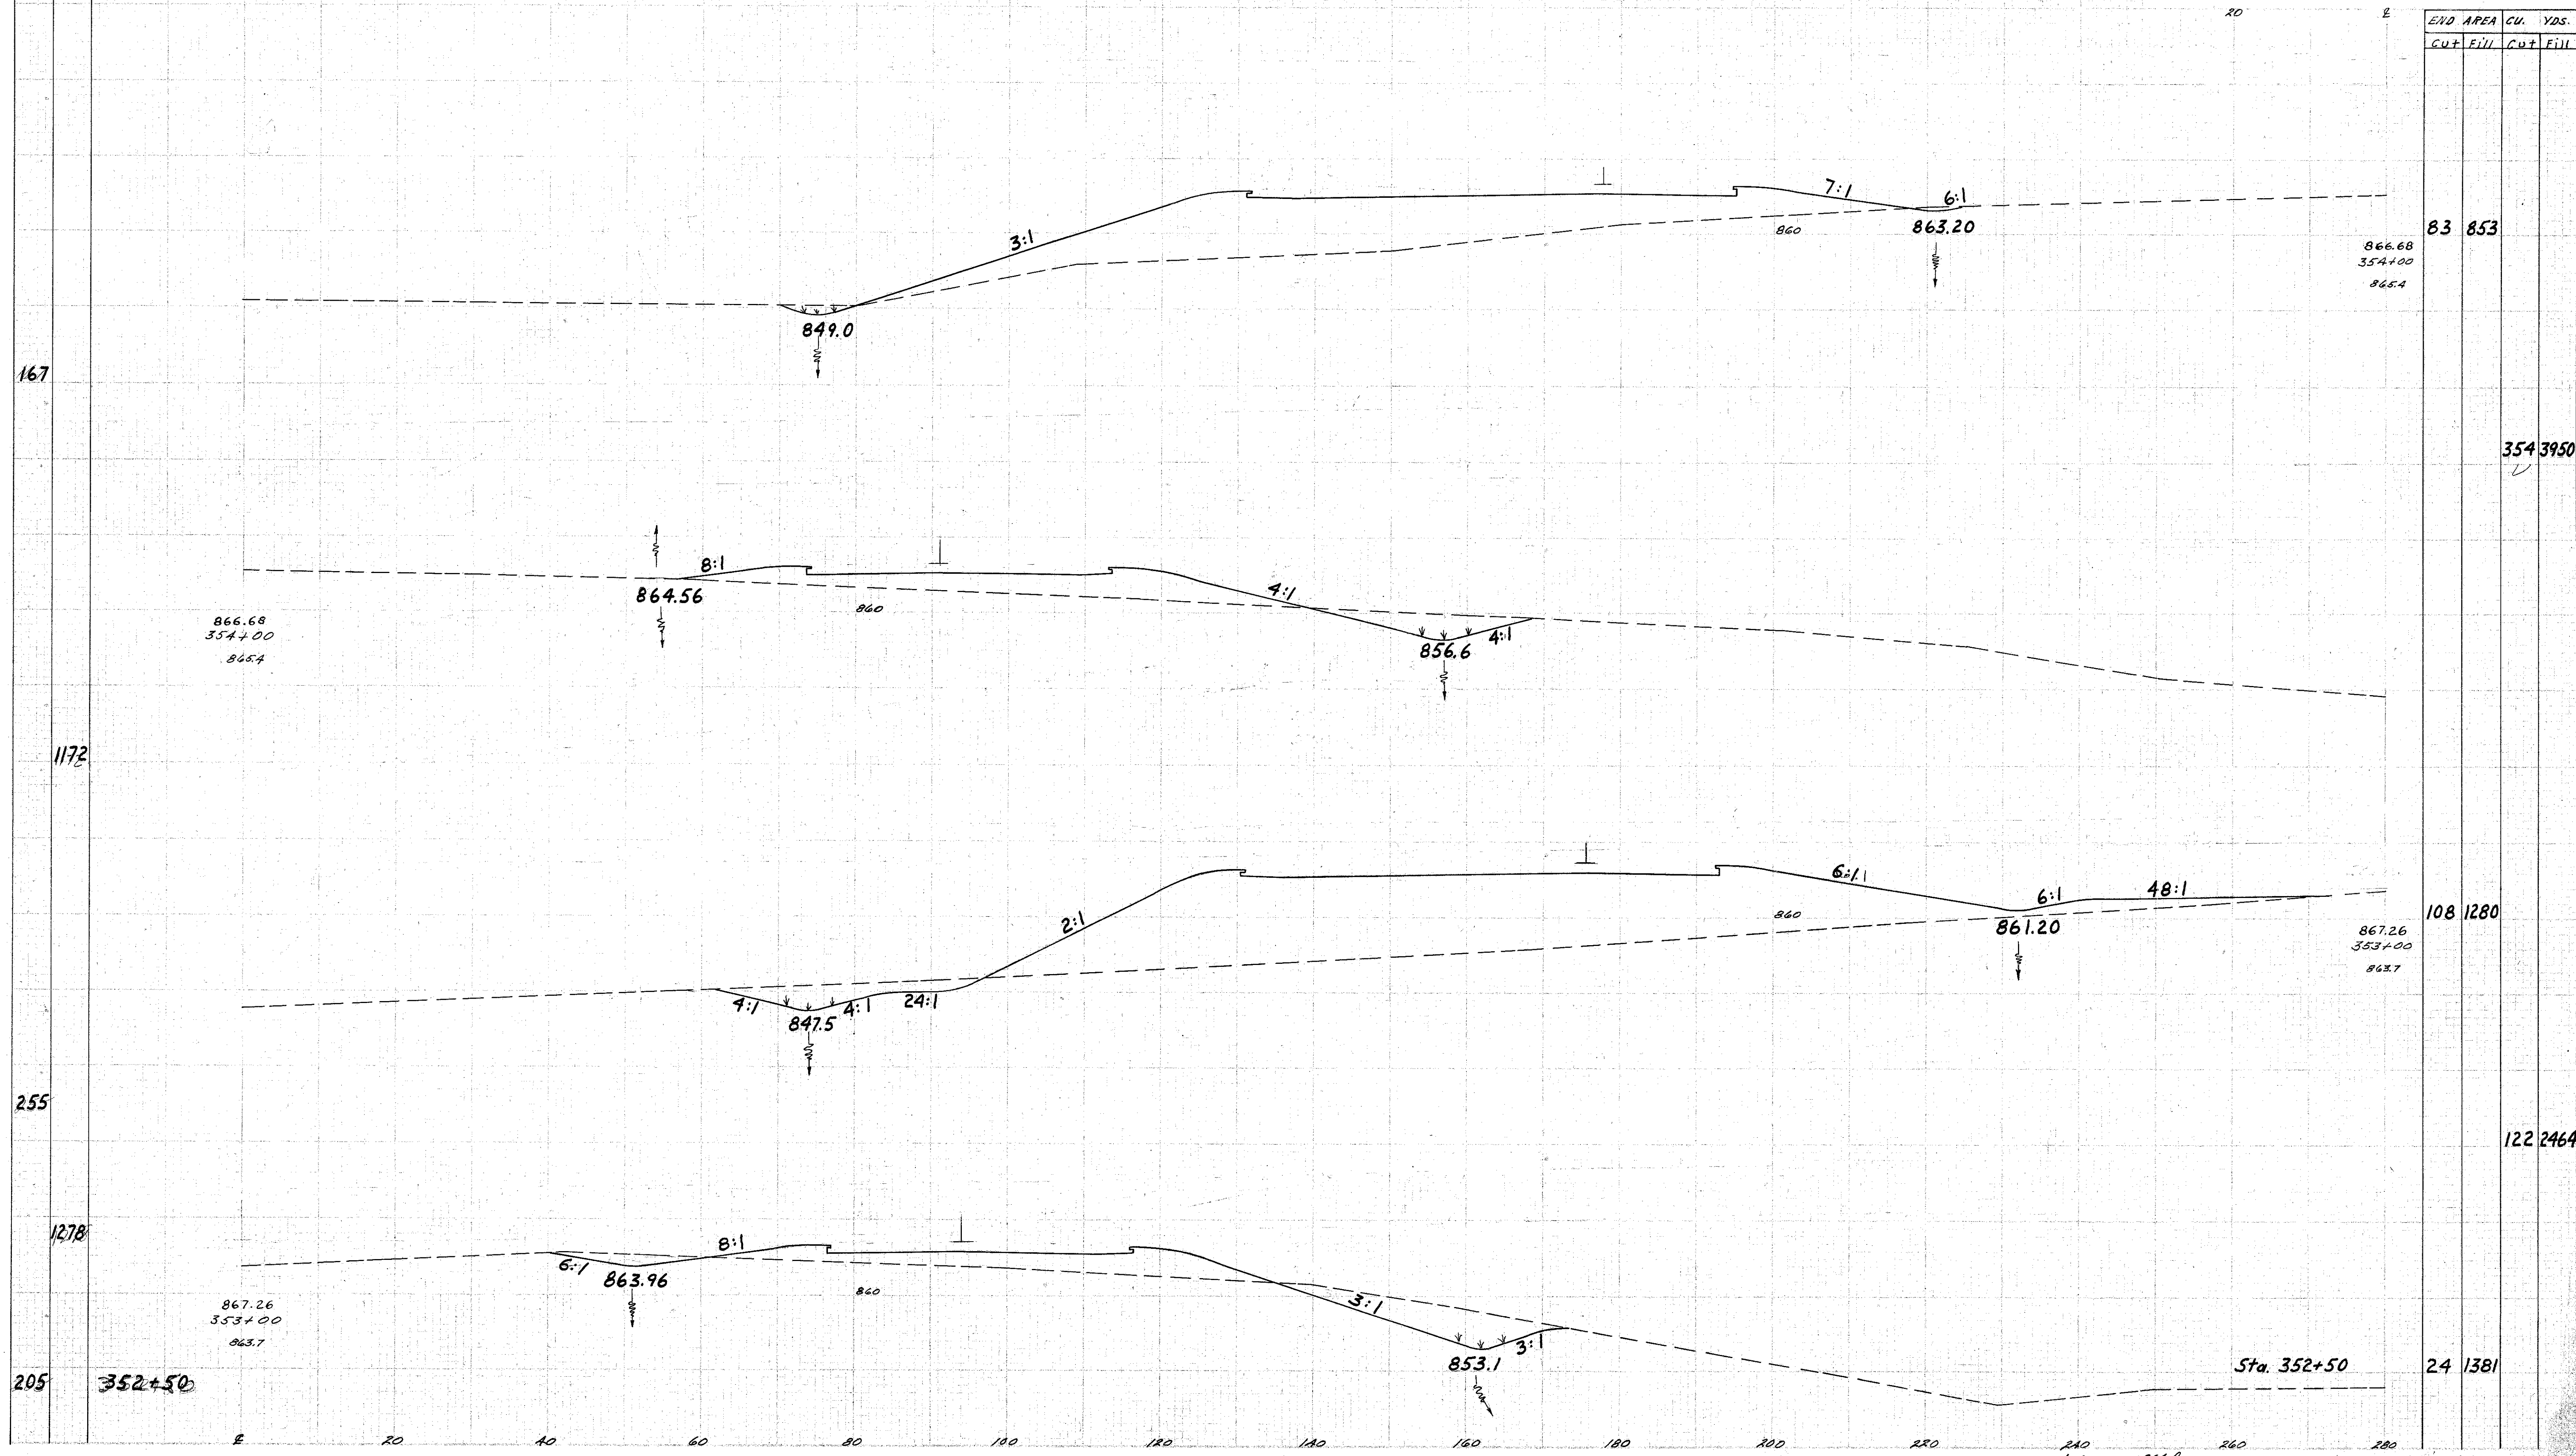

END AREA	CU.	YDS.	
Cut	Fill	Cut	Fill

83 853  
866.68  
354+00  
865.4

354 3950

108 1280  
867.26  
353+00  
863.7

122 2464

24 1381

27 Oct. '58 *[Signature]*

Sta. 353+00 TO 354+00