


SEEDING  
END WIDTH SR. YRS.

SER. NO.	STATE	PROJECT	71
2	OHIO	ACI-1103 (21)	488

This sheet supersedes sheet no. 71 of the original plan.

LAKE COUNTY  
LAK-1-12.89

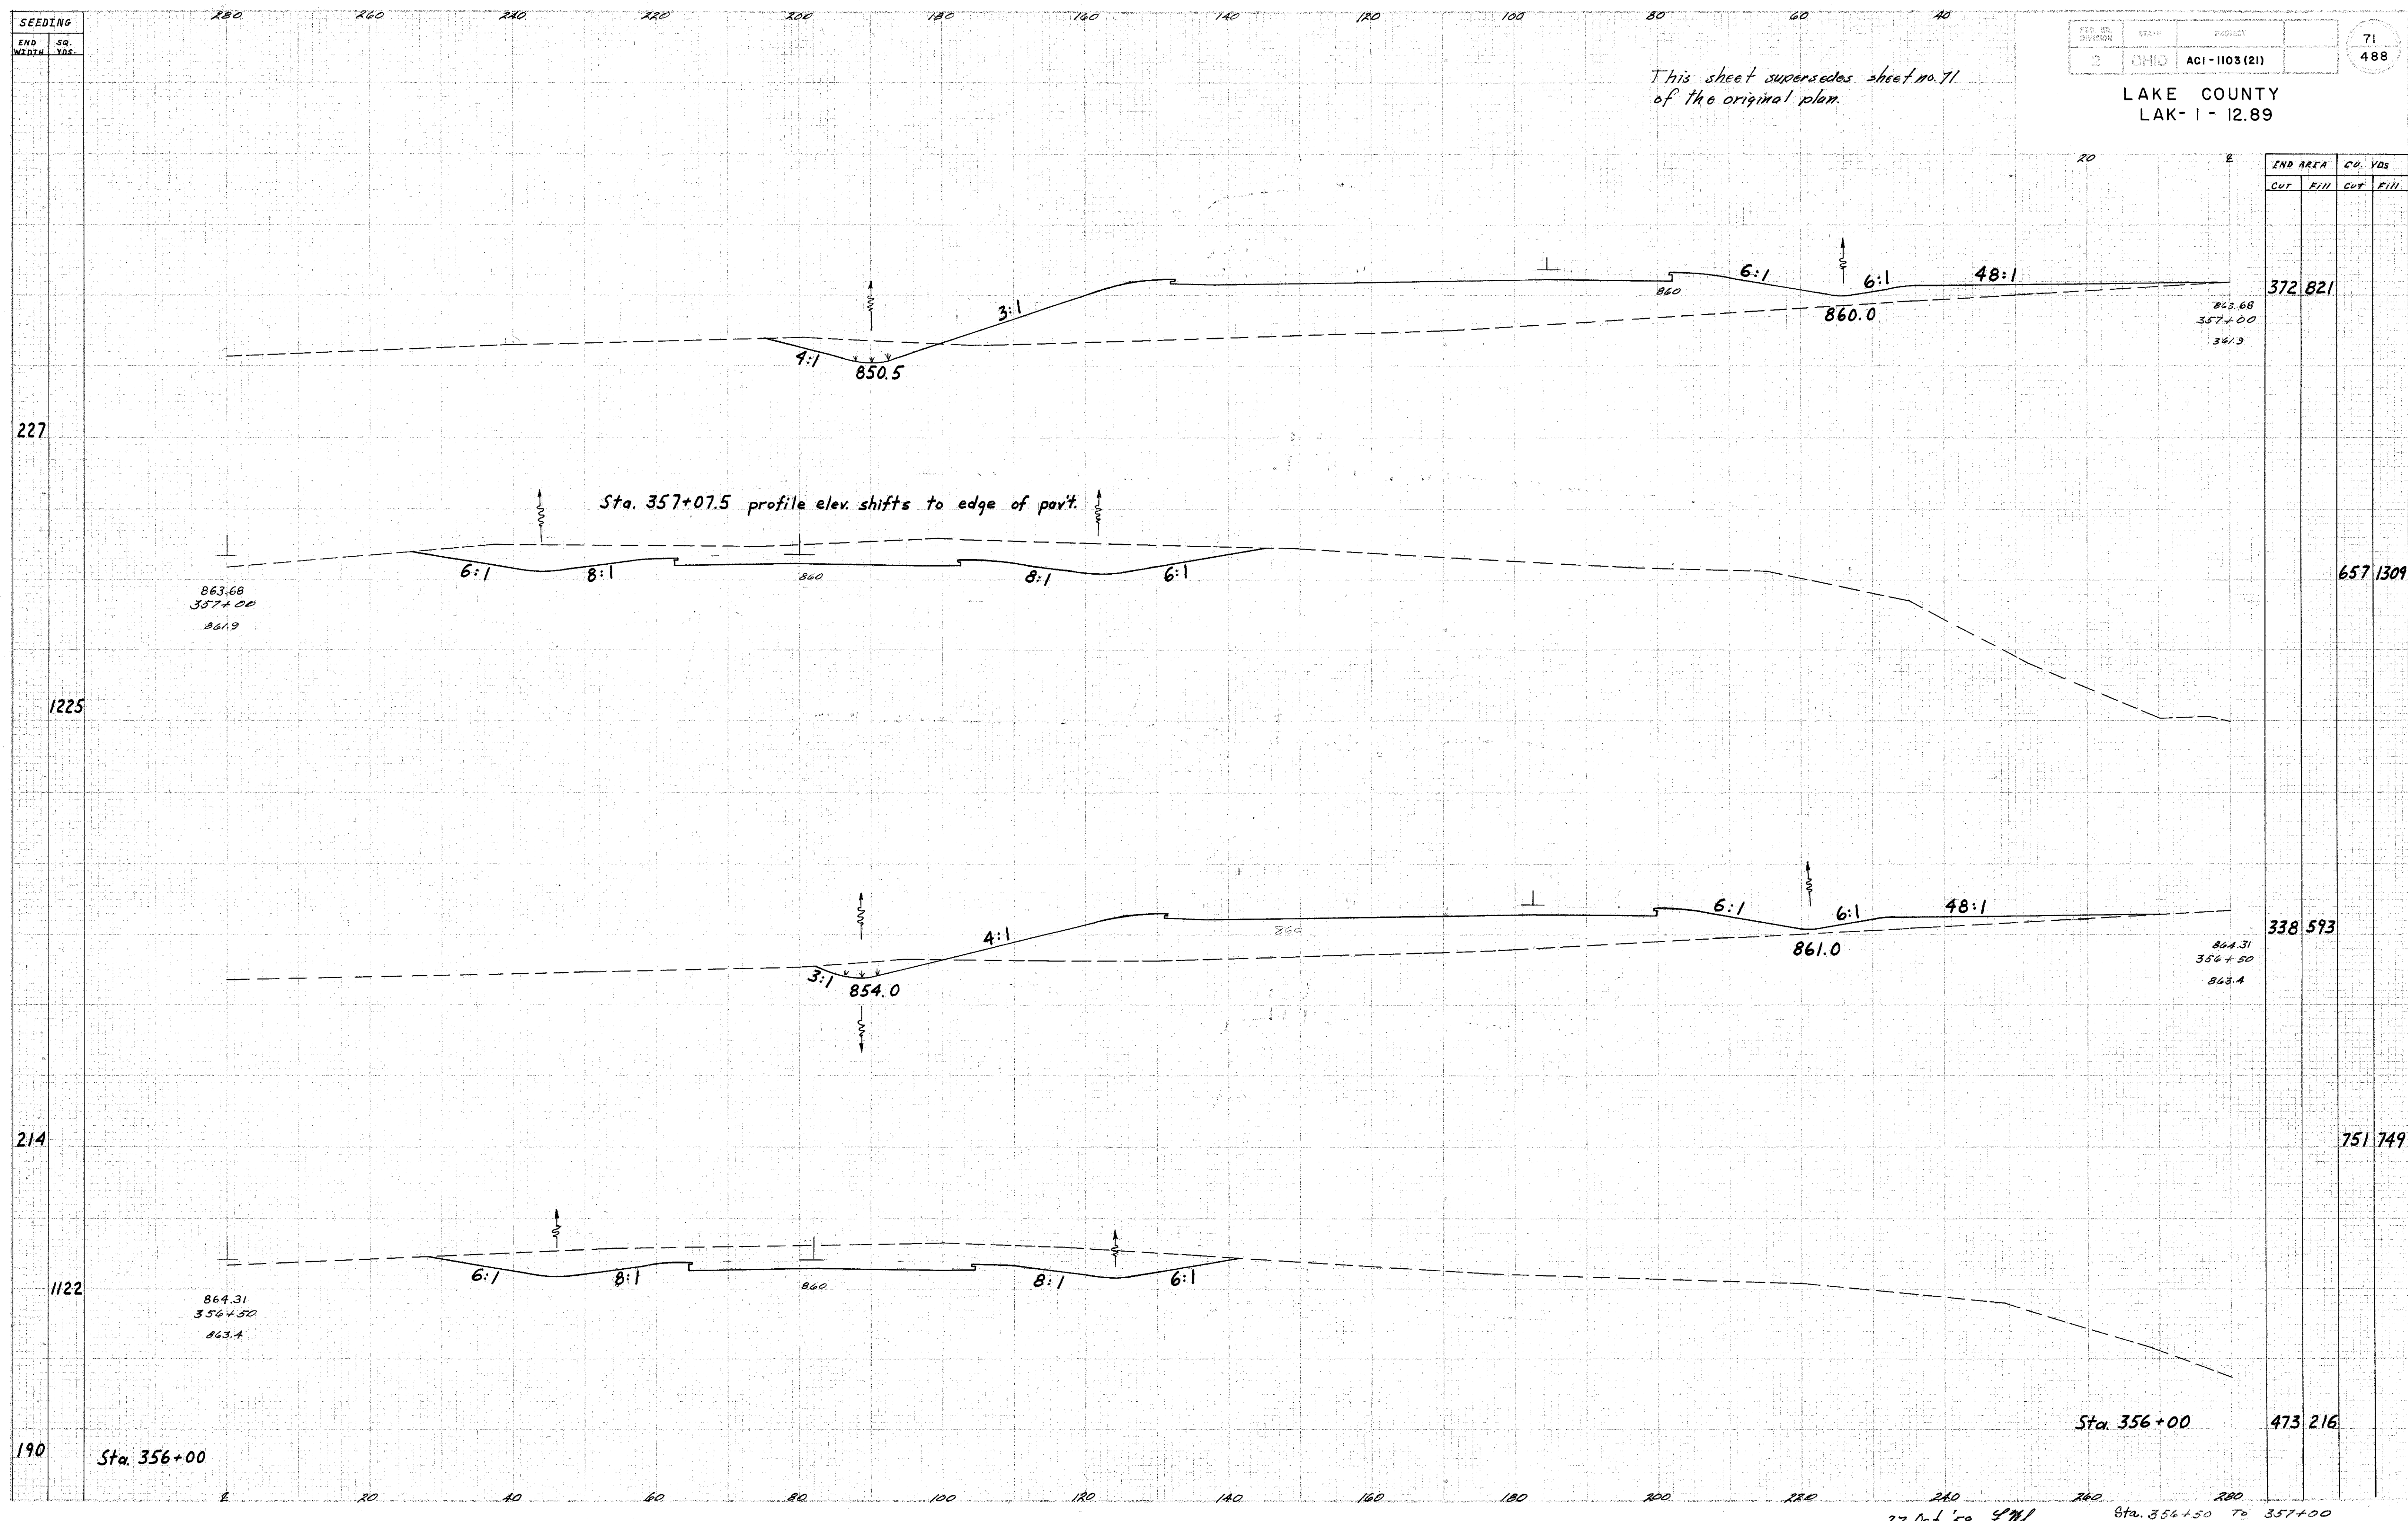

END AREA		CO. YDS	
CUT	FILL	CUT	FILL
		372	821
		657	1309
		338	593
		751	749
		473	216