

SEEDING

5/14/58


280 260 240 220 200 180 160 140 120 100 80 60 40

DATE	7/15/58	PROJECT	ACI-1103 (21)
DRAWN	CHG	CHECKED	

73
488

This sheet supersedes sheet no. 73
of the original plan.

LAKE COUNTY
LAK-1- 12.89

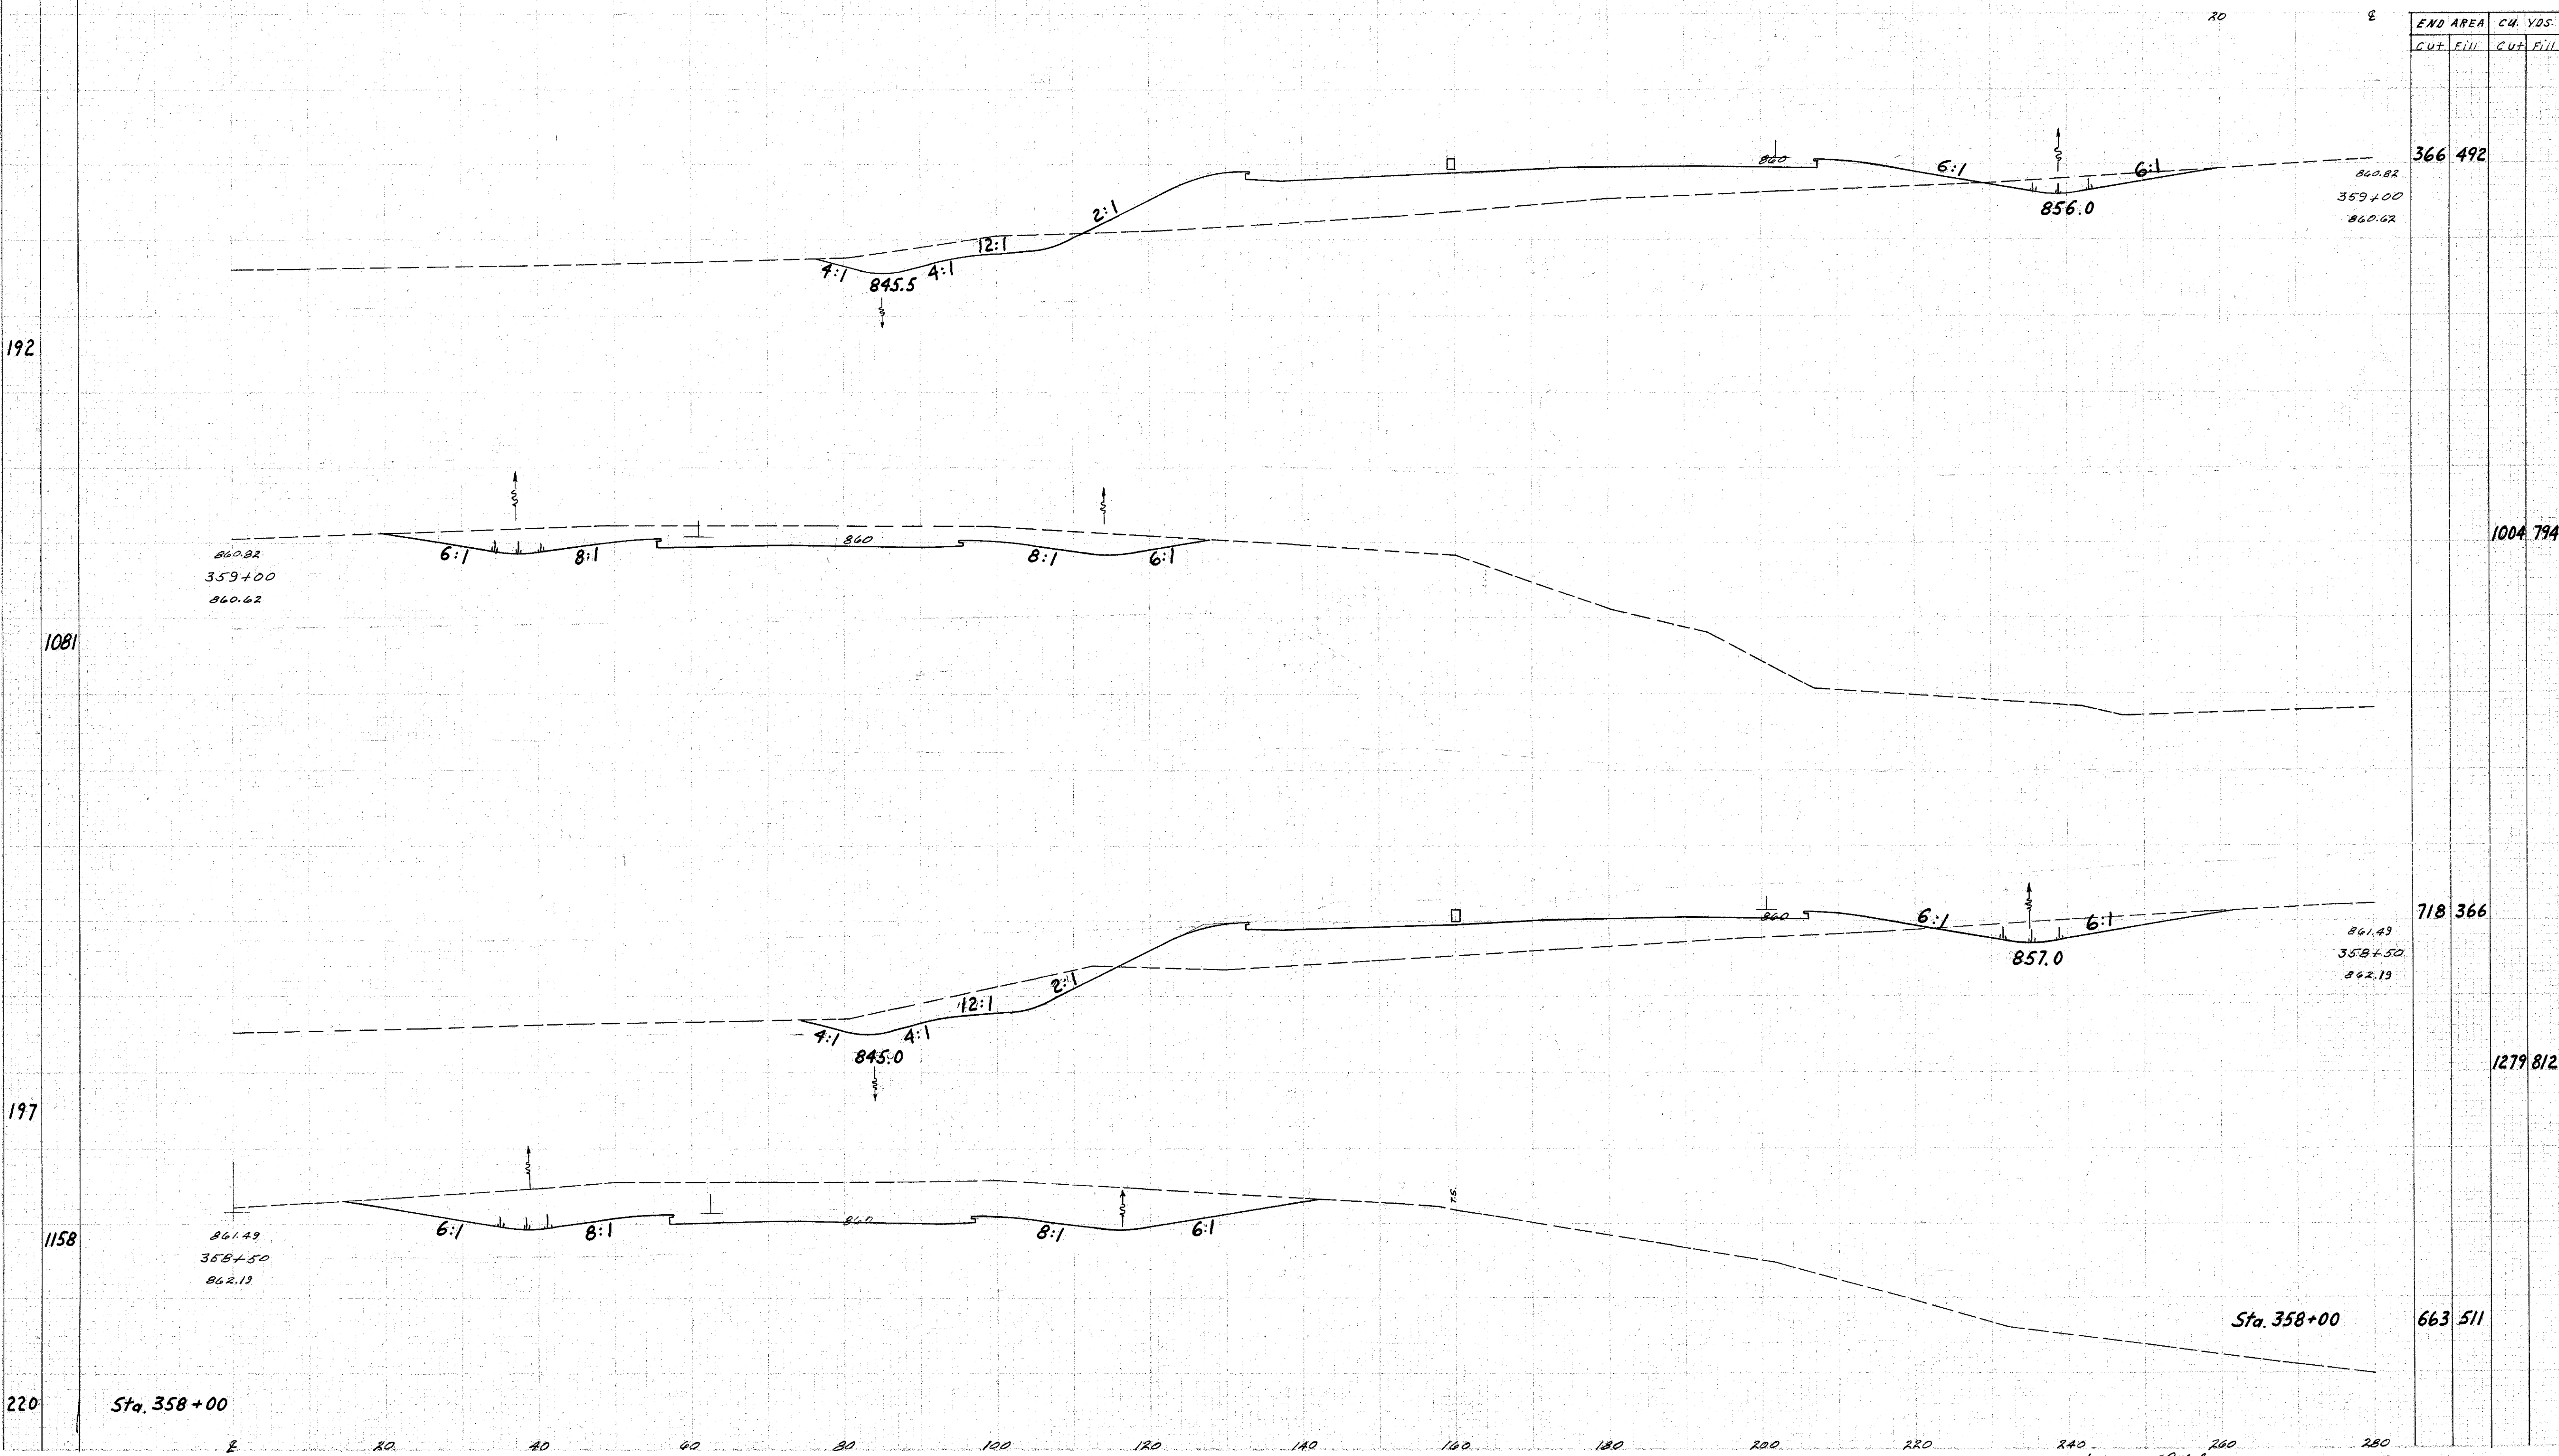

END AREA		CU. YDS.	
CUT	FILL	CUT	FILL

366	492		
860.82			
359+00			
860.62			

1004	794		
------	-----	--	--

718	366		
861.43			
358+50			
862.13			

1279	812		
------	-----	--	--

Sta. 358+00 663 511

Sta. 358+00

27 Oct. '58
Sta. 358+50 To 359+00