ACI-1103 (21)

75
488

LAKE COUNTY
LAK-I- 12.89

This sheet supersedes sheet no 75 of the original plan.

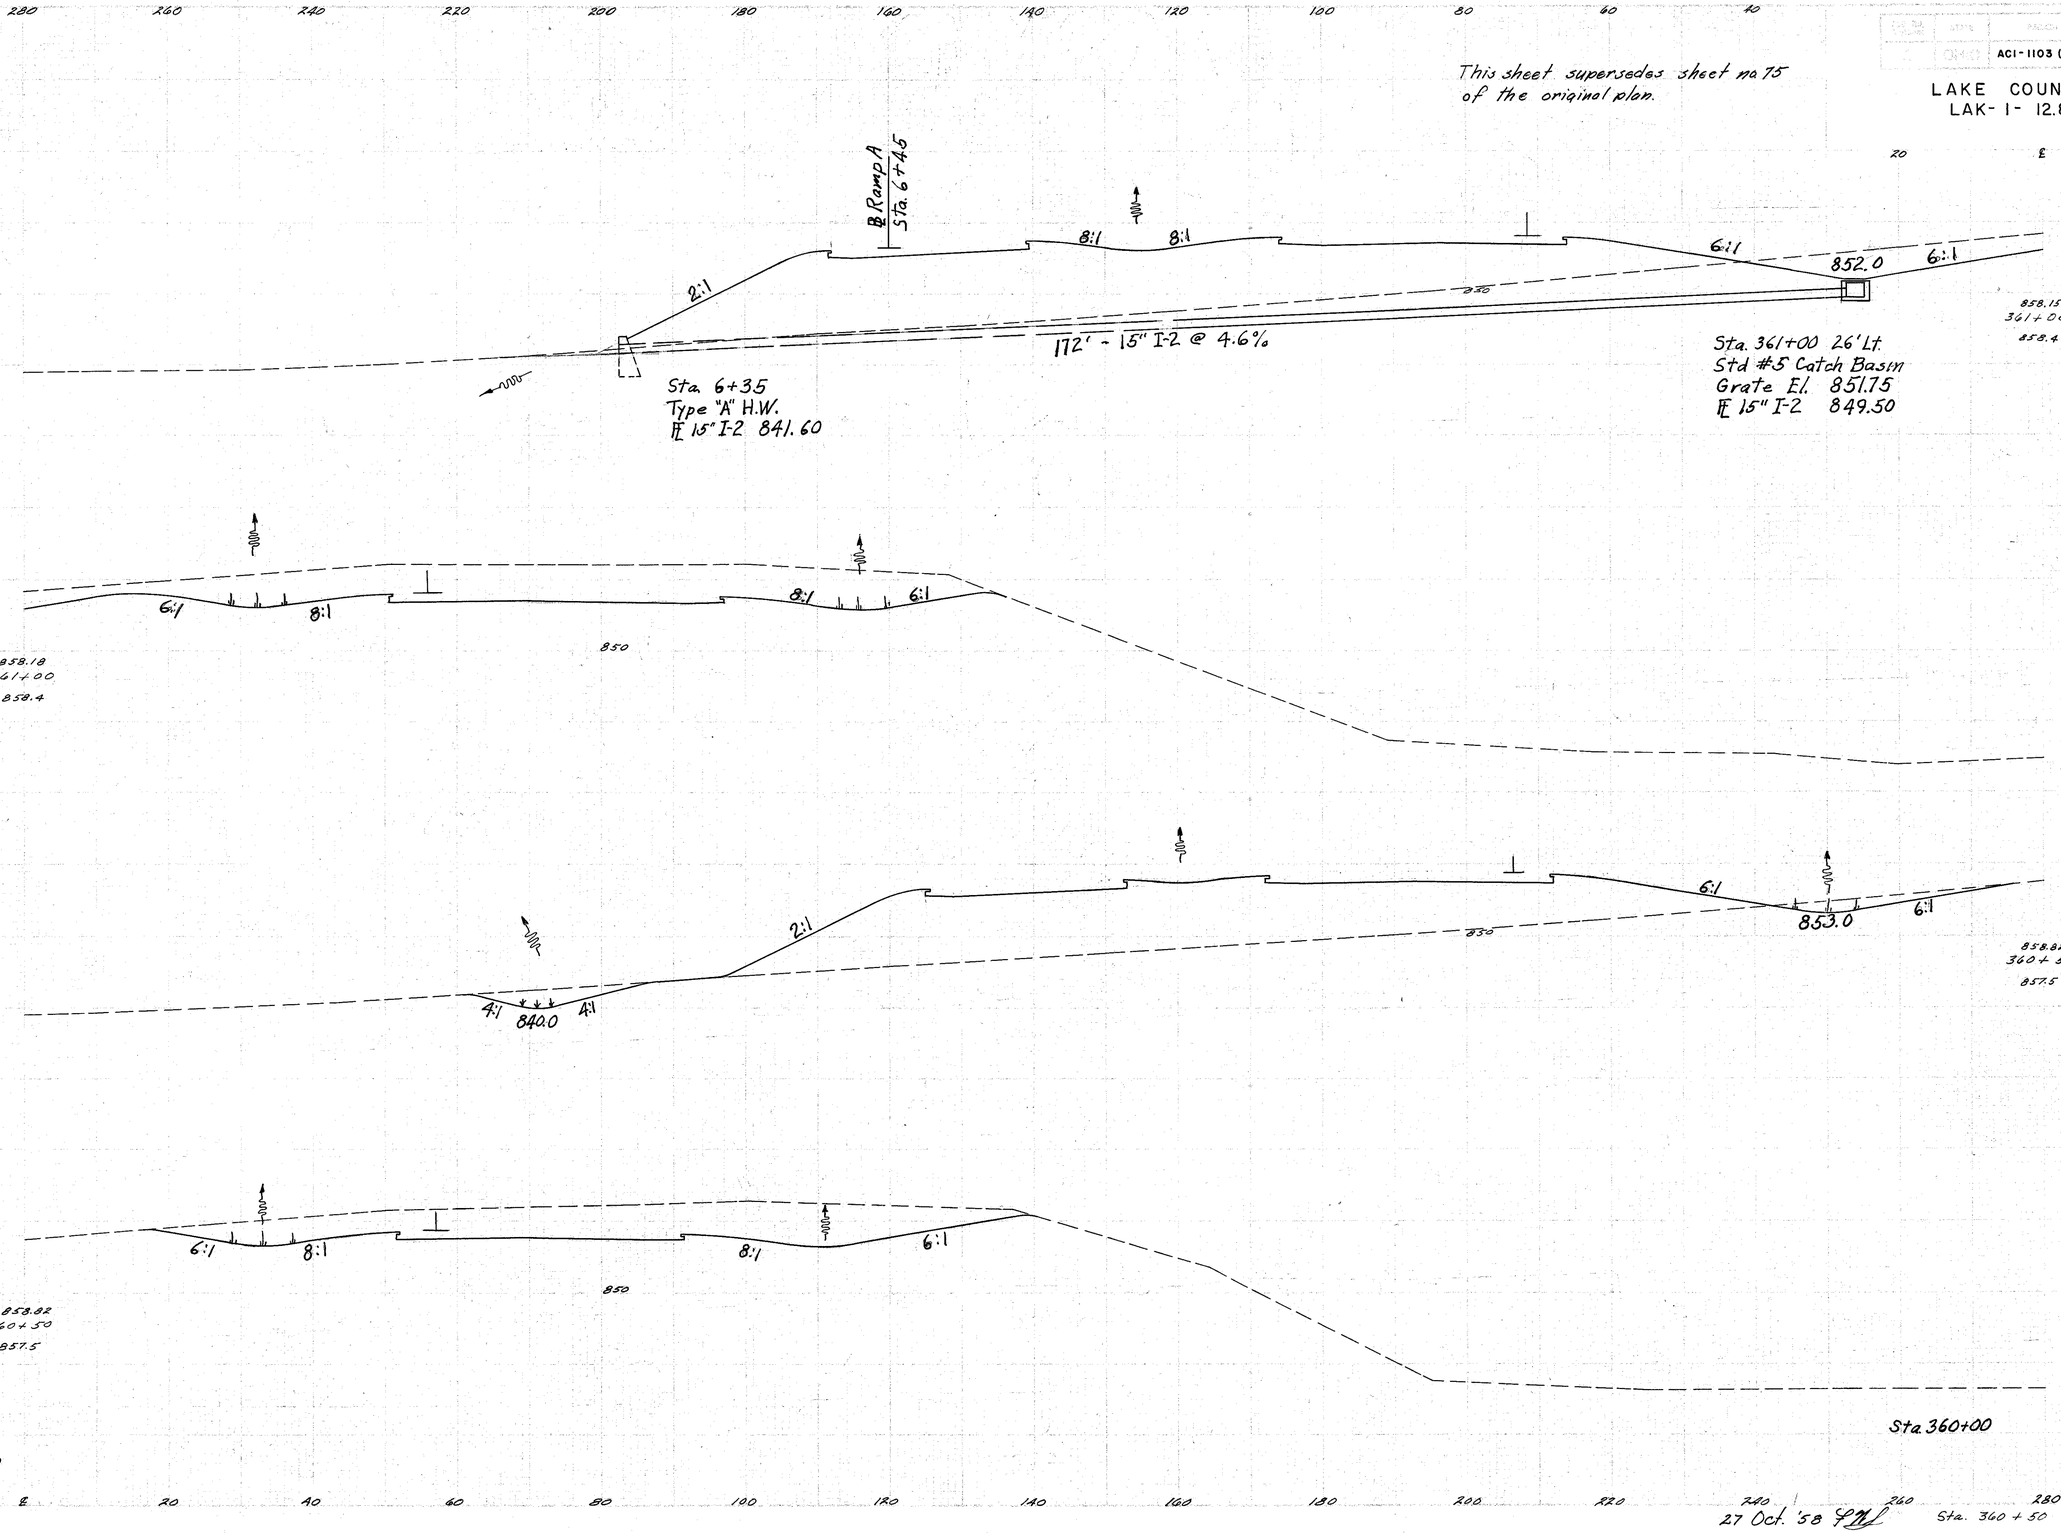

SEEDING		END AREA		CU. YDS.	
FTG WIDTH	SQ YDS.	Cut	Fill	Cut	Fill
		670	1180		
232				1115	2010
1283					
		534	995		
230				863	829
1252					
		398	980		
221	Sta. 360+00				

27 Oct. '58 [illegible]

Sta. 360+50 TO 361+00