ACI-1103 (21)

76
488

This sheet supersedes sheet no. 76 of the original plan.

LAKE COUNTY
LAK-1-12.89

SEEDING	
END WIDTH	SQ. YDS.
246	
1328	
232	Sta. 361+00

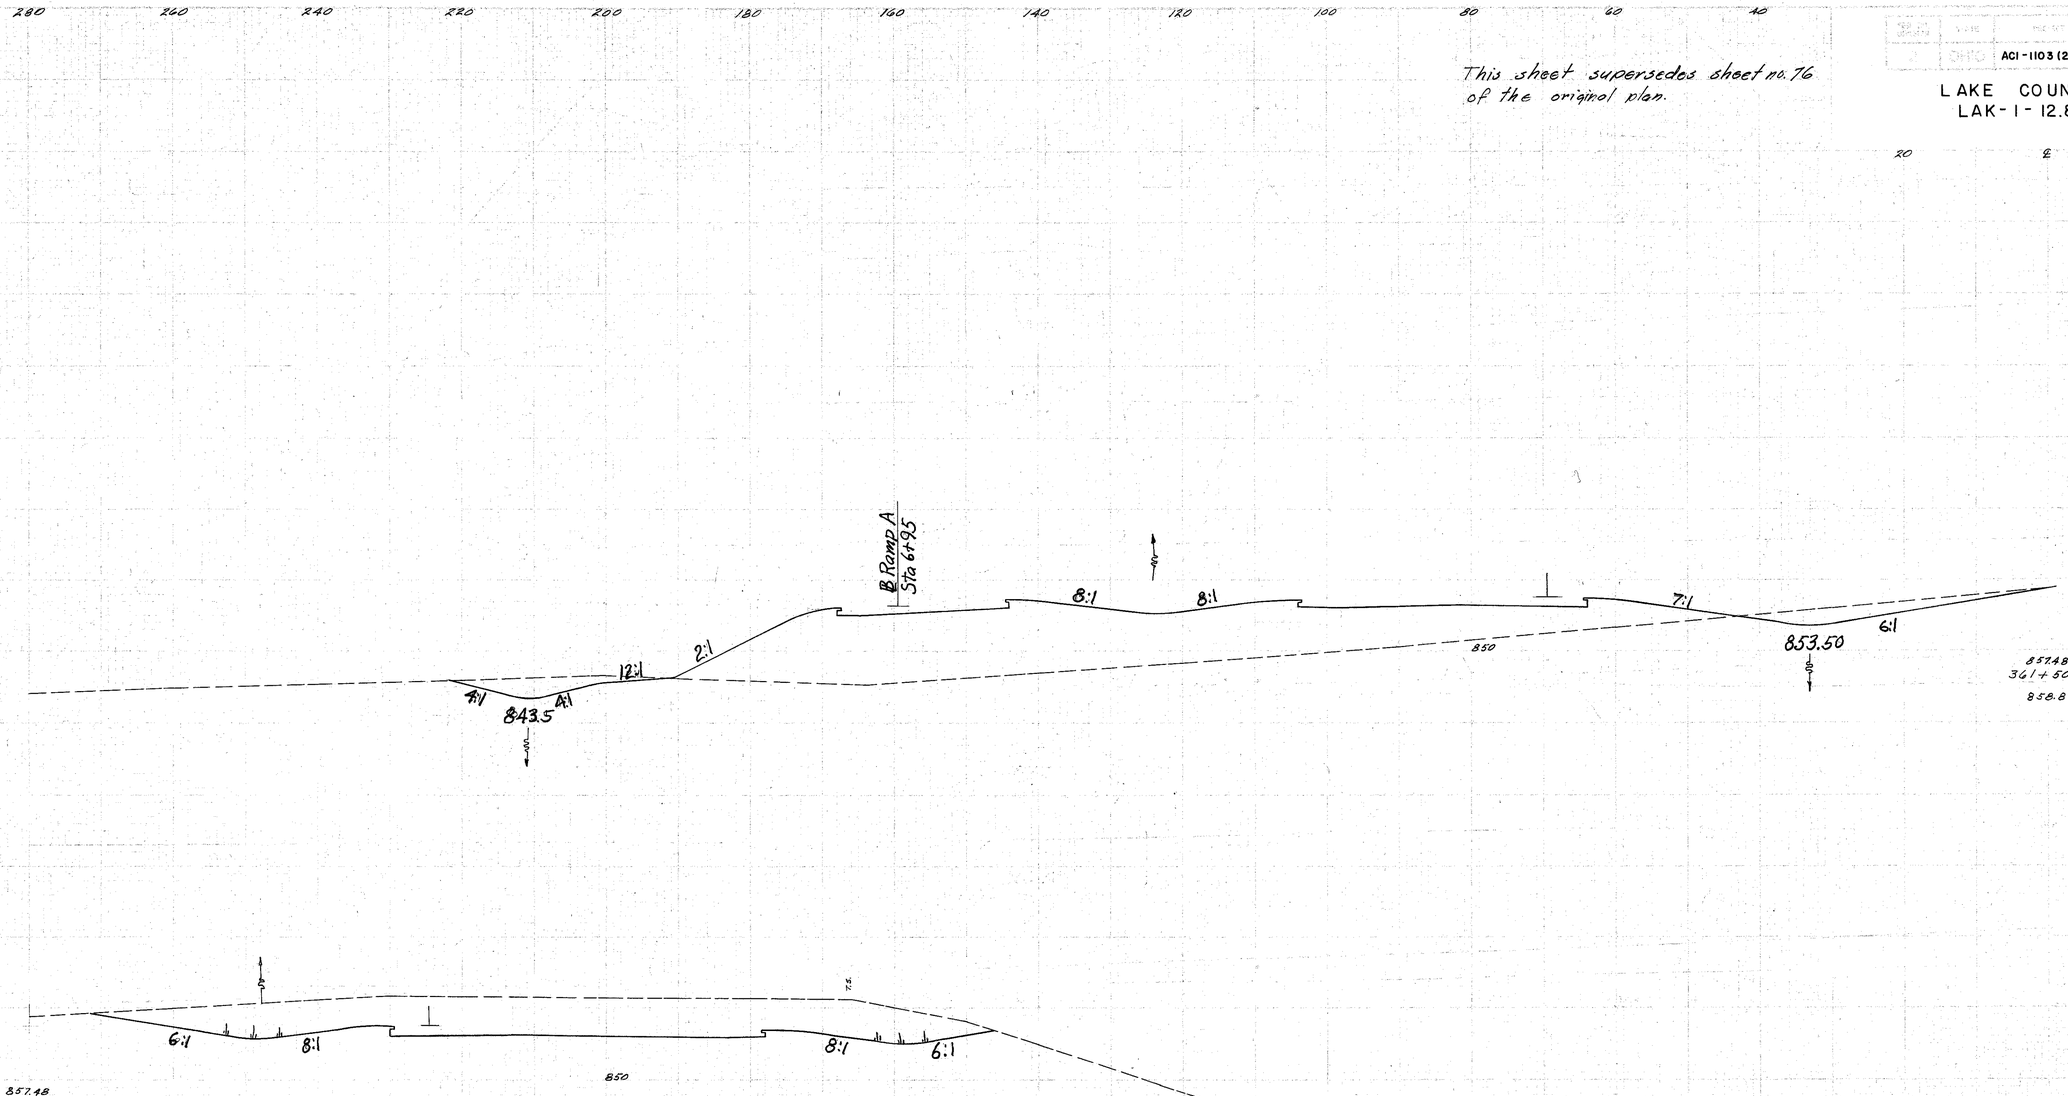

END AREA		CU. YDS.	
Cut	Fill	Cut	Fill
648	963		
		1220	1984
		580	1180

27 Oct. '58 Filed