


SEEDING

 STATE OHIO PROJECT ACI-1103 (21)

78
 488

This sheet supersedes sheet no. 78
 of the original plan.

LAKE COUNTY
 LAK-1-12.89

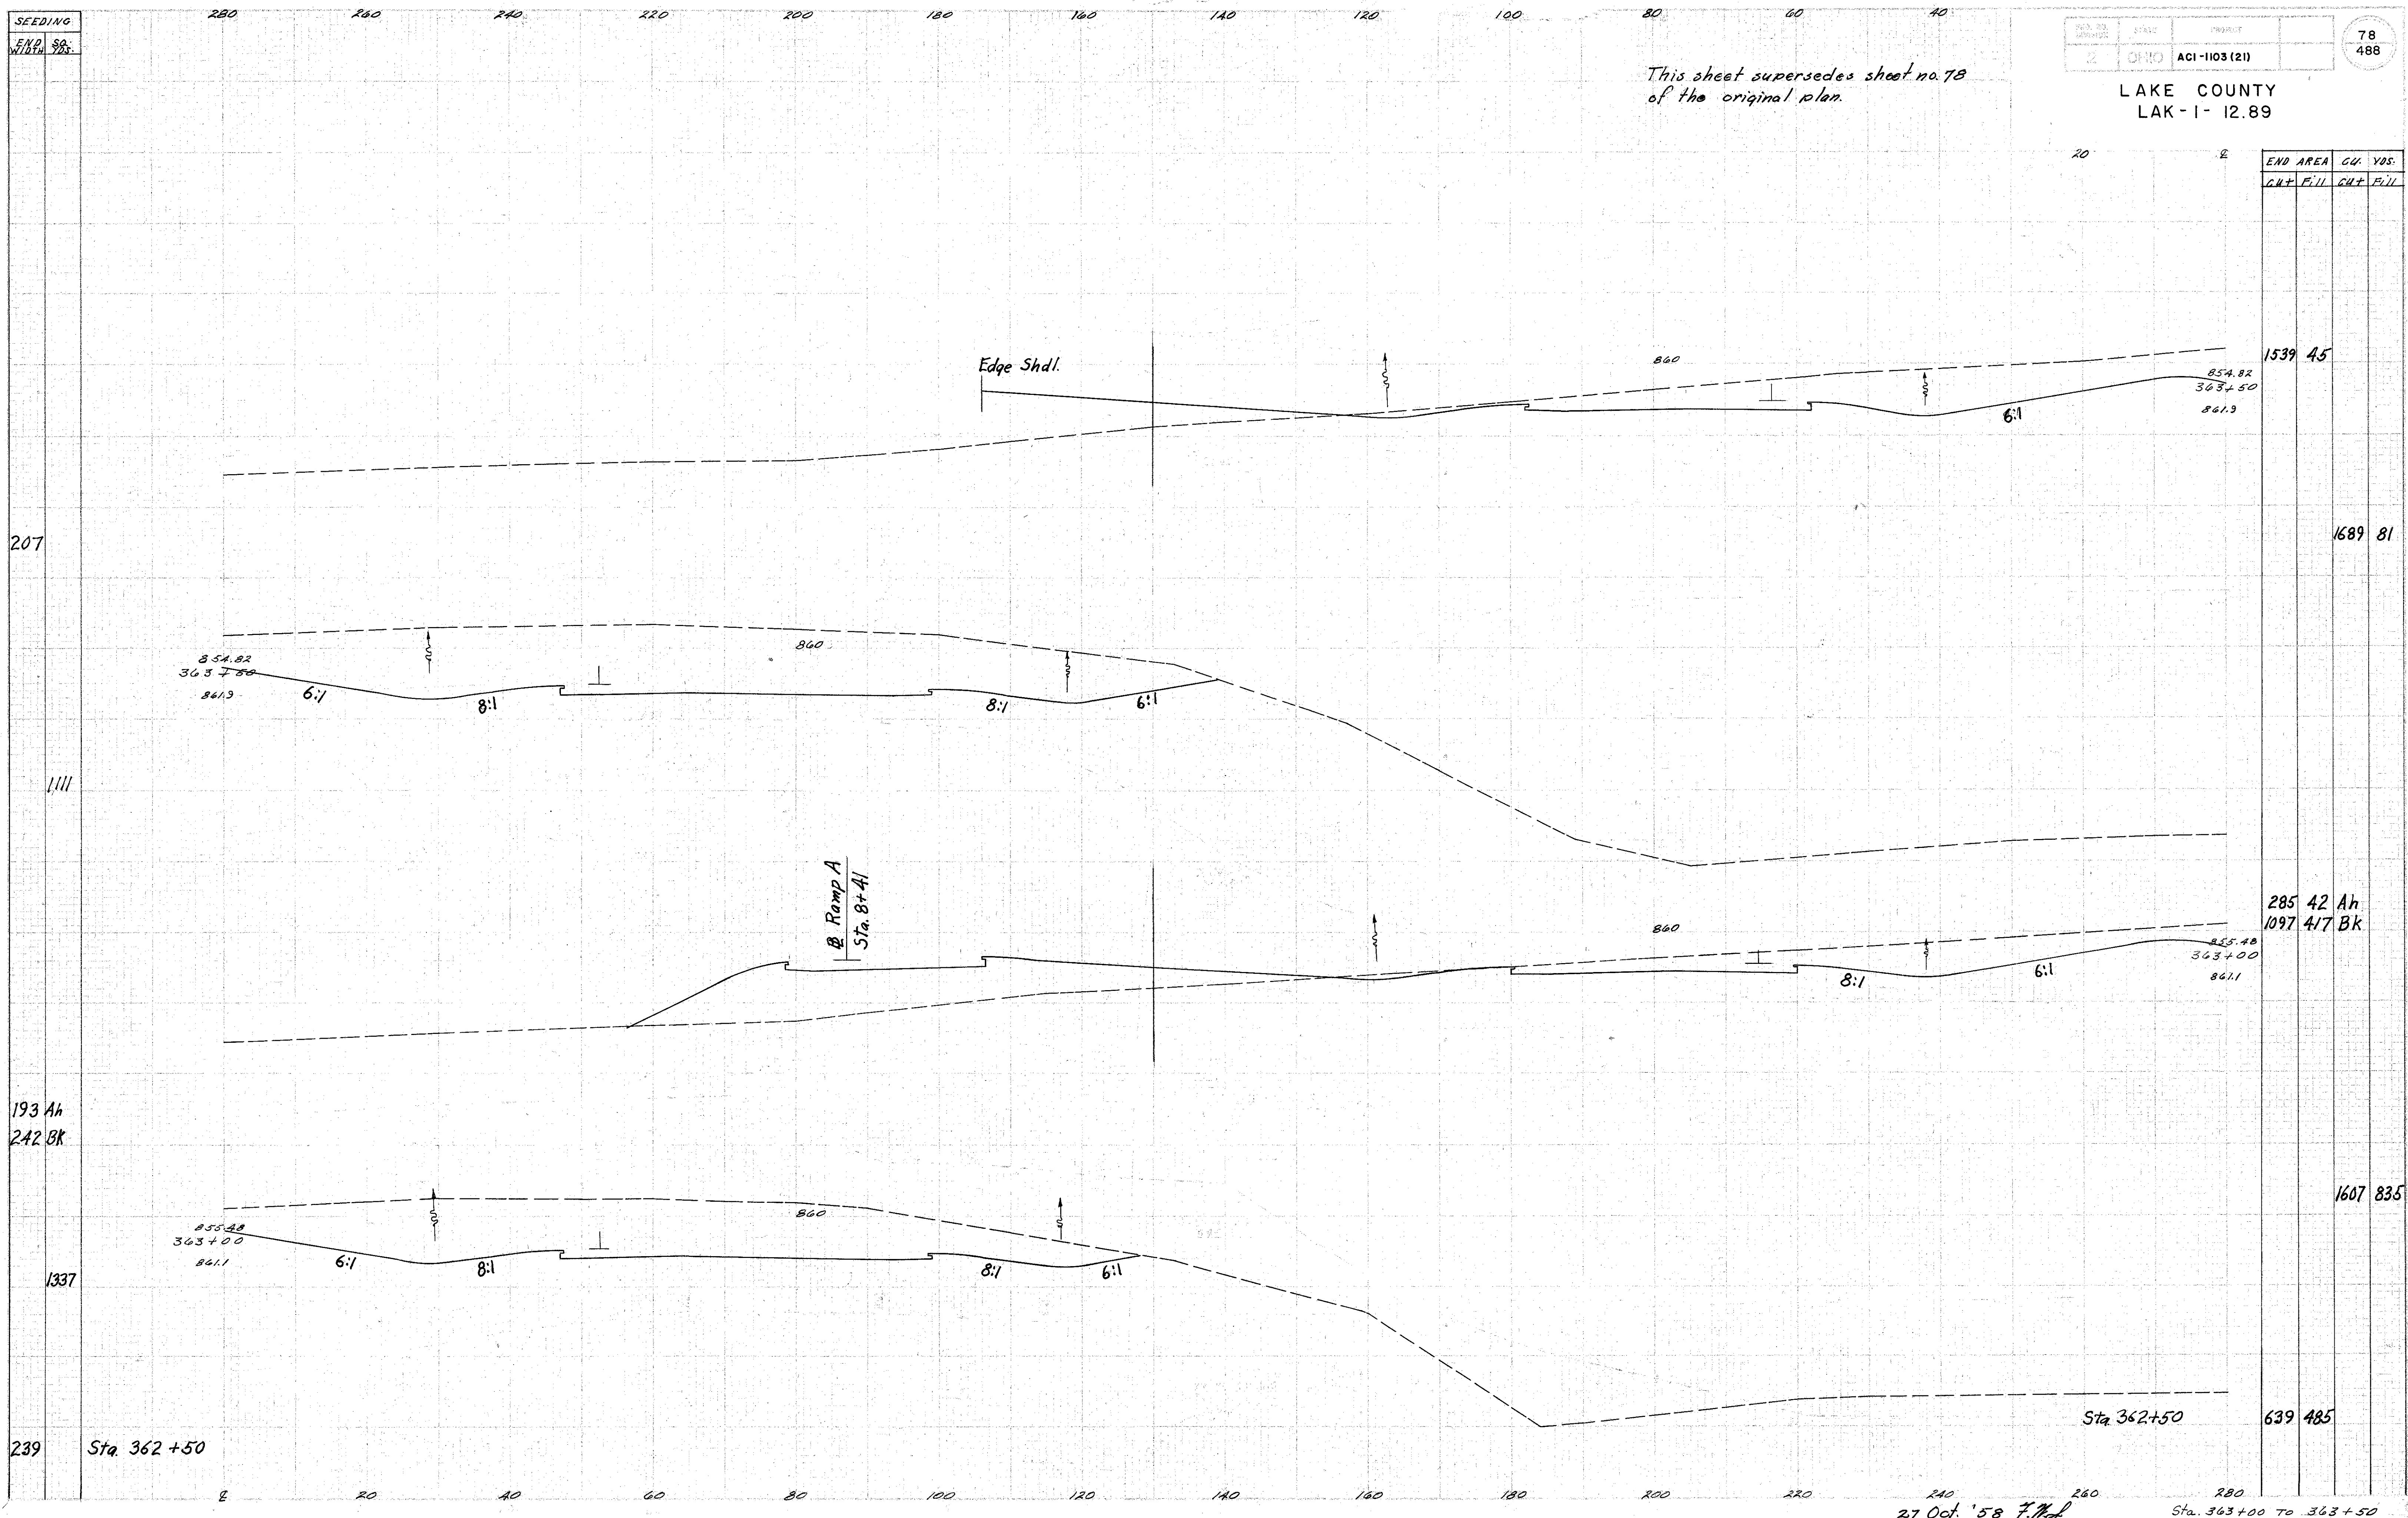

| END AREA | | CU. YDS. | |
|----------|------|----------|------|
| CUT | FILL | CUT | FILL |

| | |
|------|----|
| 1539 | 45 |
|------|----|

| | | |
|--------|--------|-------|
| 854.82 | 363+50 | 861.9 |
|--------|--------|-------|

| | |
|------|----|
| 1689 | 81 |
|------|----|

| | |
|------|--------|
| 285 | 42 Ah |
| 1097 | 417 BK |

| | | |
|--------|--------|-------|
| 855.48 | 363+00 | 861.1 |
|--------|--------|-------|

| | |
|------|-----|
| 1607 | 835 |
|------|-----|

| | |
|-----|-----|
| 639 | 485 |
|-----|-----|

27 Oct. '58 F.M.S. Sta. 363+00 TO 363+50