


SEED/16 280 260 240 220 200 180 160 140 120 100 80 60 40

END STA. 208 1180 217 1248 233

FED. DIST. DISTRICT	STATE	PROJECT	81 488
2	OHIO	ACI-1103 (21)	

This sheet supersedes sheet no. 81 of the original plan.

LAKE COUNTY
LAK-1-12.89

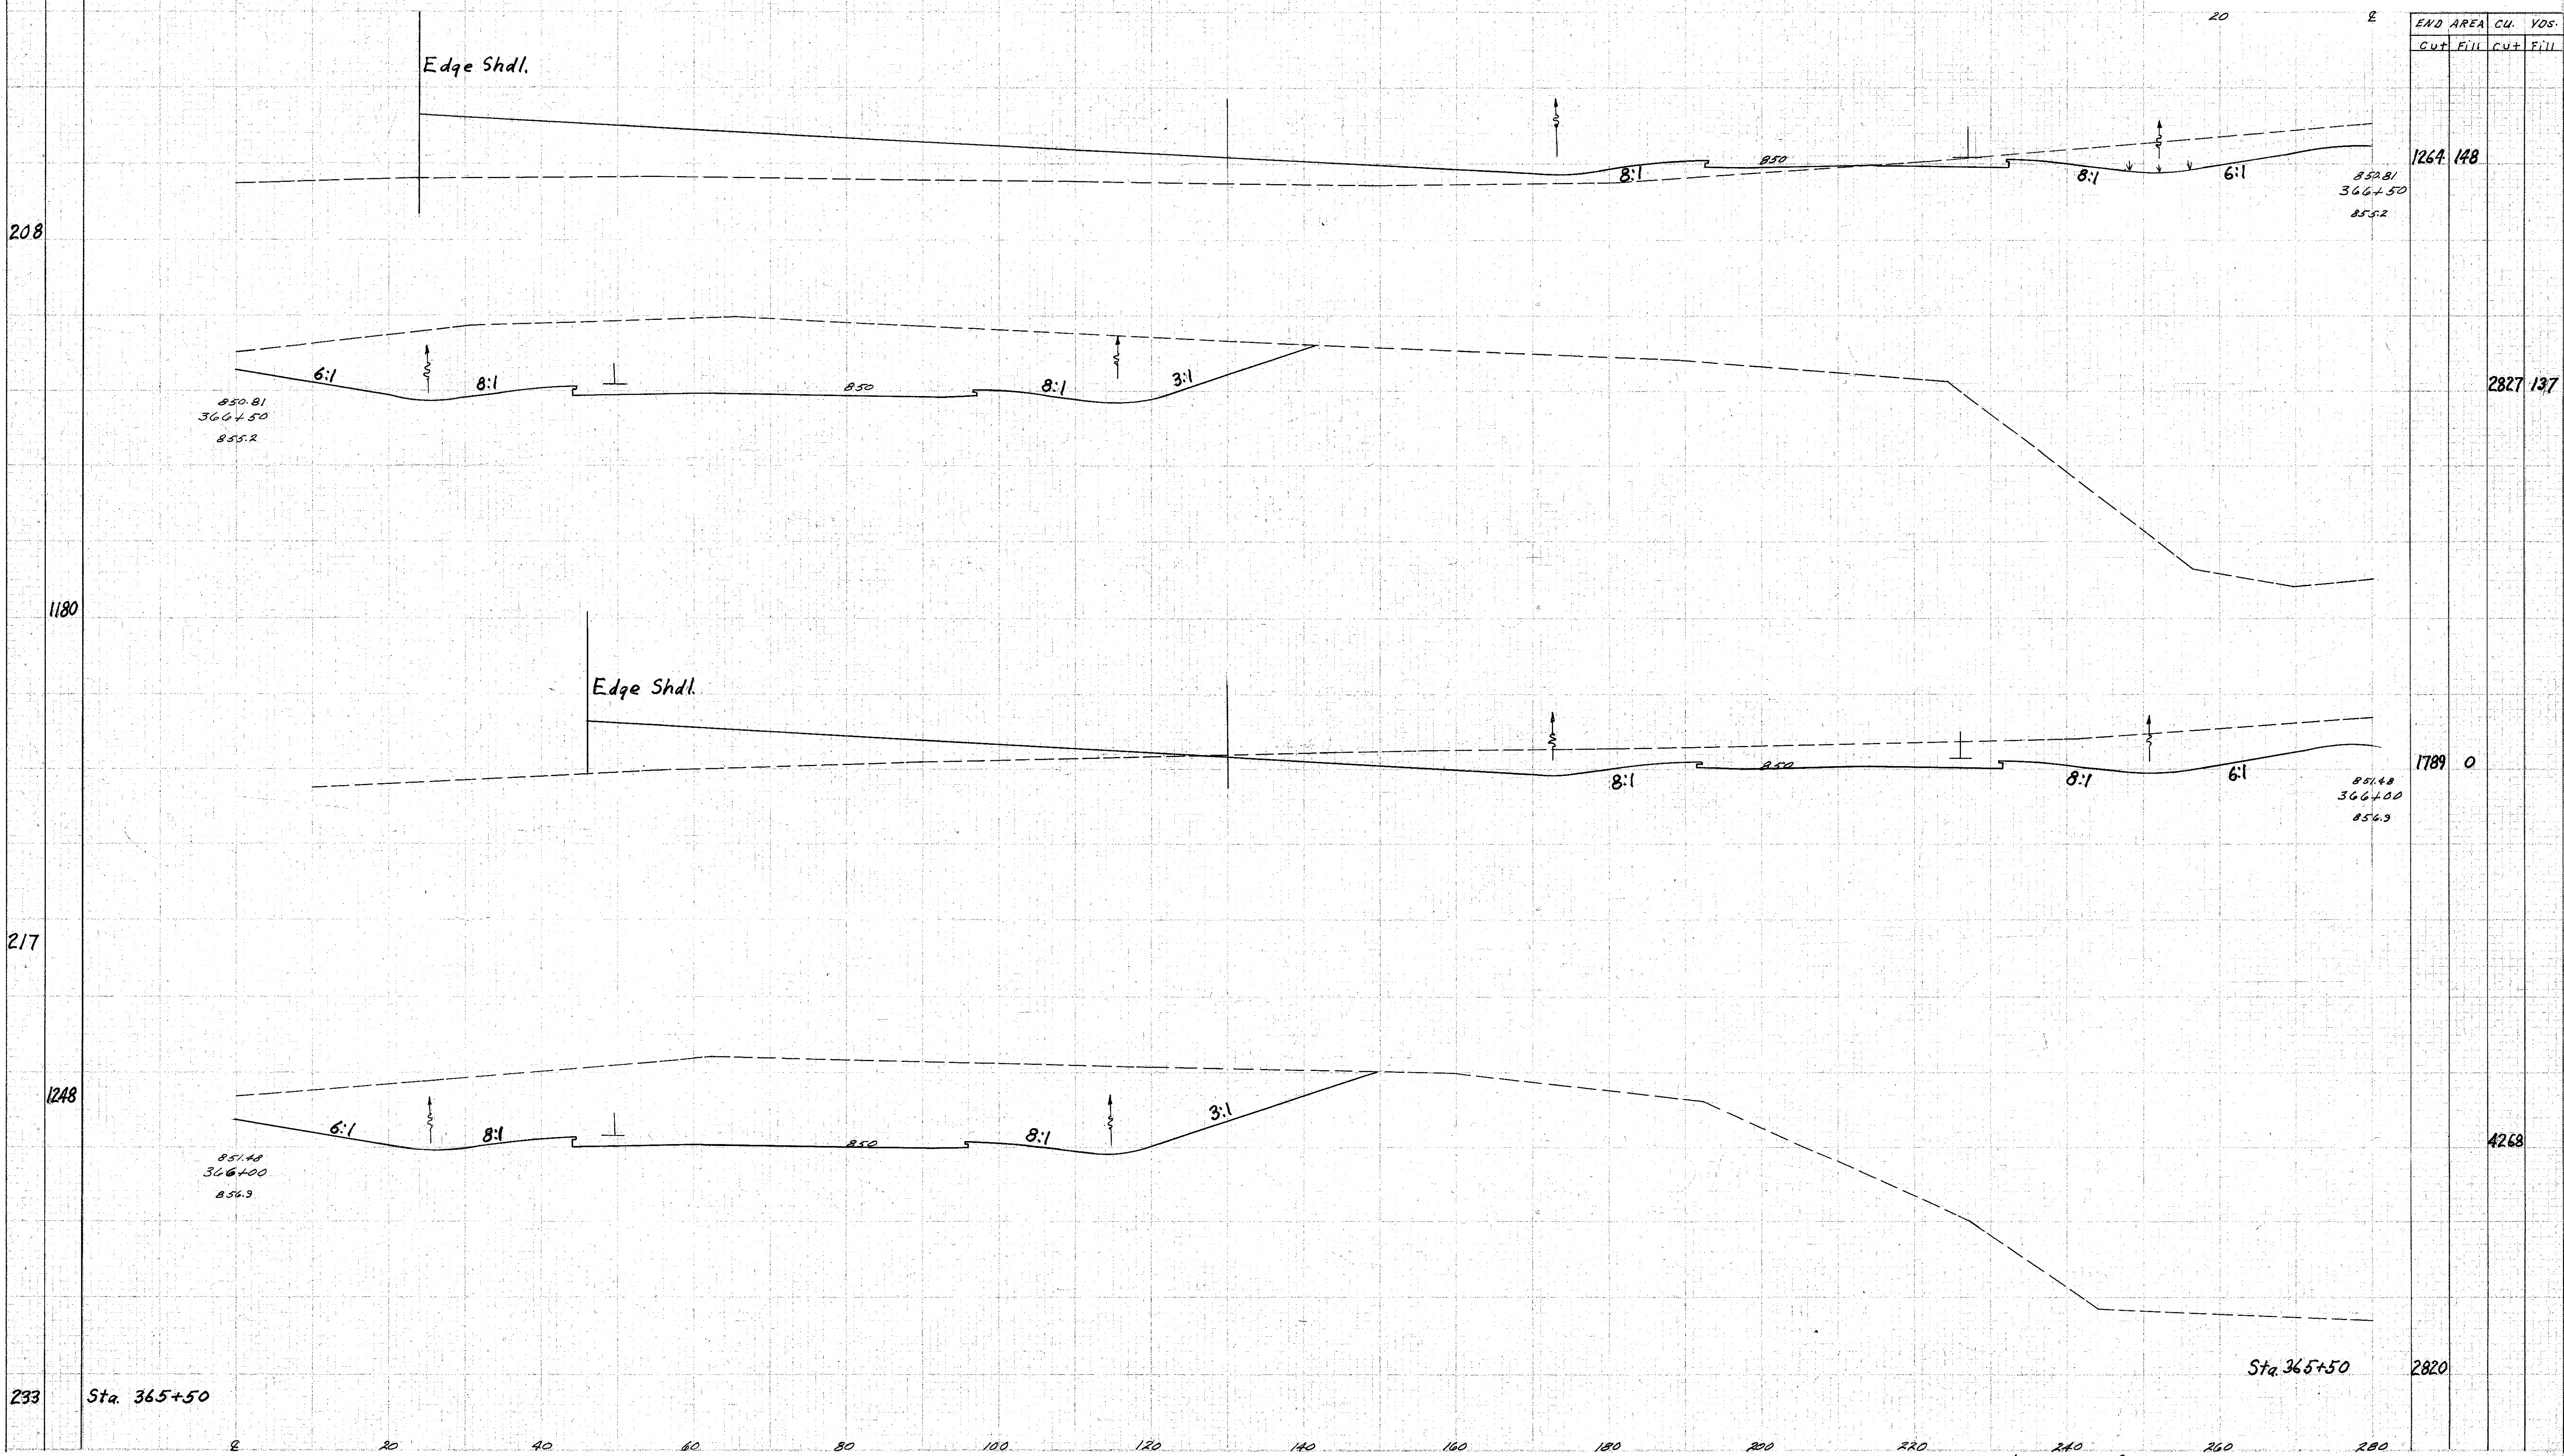

27 Oct. '58 *[Signature]* Sta. 366+00 TO 366+50