


SEEDING  
END STA  
488

FED. OR STATE PROJ.	STATE	PROJECT	FILE NO.
2	OHIO	ACI-1103 (21)	82 488

This sheet supersedes sheet no. 82 of the original plan.

LAKE COUNTY  
LAK-1-12.89

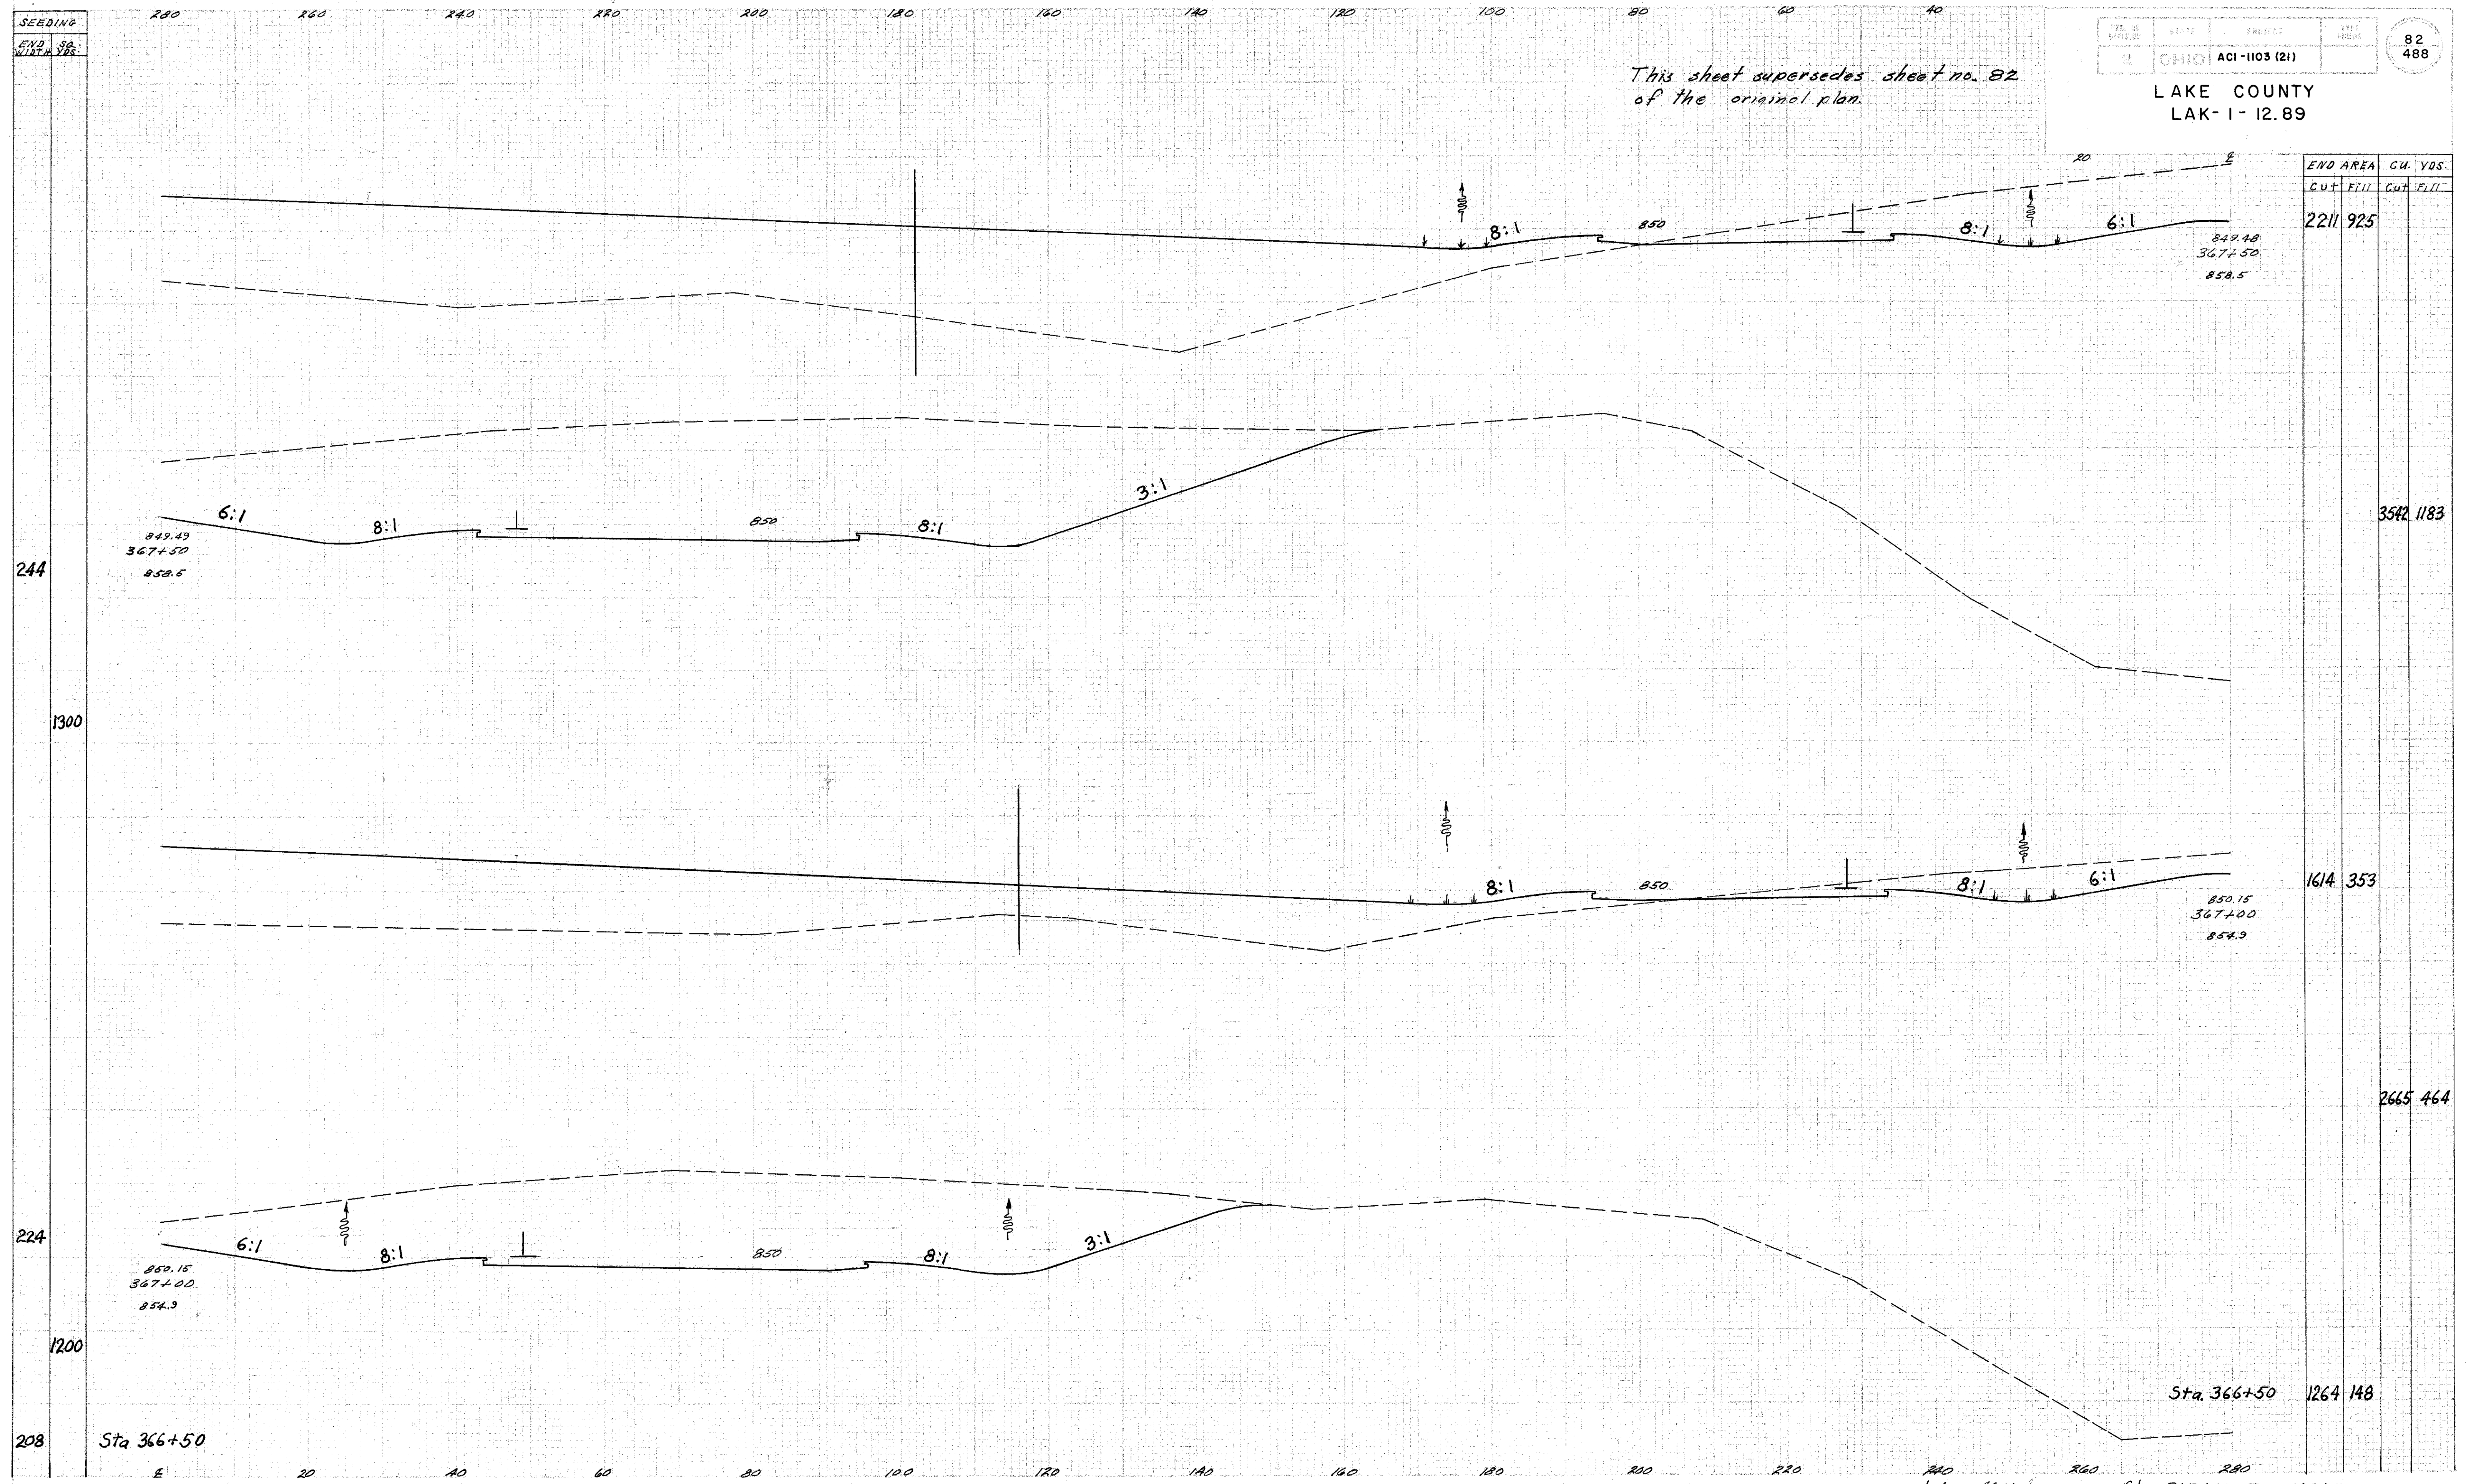

END AREA	CU. YDS.	
	CUT	FILL
2211	925	
1614	353	
1264	148	
3542	1183	
2665	464	

27 Oct. '58 G.H.L.  
Sta. 366+50 To 367+50