

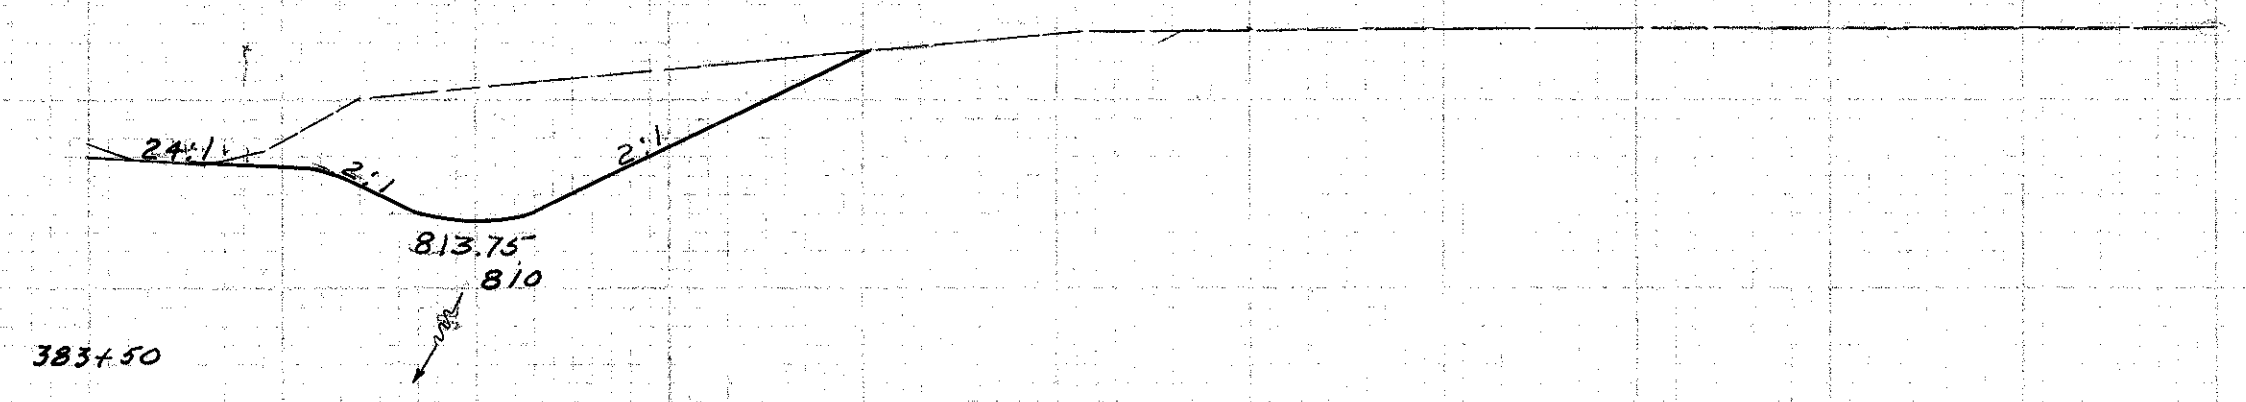
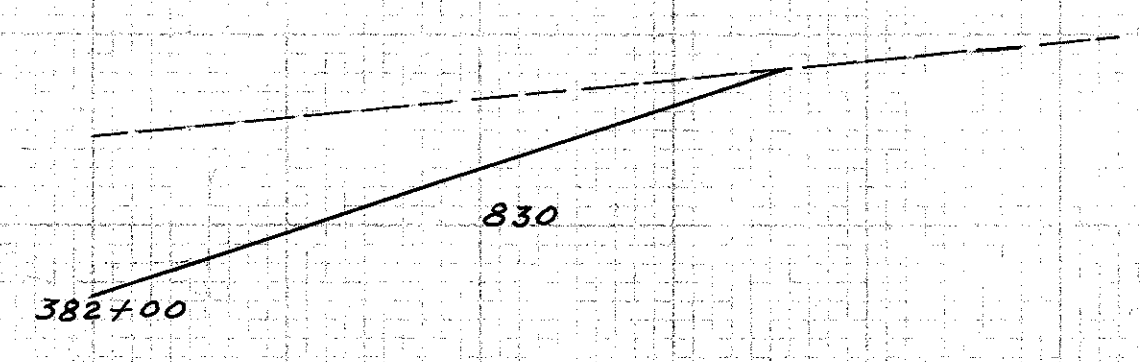


LAKE COUNTY
LAK-1-12.89

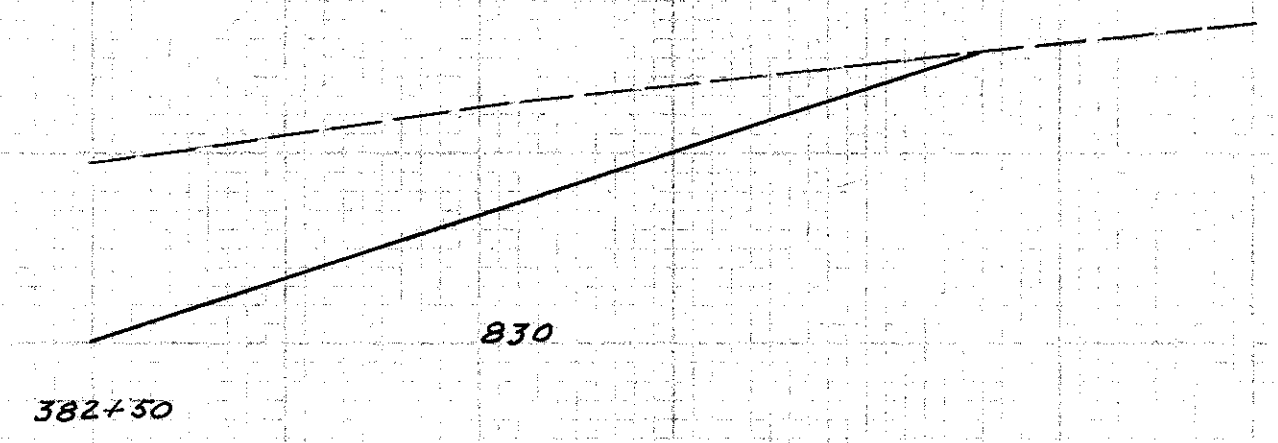

STA. 383+40
BEGIN CHANNEL
AREA

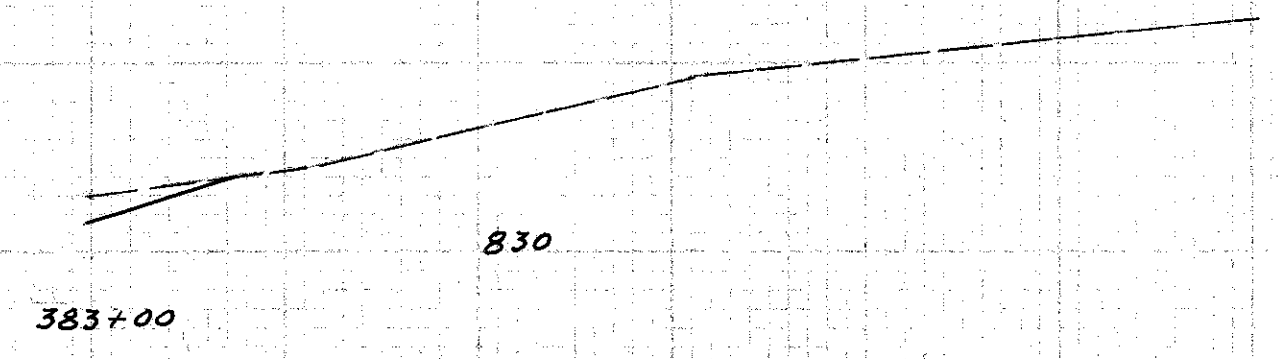

Revised 7-8-88
300-7-9-88