

SEEDING
WIDTH
YDS.


280 260 240 220 200 180 160 140 120 100 80 60 40

SECTION	STATE	PROJECT
2	OHIO	ACI-1103(21)

225
488

LAKE COUNTY
LAK-1-12.89

END AREA		CU. YDS.	
CUT	FILL	CUT	FILL

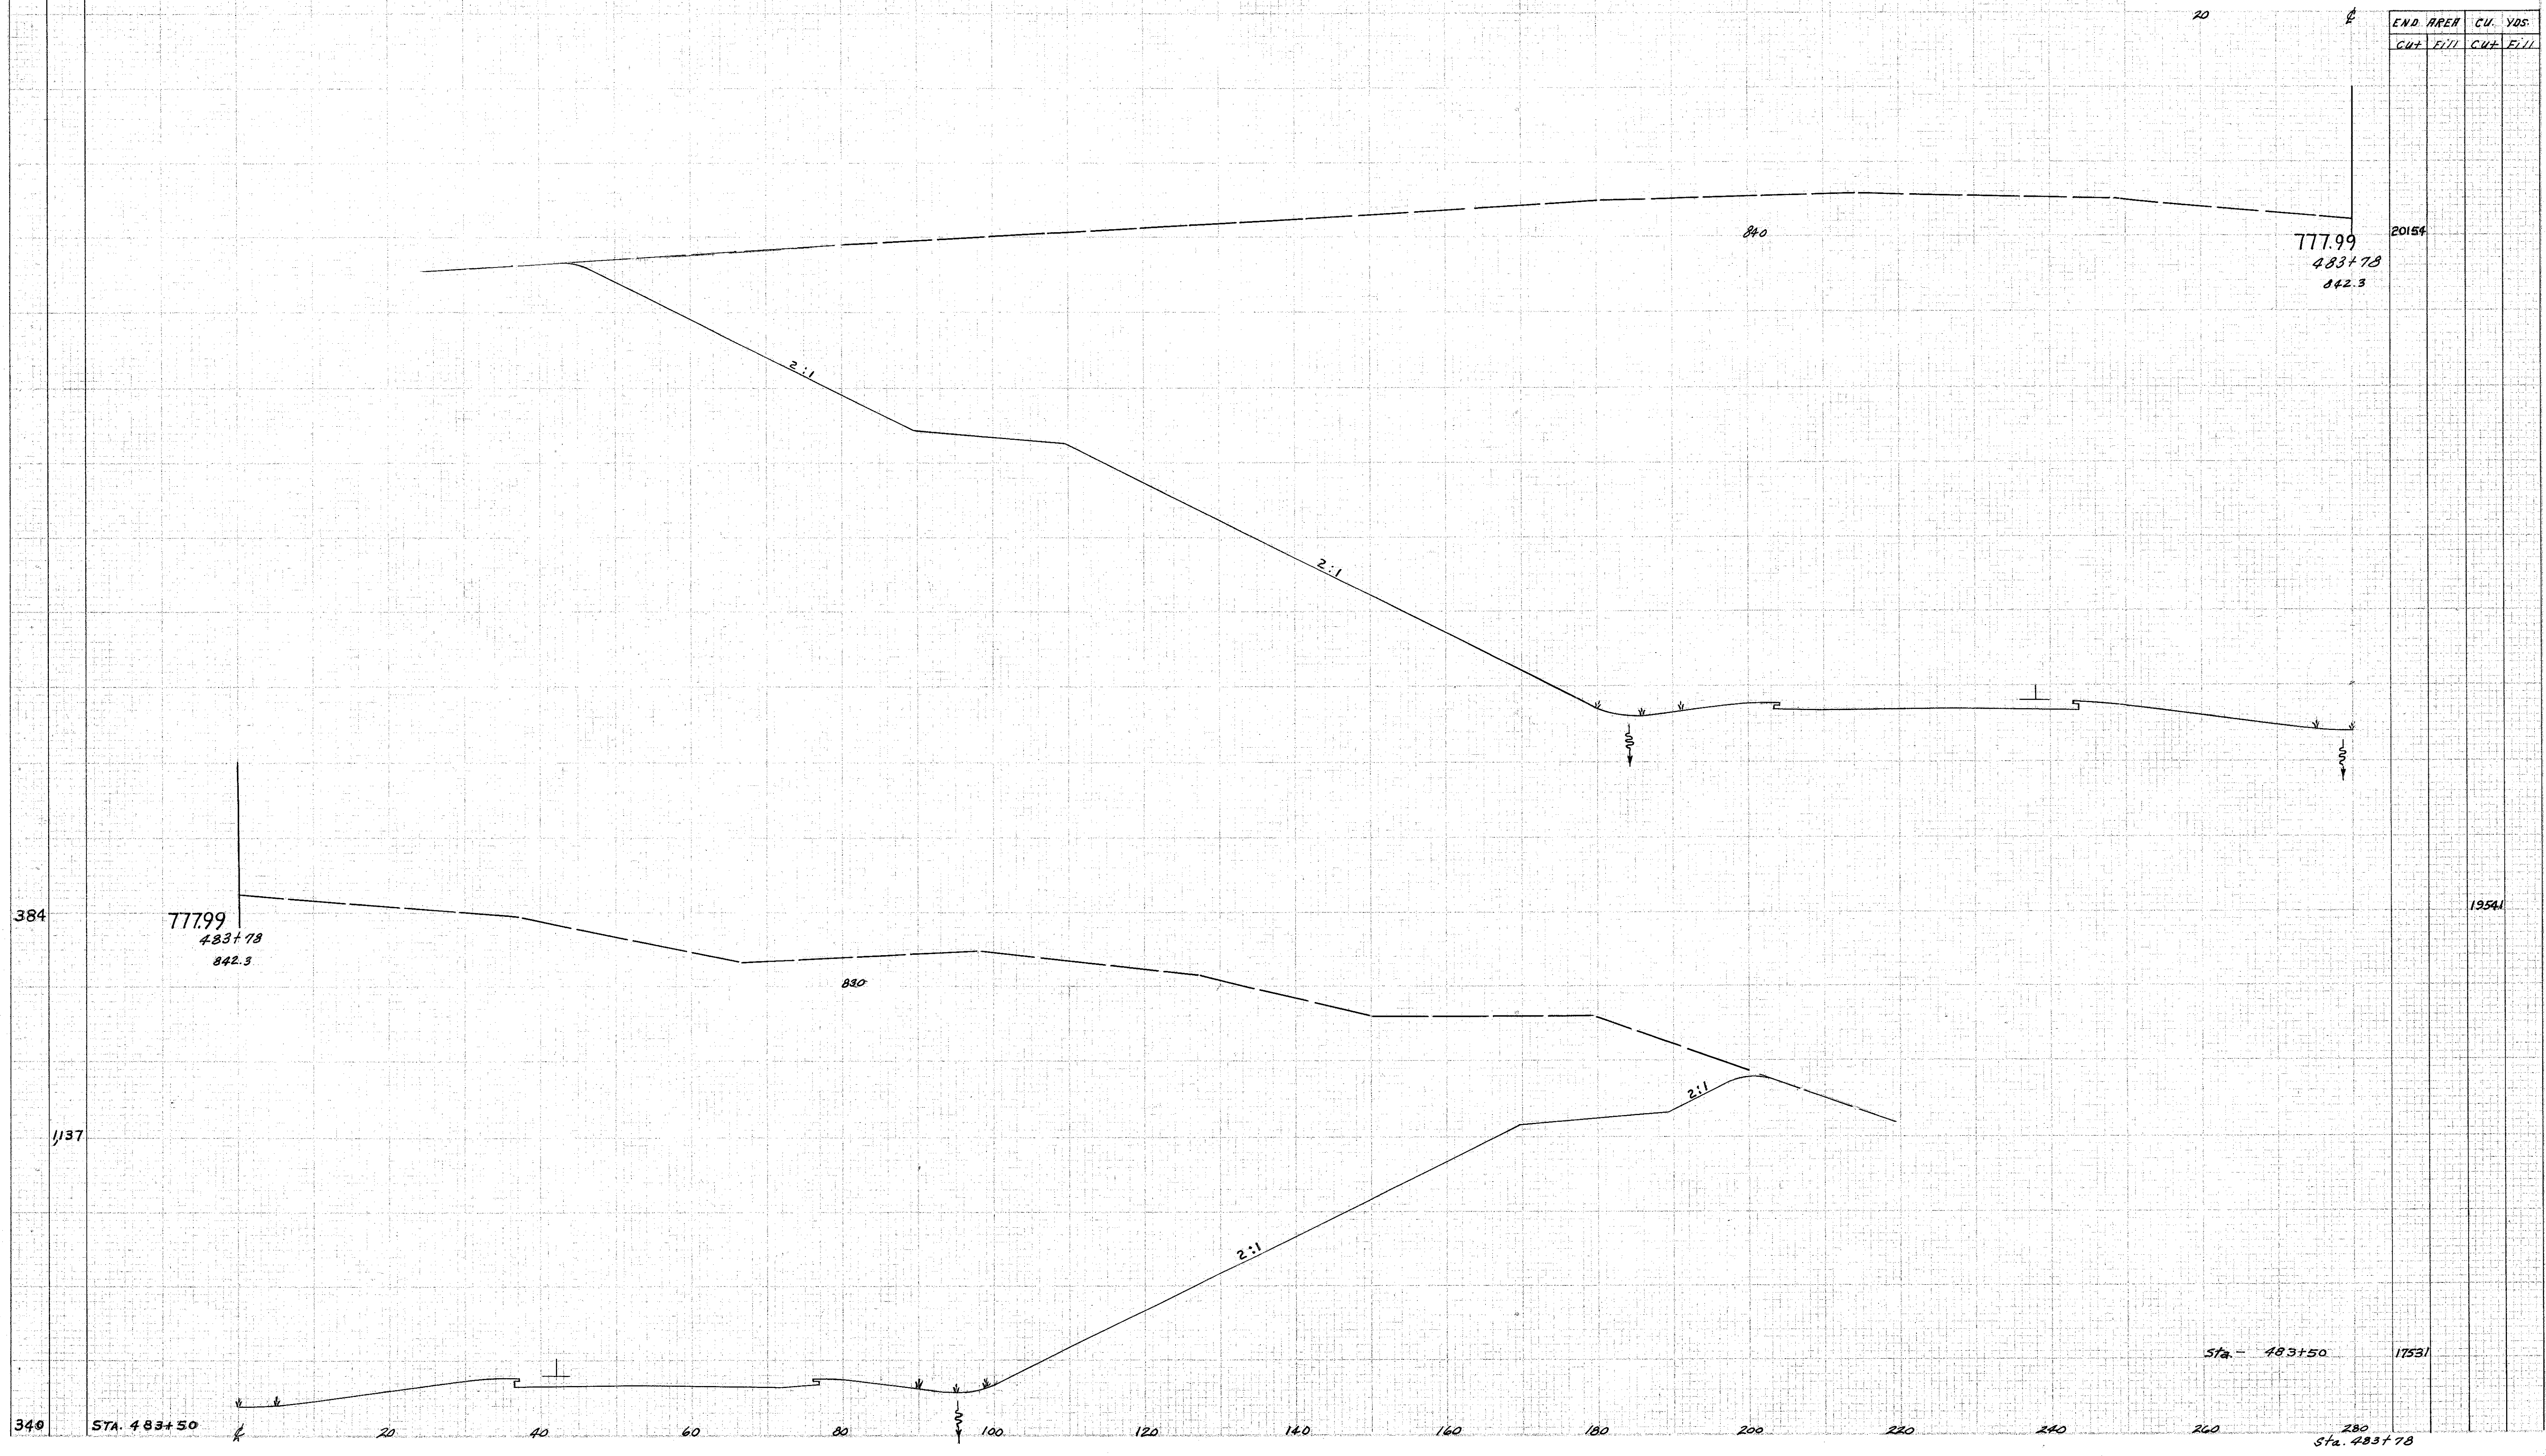

