


140 120 100 80 60 40 20 E 20 40 60 80 100

PROJECT	STATE	NO.	307
OHIO	ACI - 1103 (21)		488

This sheet supersedes sheet no. 307 of the original plan.

LAKE COUNTY  
LAK-1-12.89

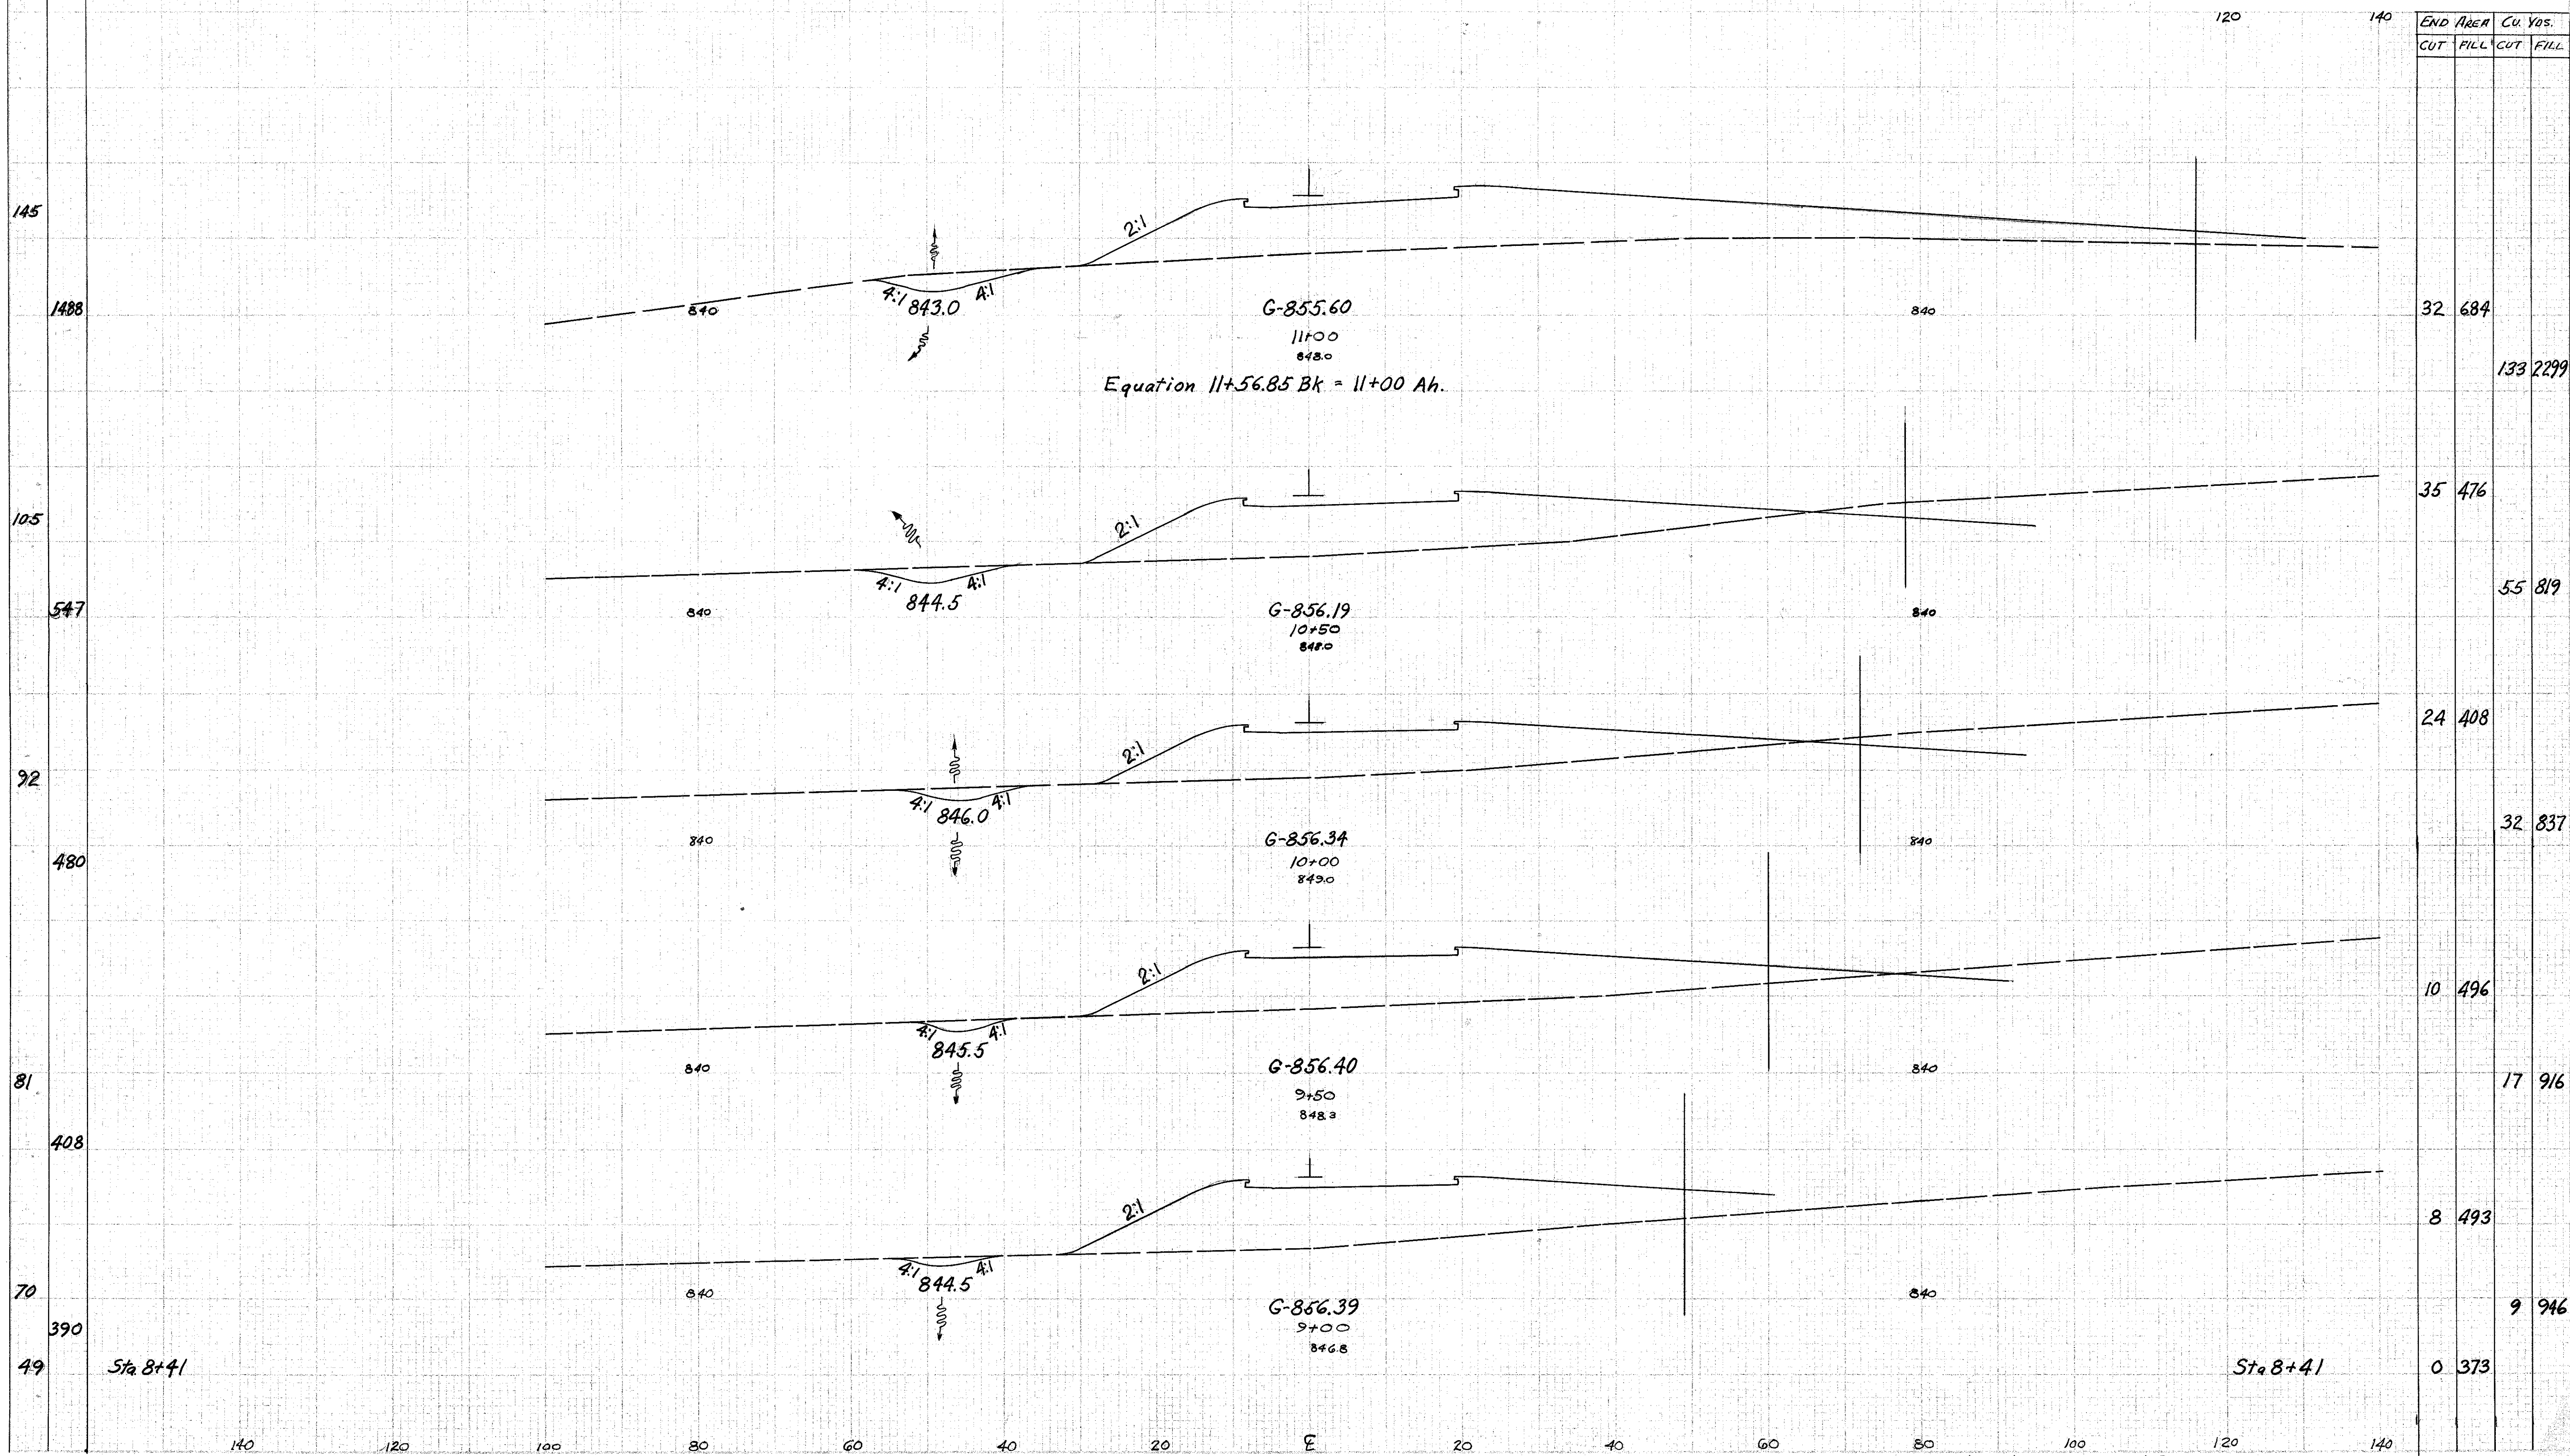

Equation  $11+56.85 Bk = 11+00 Ah$

G-855.60  
11+00  
848.0

G-856.19  
10+50  
848.0

G-856.34  
10+00  
849.0

G-856.40  
9+50  
848.3

G-856.39  
9+00  
846.8

Sta 8+41

Sta 8+41