



MICROFILMED  
DEC 10 1987


Intermediate Cross Frames  
3-1/2 3x3x5/8

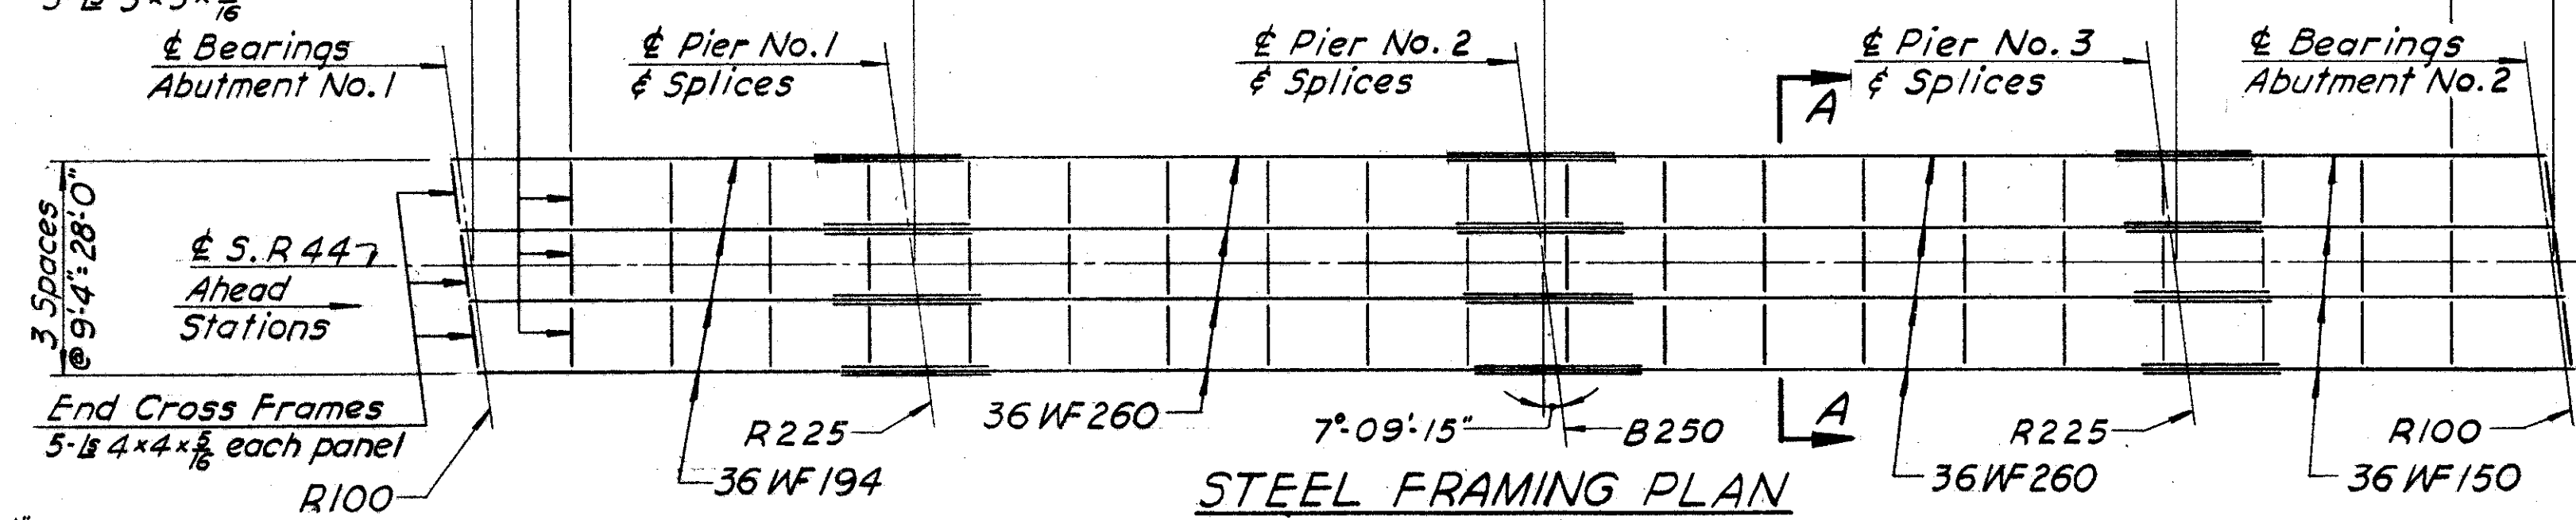

STEEL FRAMING PLAN

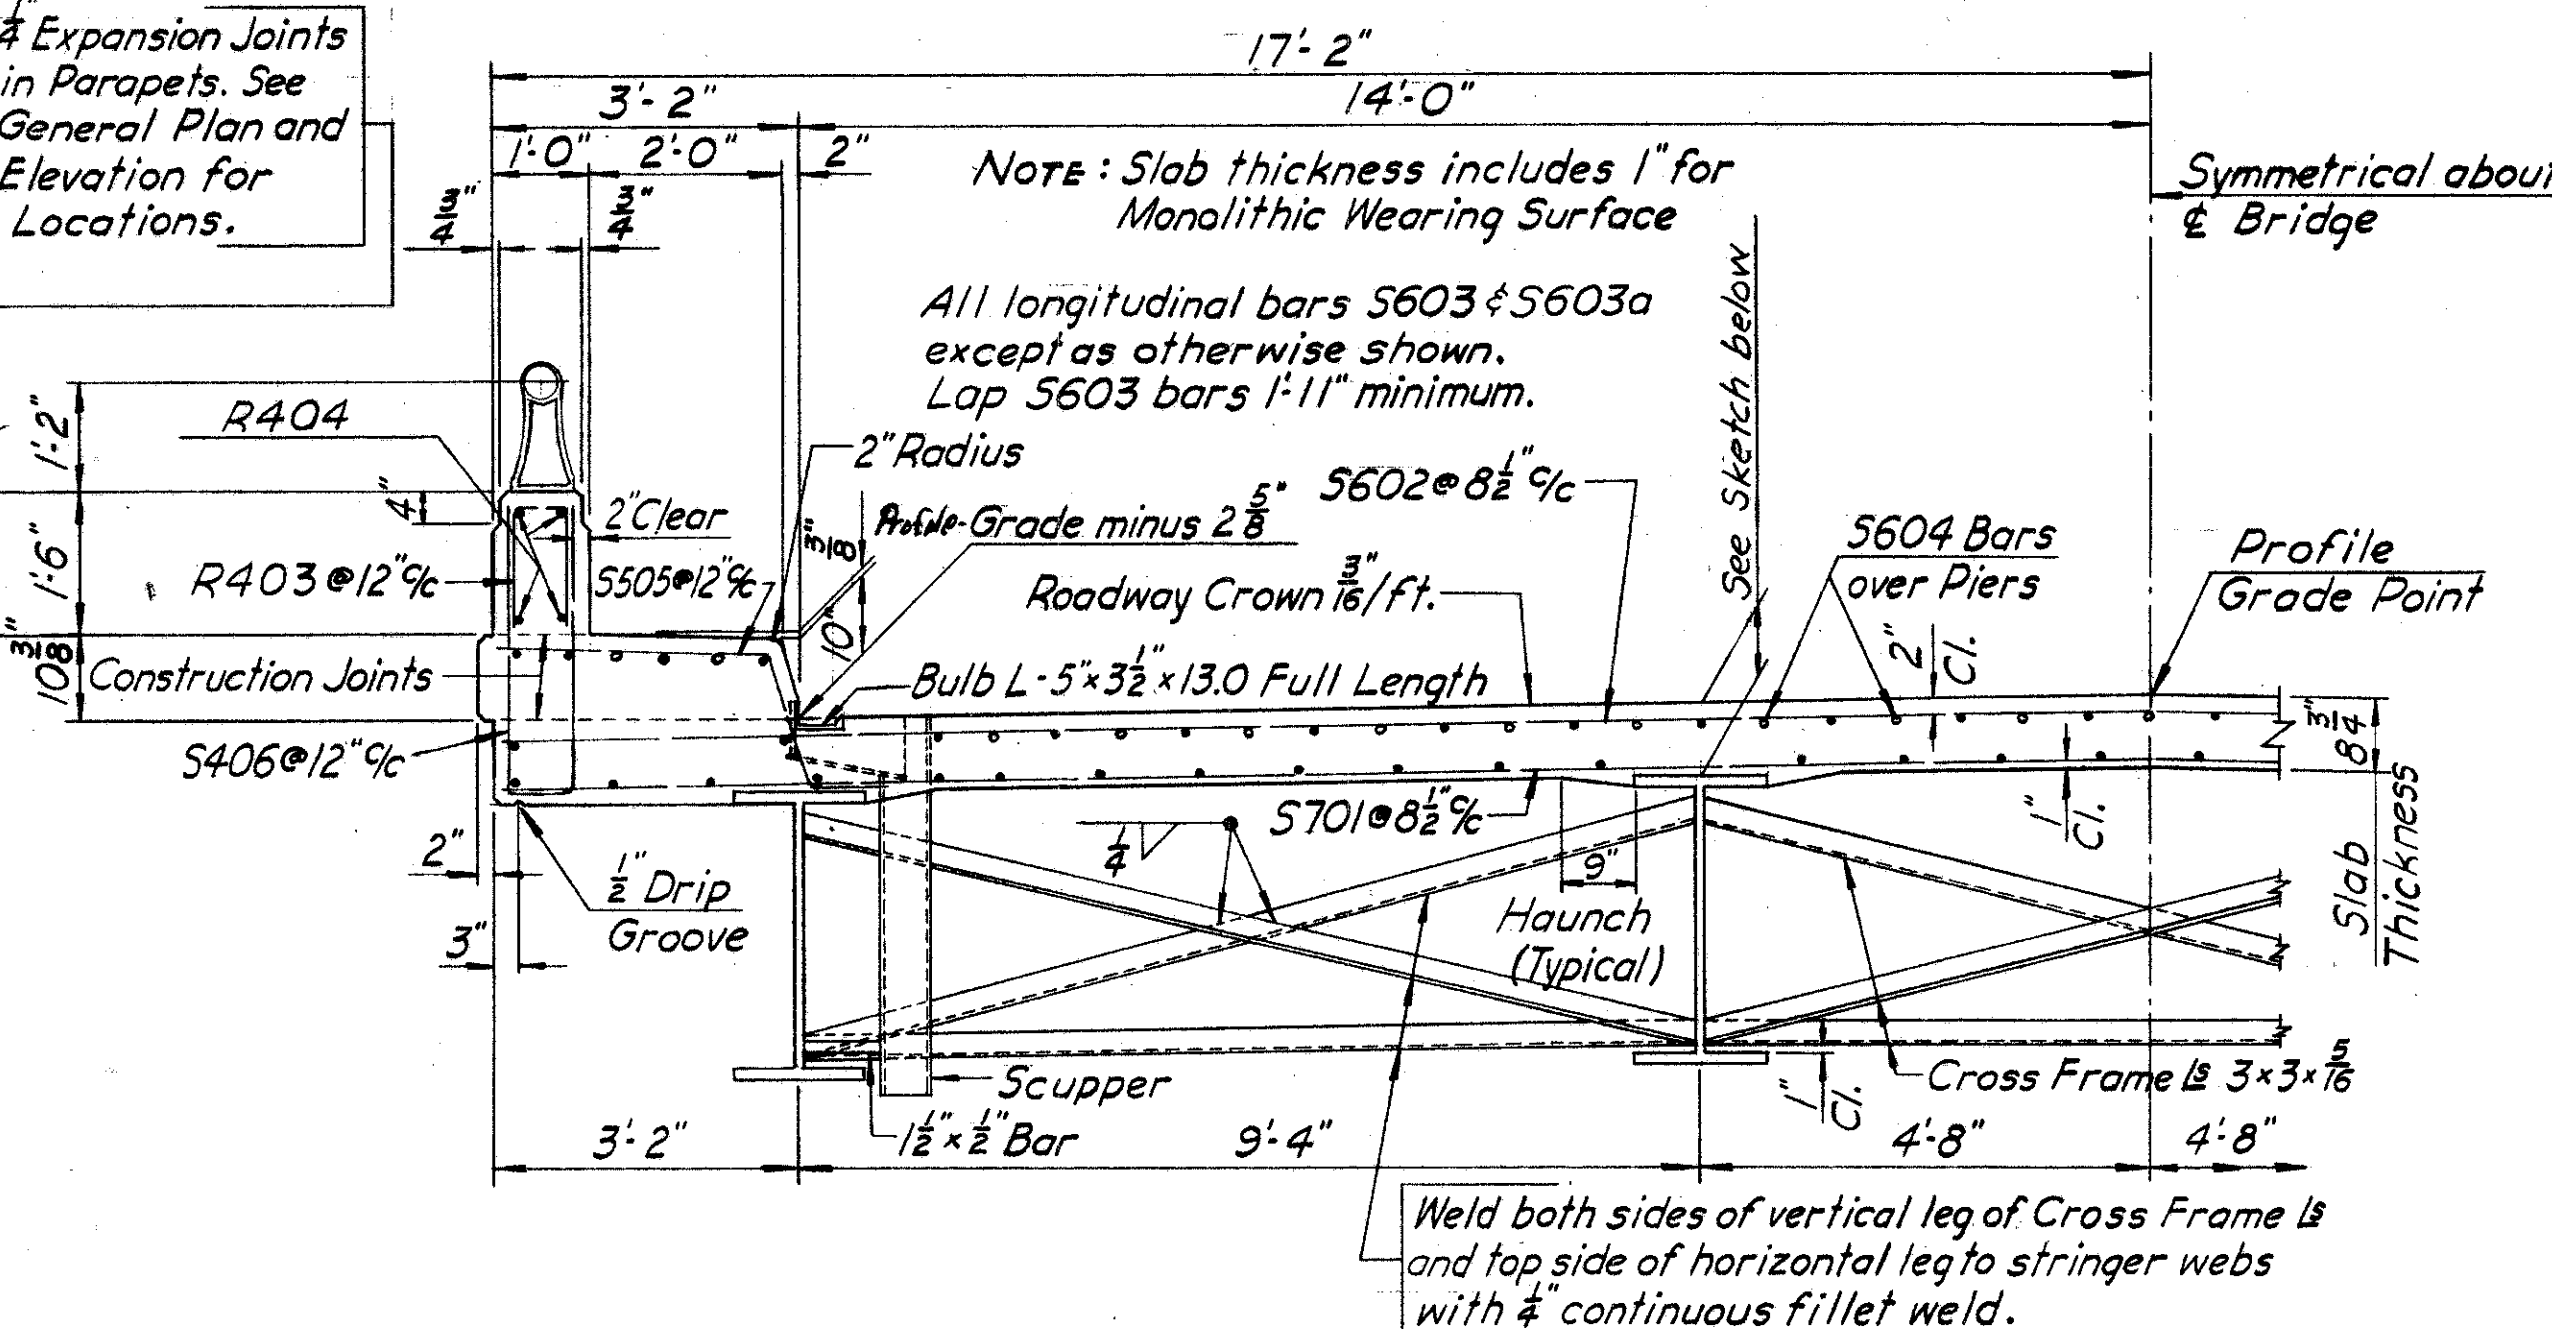


HALF SECTION A-A

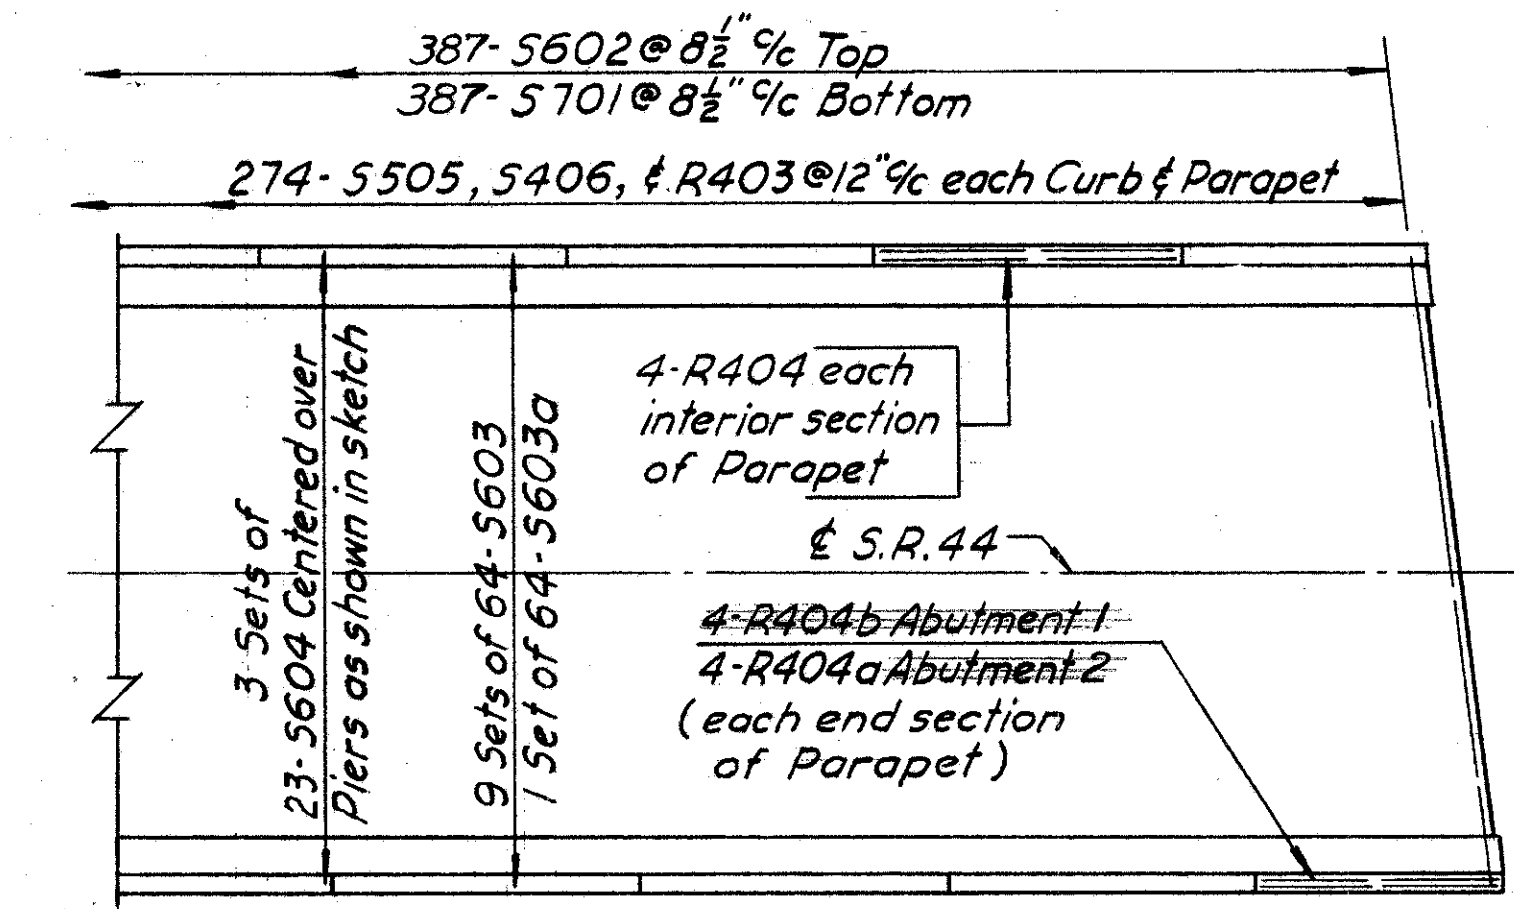


PART PLAN OF DECK  
(Other End Similar)

LOCATION	INSIDE BEAMS			OUTSIDE BEAMS		
	Span 1	Spans 2 & 3	Span 4	Span 1	Spans 2 & 3	Span 4
Deflection due to weight of steel	1/16"	1/8"	0	1/16"	1/8"	0
Deflection due to remaining Dead Load	1/4"	1/2"	1/8"	1/4"	1/2"	1/8"
Convexity required for Vertical Curve	1/16"	1/8"	5/16"	1/16"	1/8"	5/16"
Sum of Deflection and Convexity	3/4"	1 1/2"	7/16"	3/4"	1 1/2"	7/16"
Required Camber	1"	1 1/2"	0	1"	1 1/2"	0

DIAGRAM SHOWING STAGGER OF S604 BARS

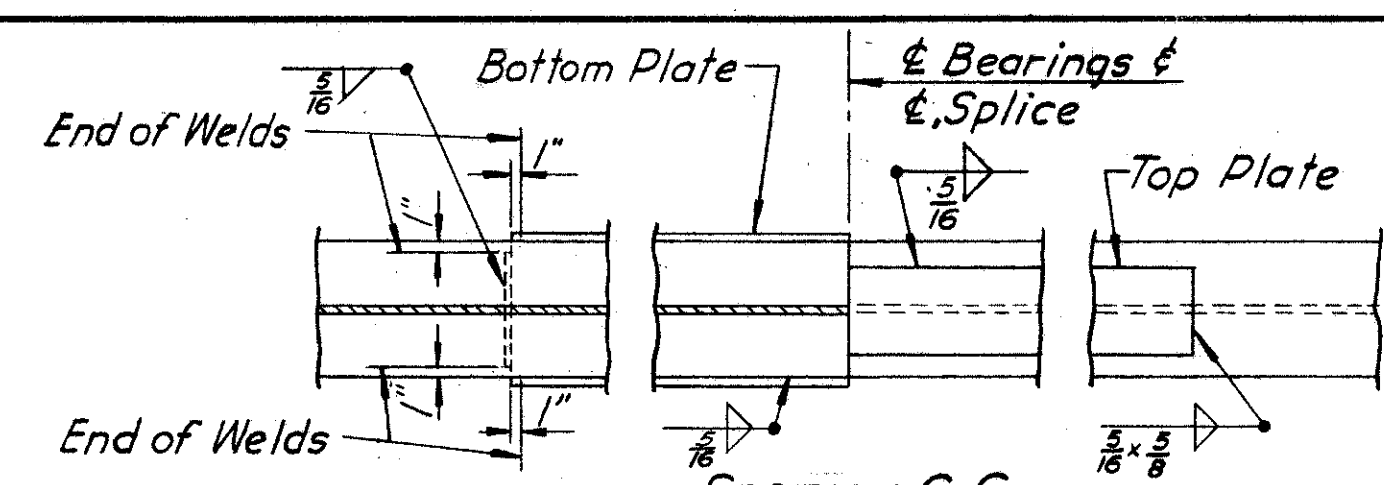

SPlice DETAILS AT PIER 2

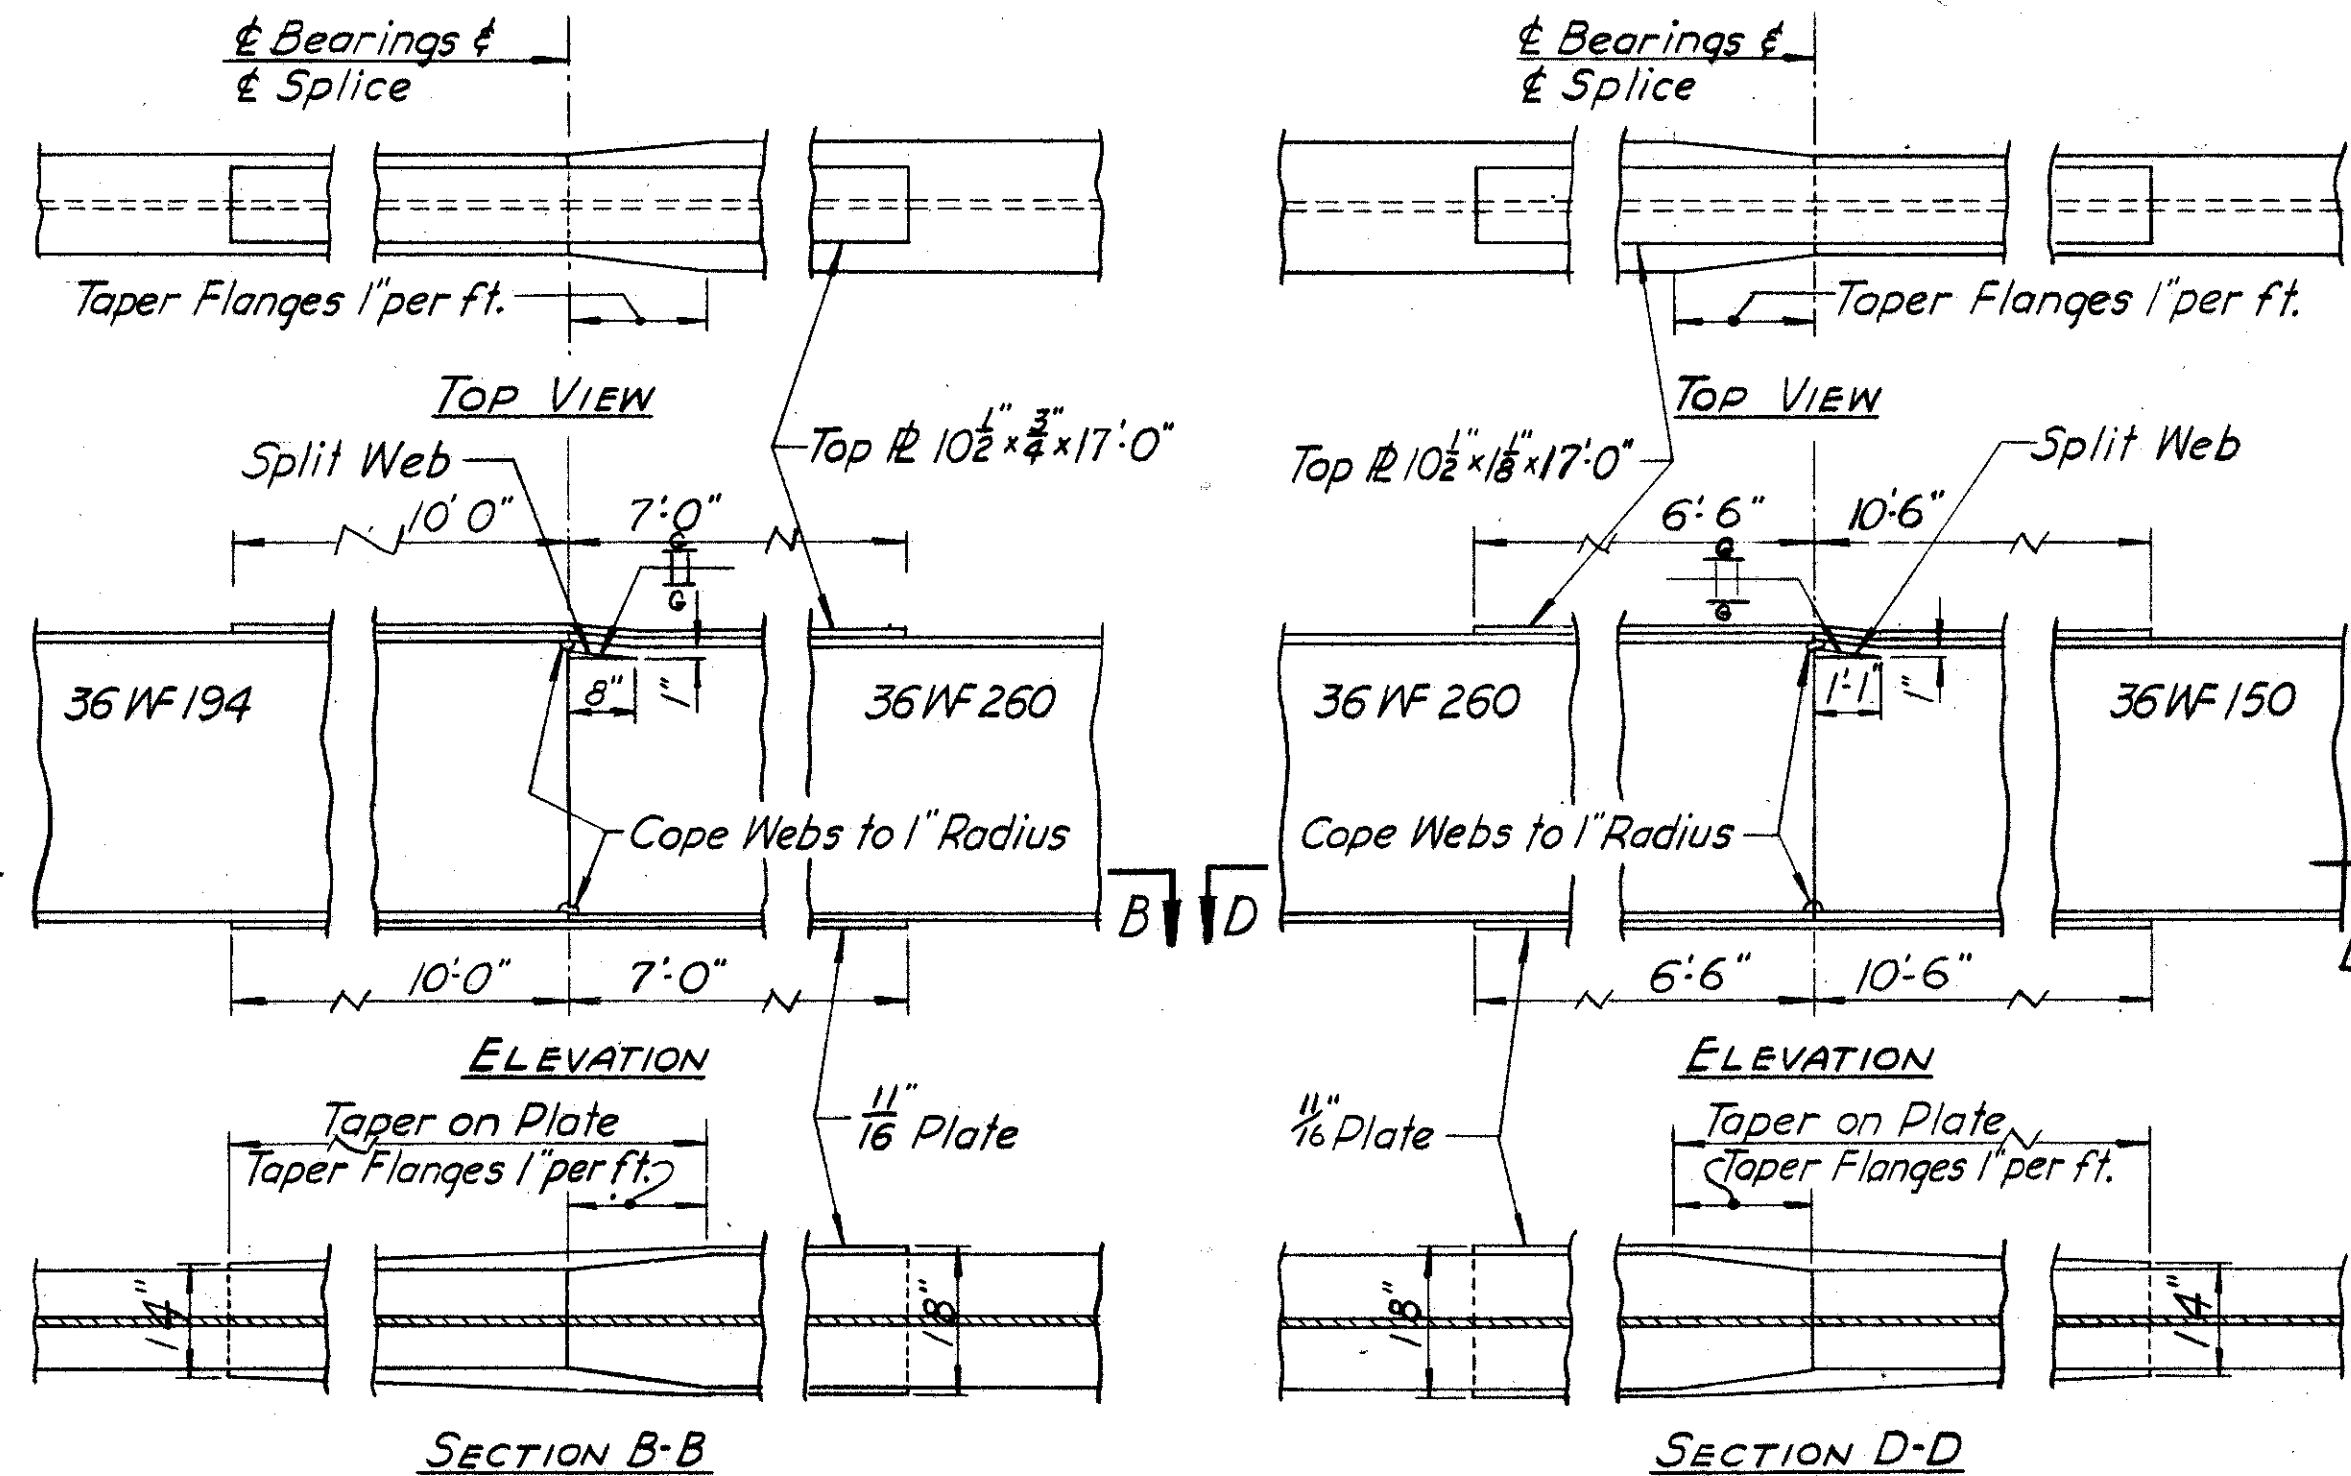

SPlice DETAILS AT PIER 1


All welds are similar to those for Splice Detail @ Pier 2.

Note for all Splices:

The butt welds on both faces of the top flange and web, and the upper face of the bottom flange shall be ground smooth.

SPlice DETAILS AT PIER 3

All welds are similar to those shown for Splice Detail @ Pier 2, except as shown.

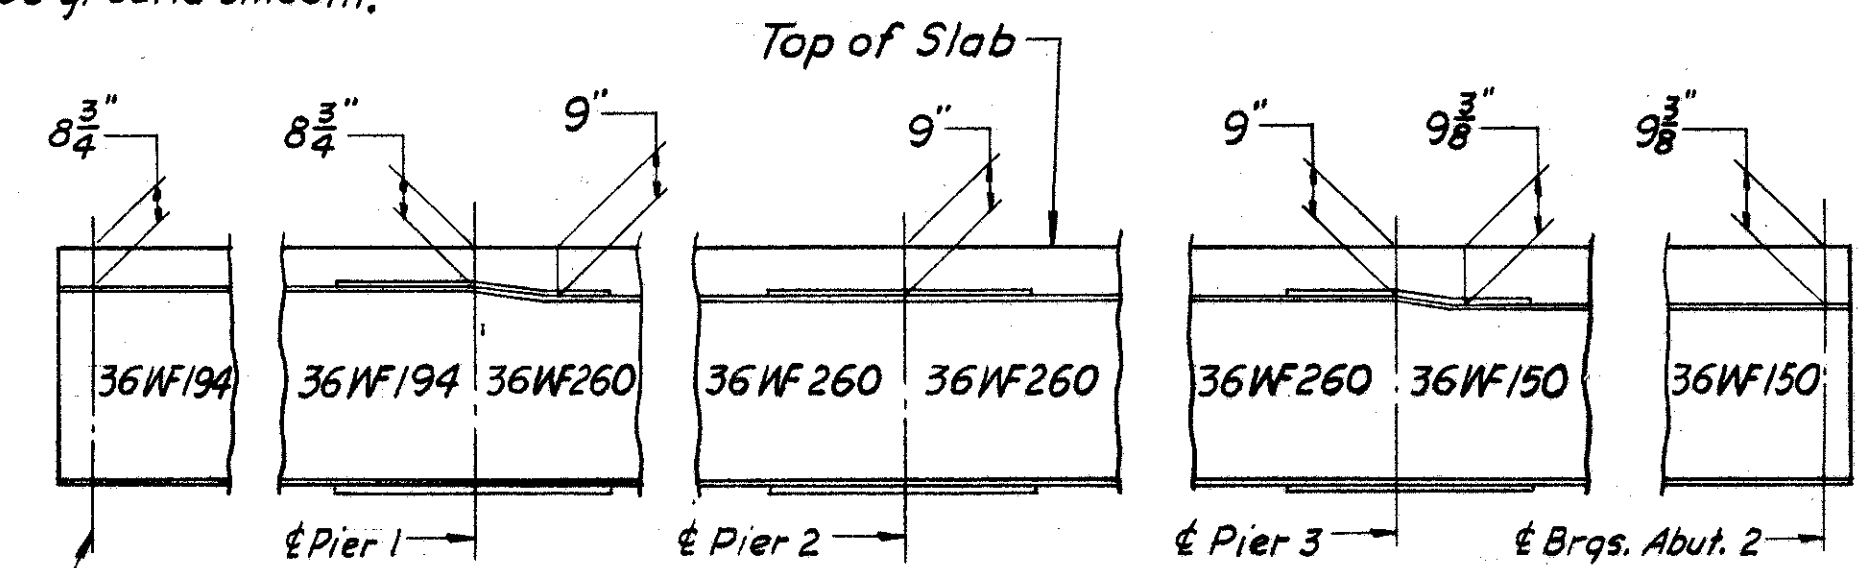

SKETCH SHOWING SLAB THICKNESSES OVER BEAMS AT BEARINGS

FED. RD. DIVISION	STATE	PROJECT	444
2	OHIO	ACI-1103 (21)	488

LAKE COUNTY  
SEC LAK-1-12.89

SUPERSTRUCTURE BAR LIST

MARK	No.	SIZE	LENGTH	TYPE	WEIGHT
S505	5701	387 7	34'-3"	Str.	27,093
S602	387 6	34'-3"	Str.	19,909	
S603	576 6	30'-0"	Str.	25,955	
S603a	64 6	22'-0"	Str.	2,115	
S604	69 6	33'-0"	Str.	3,420	
S505	548 5	4'-9"	Bent	2,715	
S406	548 4	5'-9"	Bent	2,105	
R403	548 4	2'-11"	Bent		
R404	120 4	15'-8"	Str.		Include with railing for payment
R404a	8 16 4	20'-7"	Str.		
R404b	8 4	12'-7"	Str.		
					TOTAL WEIGHT 83,312

NOTES

- REFERENCE shall be made to Standard Drawing CSB-2-56, sheets 1-3 of 6, revised 3-1-58, for details of end dams, gutters, scuppers, pipe drains and curb plates and deck placing procedure.
- REFERENCE shall be made to Standard Drawing RB-1-53, dated 3-1-55, for details of rockers and bolsters.
- REFERENCE shall be made to Standard Drawing AR-1-57, revised 3-1-58, for aluminum railing type "A" and concrete parapet details.
- WELDED STEEL: The steel for the 36WF194 and the 36WF260 beams shall conform to ASTM Designation A-373. All other structural steel shall conform to either ASTM A-7 (as per Sec. M-7.4 (a) of the Construction and Material Specifications) or to A-373.
- WELDING of structural steel shall be Class "A" except as otherwise shown. Welds shown as field welds may, at the option of the Contractor, be made in the shop.

- Concrete and reinforcing steel above parapet construction joint included with railing for payment.
- All concrete shall be class "C".
- BEAM SPLICE WELDING PROCEDURE:
  - Raise end of beam at Pier 2-2 1/4"
  - Butt weld Beam Flanges and Webs at Pier 1 using the following procedure: make one pass on each flange, then one on the web, and repeat until welds are completed.
  - Weld top and bottom moment plates at Pier 1.
  - Lower end of beam at Pier 2.
  - Make splices of Piers 2 and 3 in the same manner, raising the ends of the beams 2 1/2" at Pier 3 and 1/4" at Abutment 2.

SEC. C-32 FED. AID PROJ. NO. ACI-1103 (21)

PREPARED BY  
CAPITOL ENGINEERING ASSOCIATES, DILLSBURG, PA.  
FOR

STATE OF OHIO  
DEPARTMENT OF HIGHWAYS

DECK DETAILS  
BRIDGE NO. LAK-1-1493  
S.R. 1 UNDER EXIST. S.R. 44  
LAKE COUNTY  
STA. 434 + 5538

DESIGNED	DRAWN	TRACED	CHECKED	REVISED DATE	REVISED
JJM	C		S	2-13-59	

REV. 2-13-59