


SEEDING
FOOT
SS

FILE NO.	STATE	PROJECT
2	OHIO	PCI-1103(27)

129
413

LAKE COUNTY
LAK-1-16-55

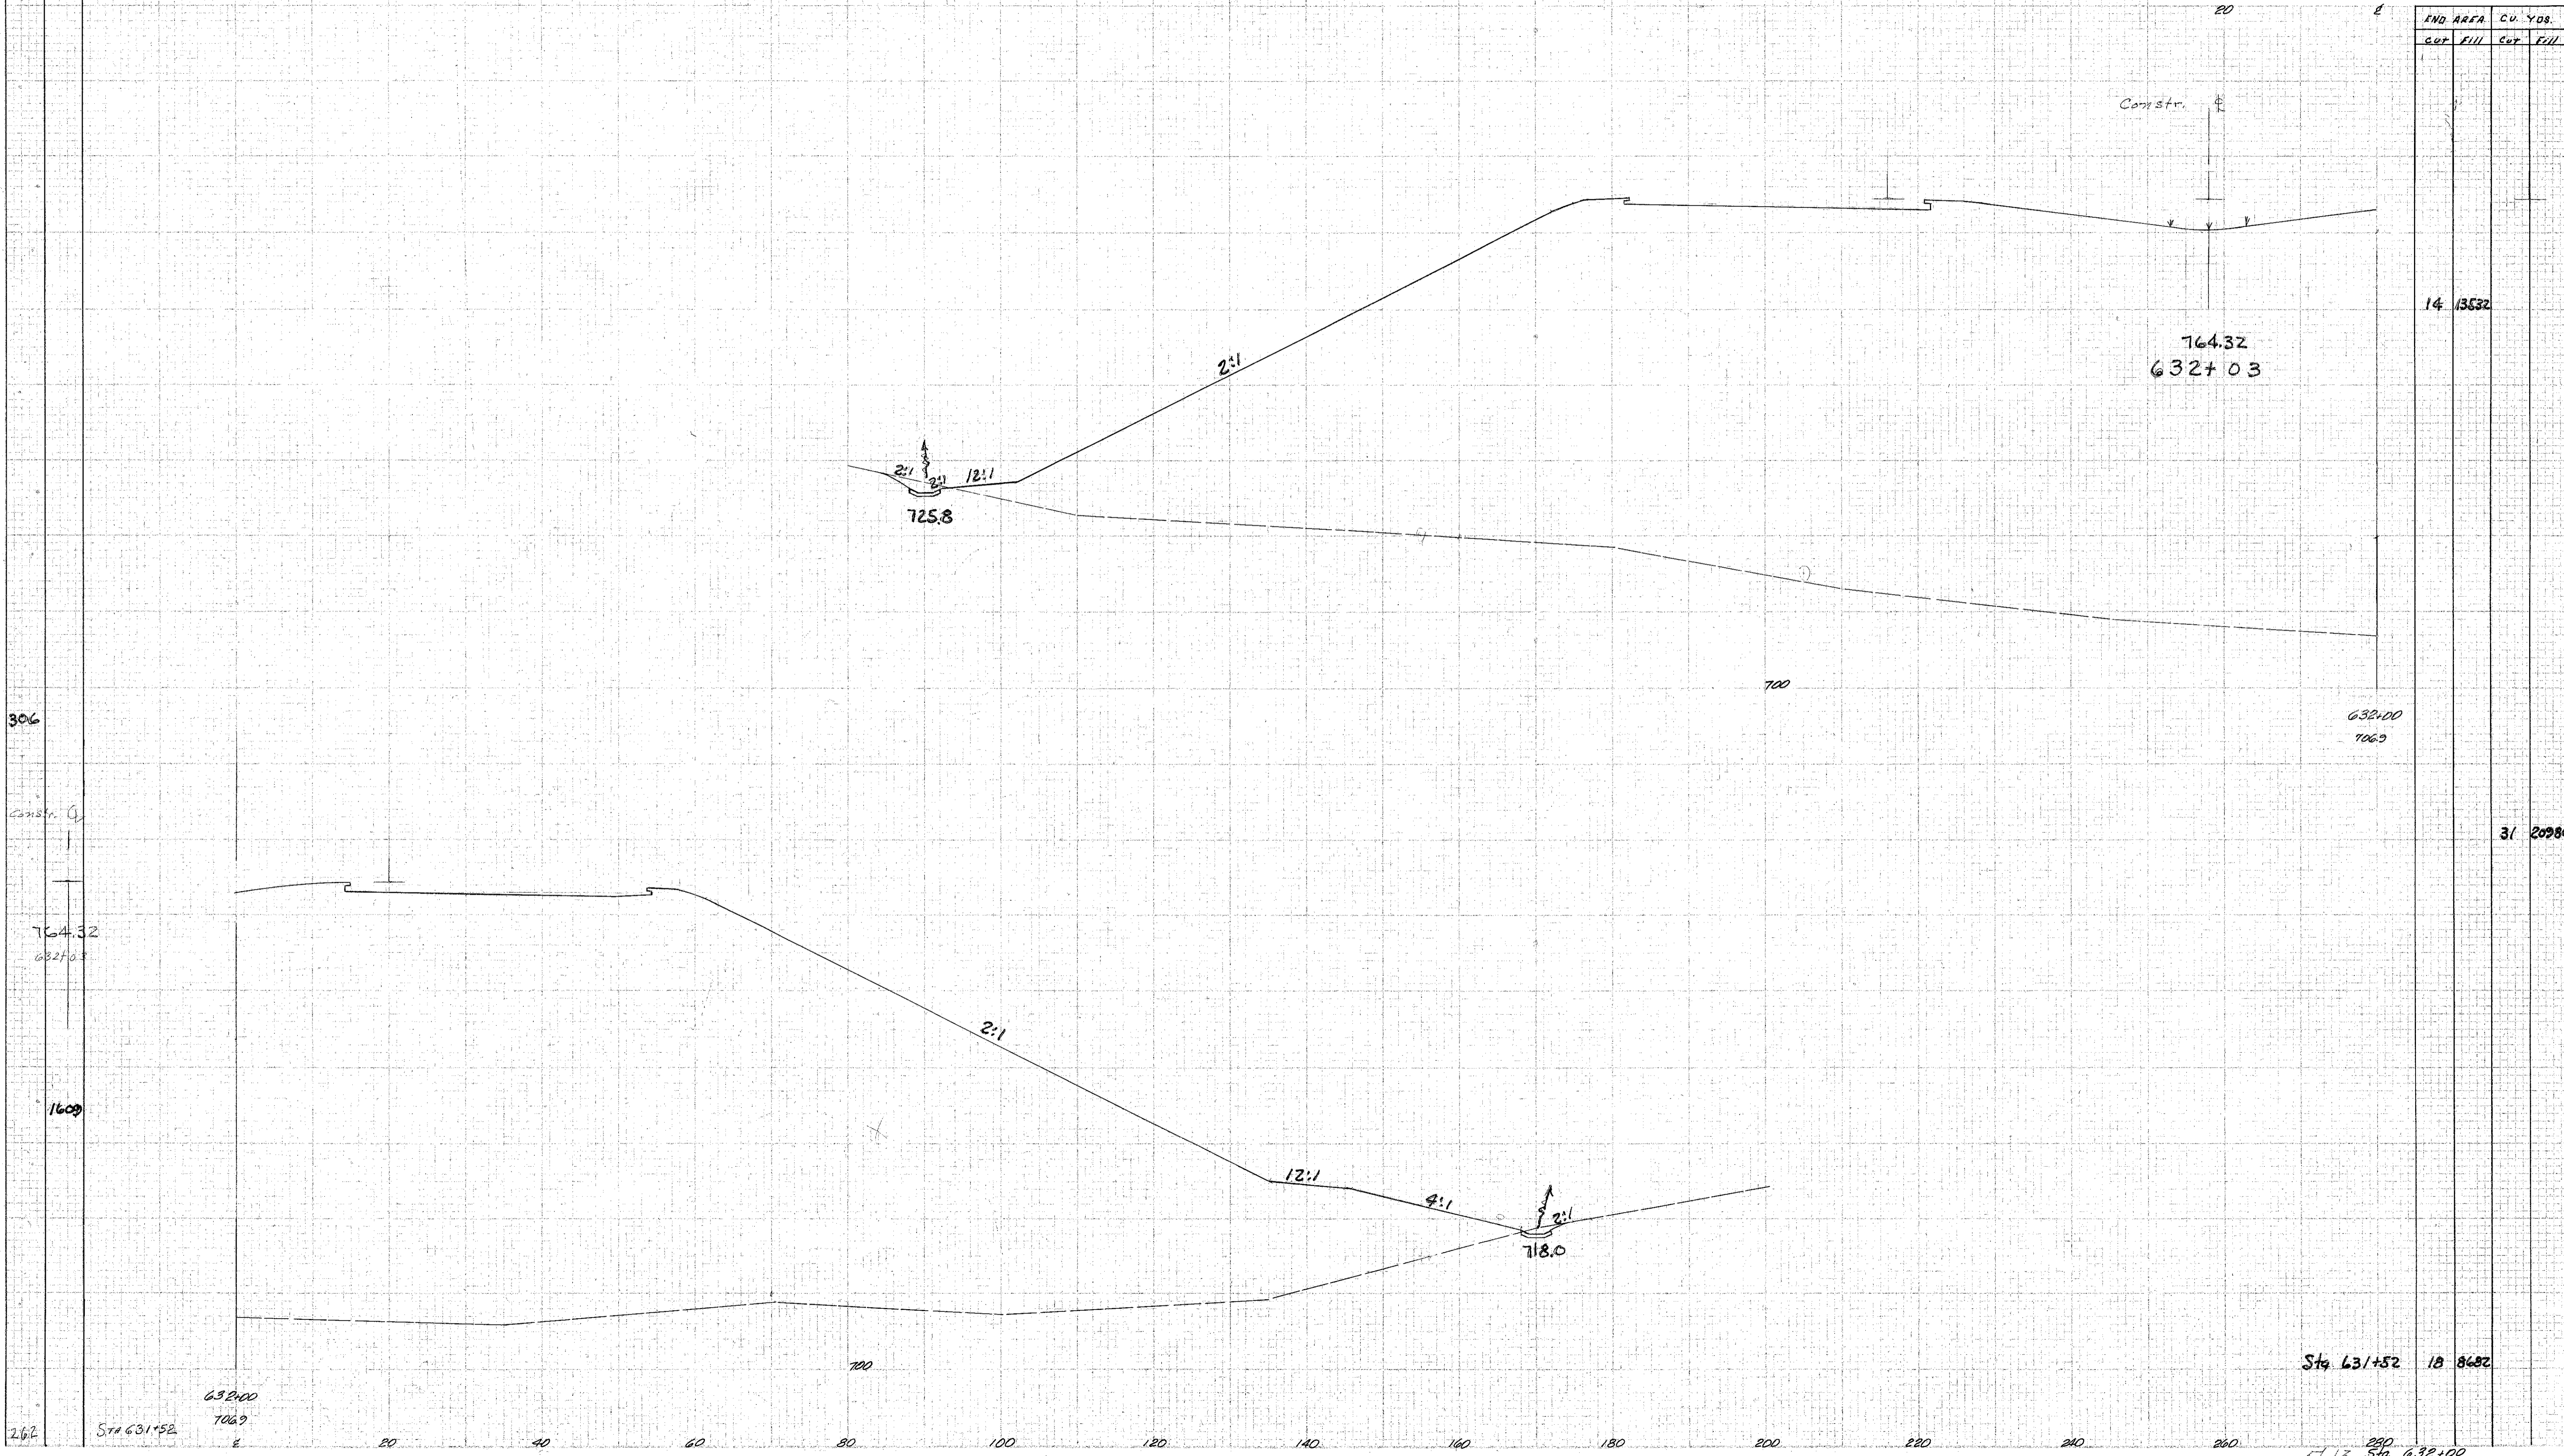

END AREA		CU. YDS.	
Cut	Fill	Cut	Fill

				14	13532
				31	20980
				18	8682

As per AS 3-4-58
← AS 3-4-58

Sta 63+52 18 8682

5613 280
Sta 632+00