


SEEDING
EWD SO.
WIDTH YDS.

FED. RD. DISTRICT	STATE	PROJECT
2	OHIO	PCI-1103 (27)

182
413

LAKE COUNTY
LA K-1-16.55

END AREA	CU. YDS.
CUT FILL	CUT FILL

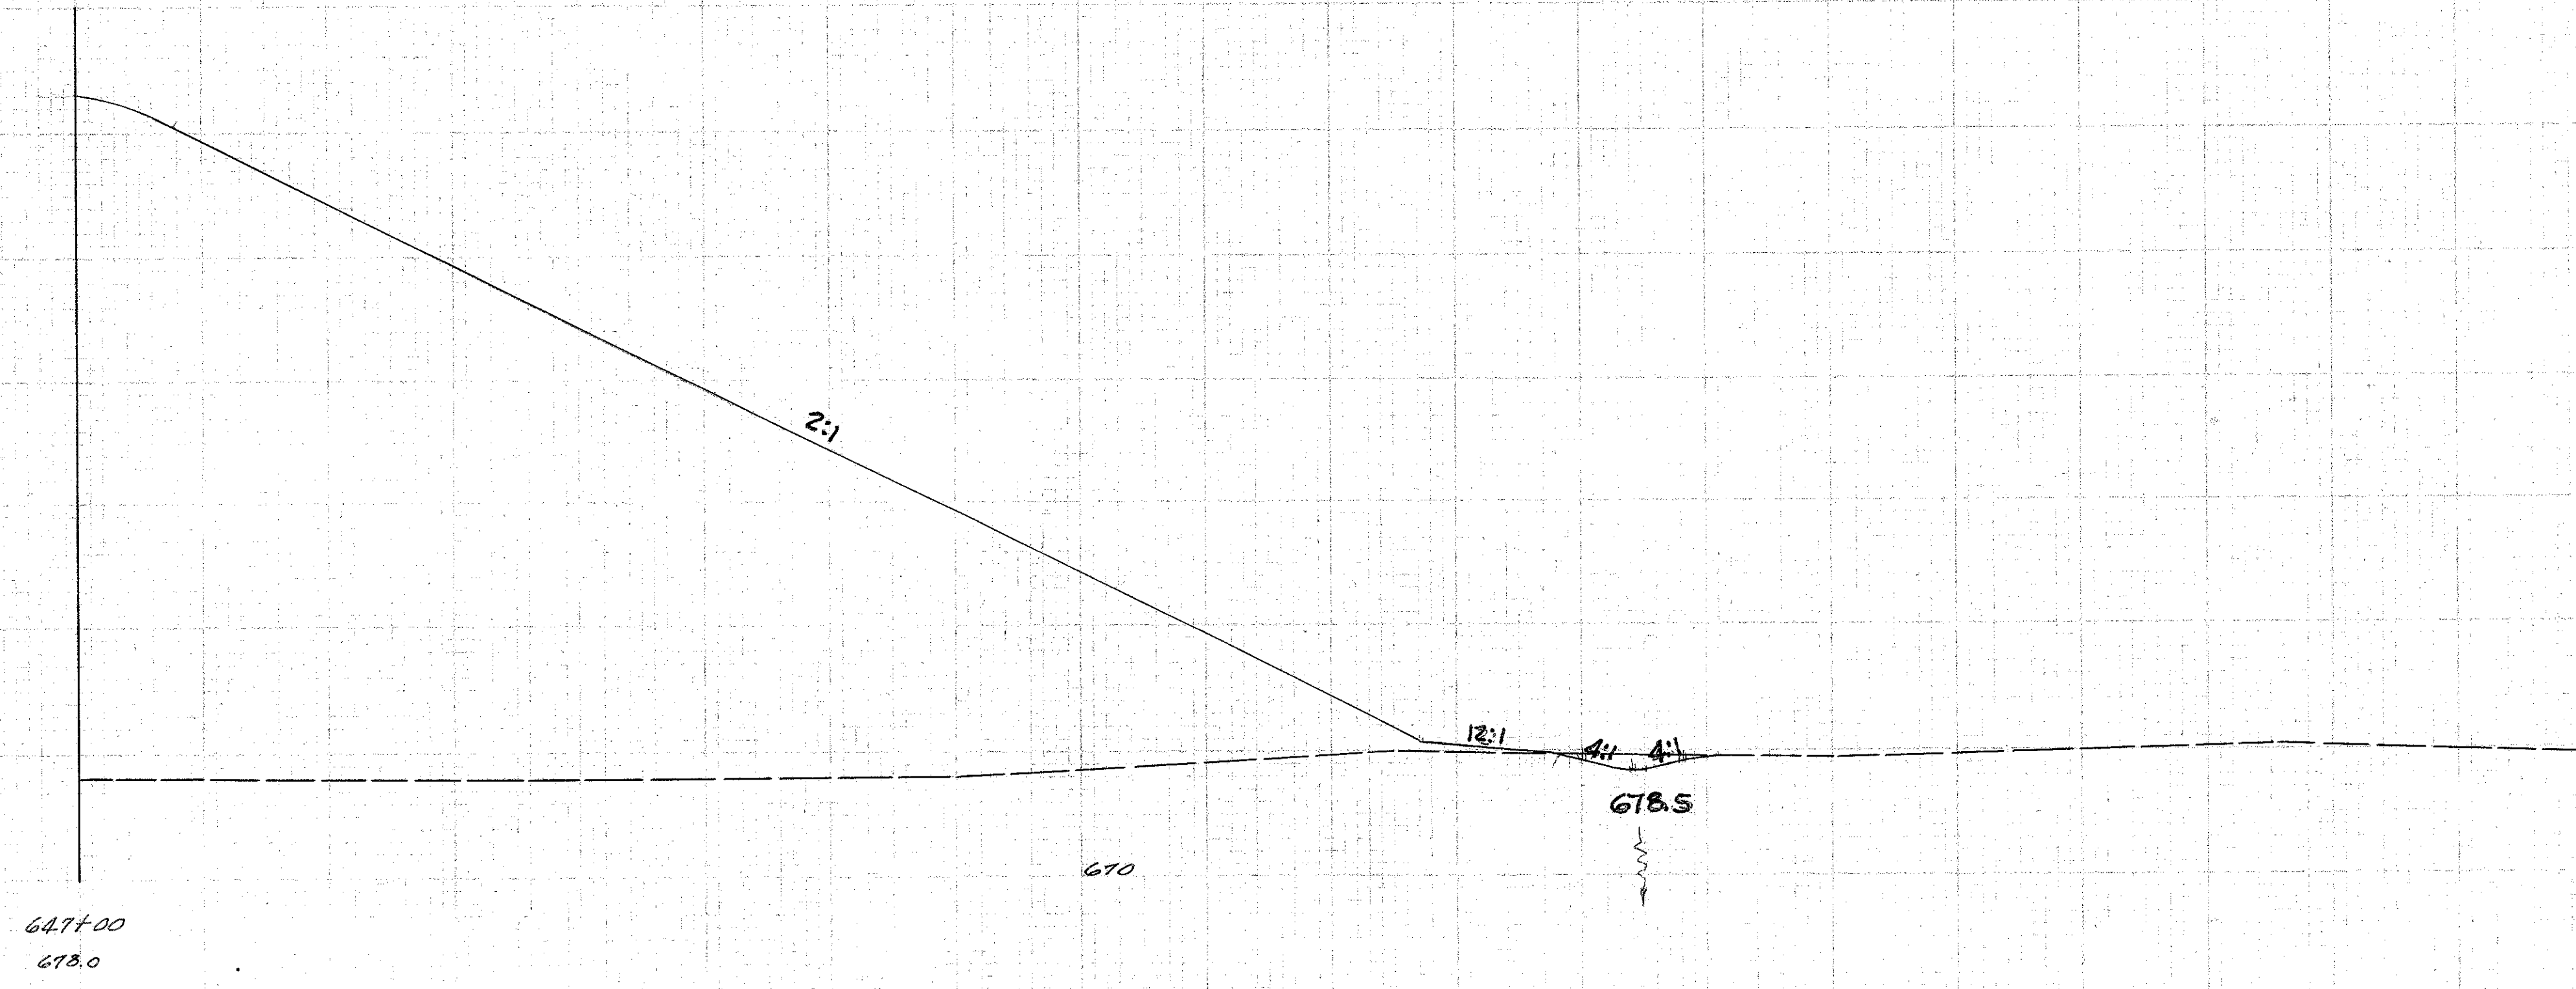

647+00
678.0

670

12:1

4:1 4:1

678.5

REVISED 3-7-58
J.M. 5-7-58

0 20 40 60 80 100 120 140 160 180 200 220 240 260 280
Sta. 647+00 Lt.