

280 260 240 220 200 180 160 140 120 100 80 60 40


SEEDING
FT. WIDTH
POS.

FED. DIVISION	STATE	PROJECT
2	OHIO	PCI-1103 (27)

269
413

LAKE COUNTY
LAK-1-16.55

END AREA	CU. YDS.
CUT FILL	CUT FILL

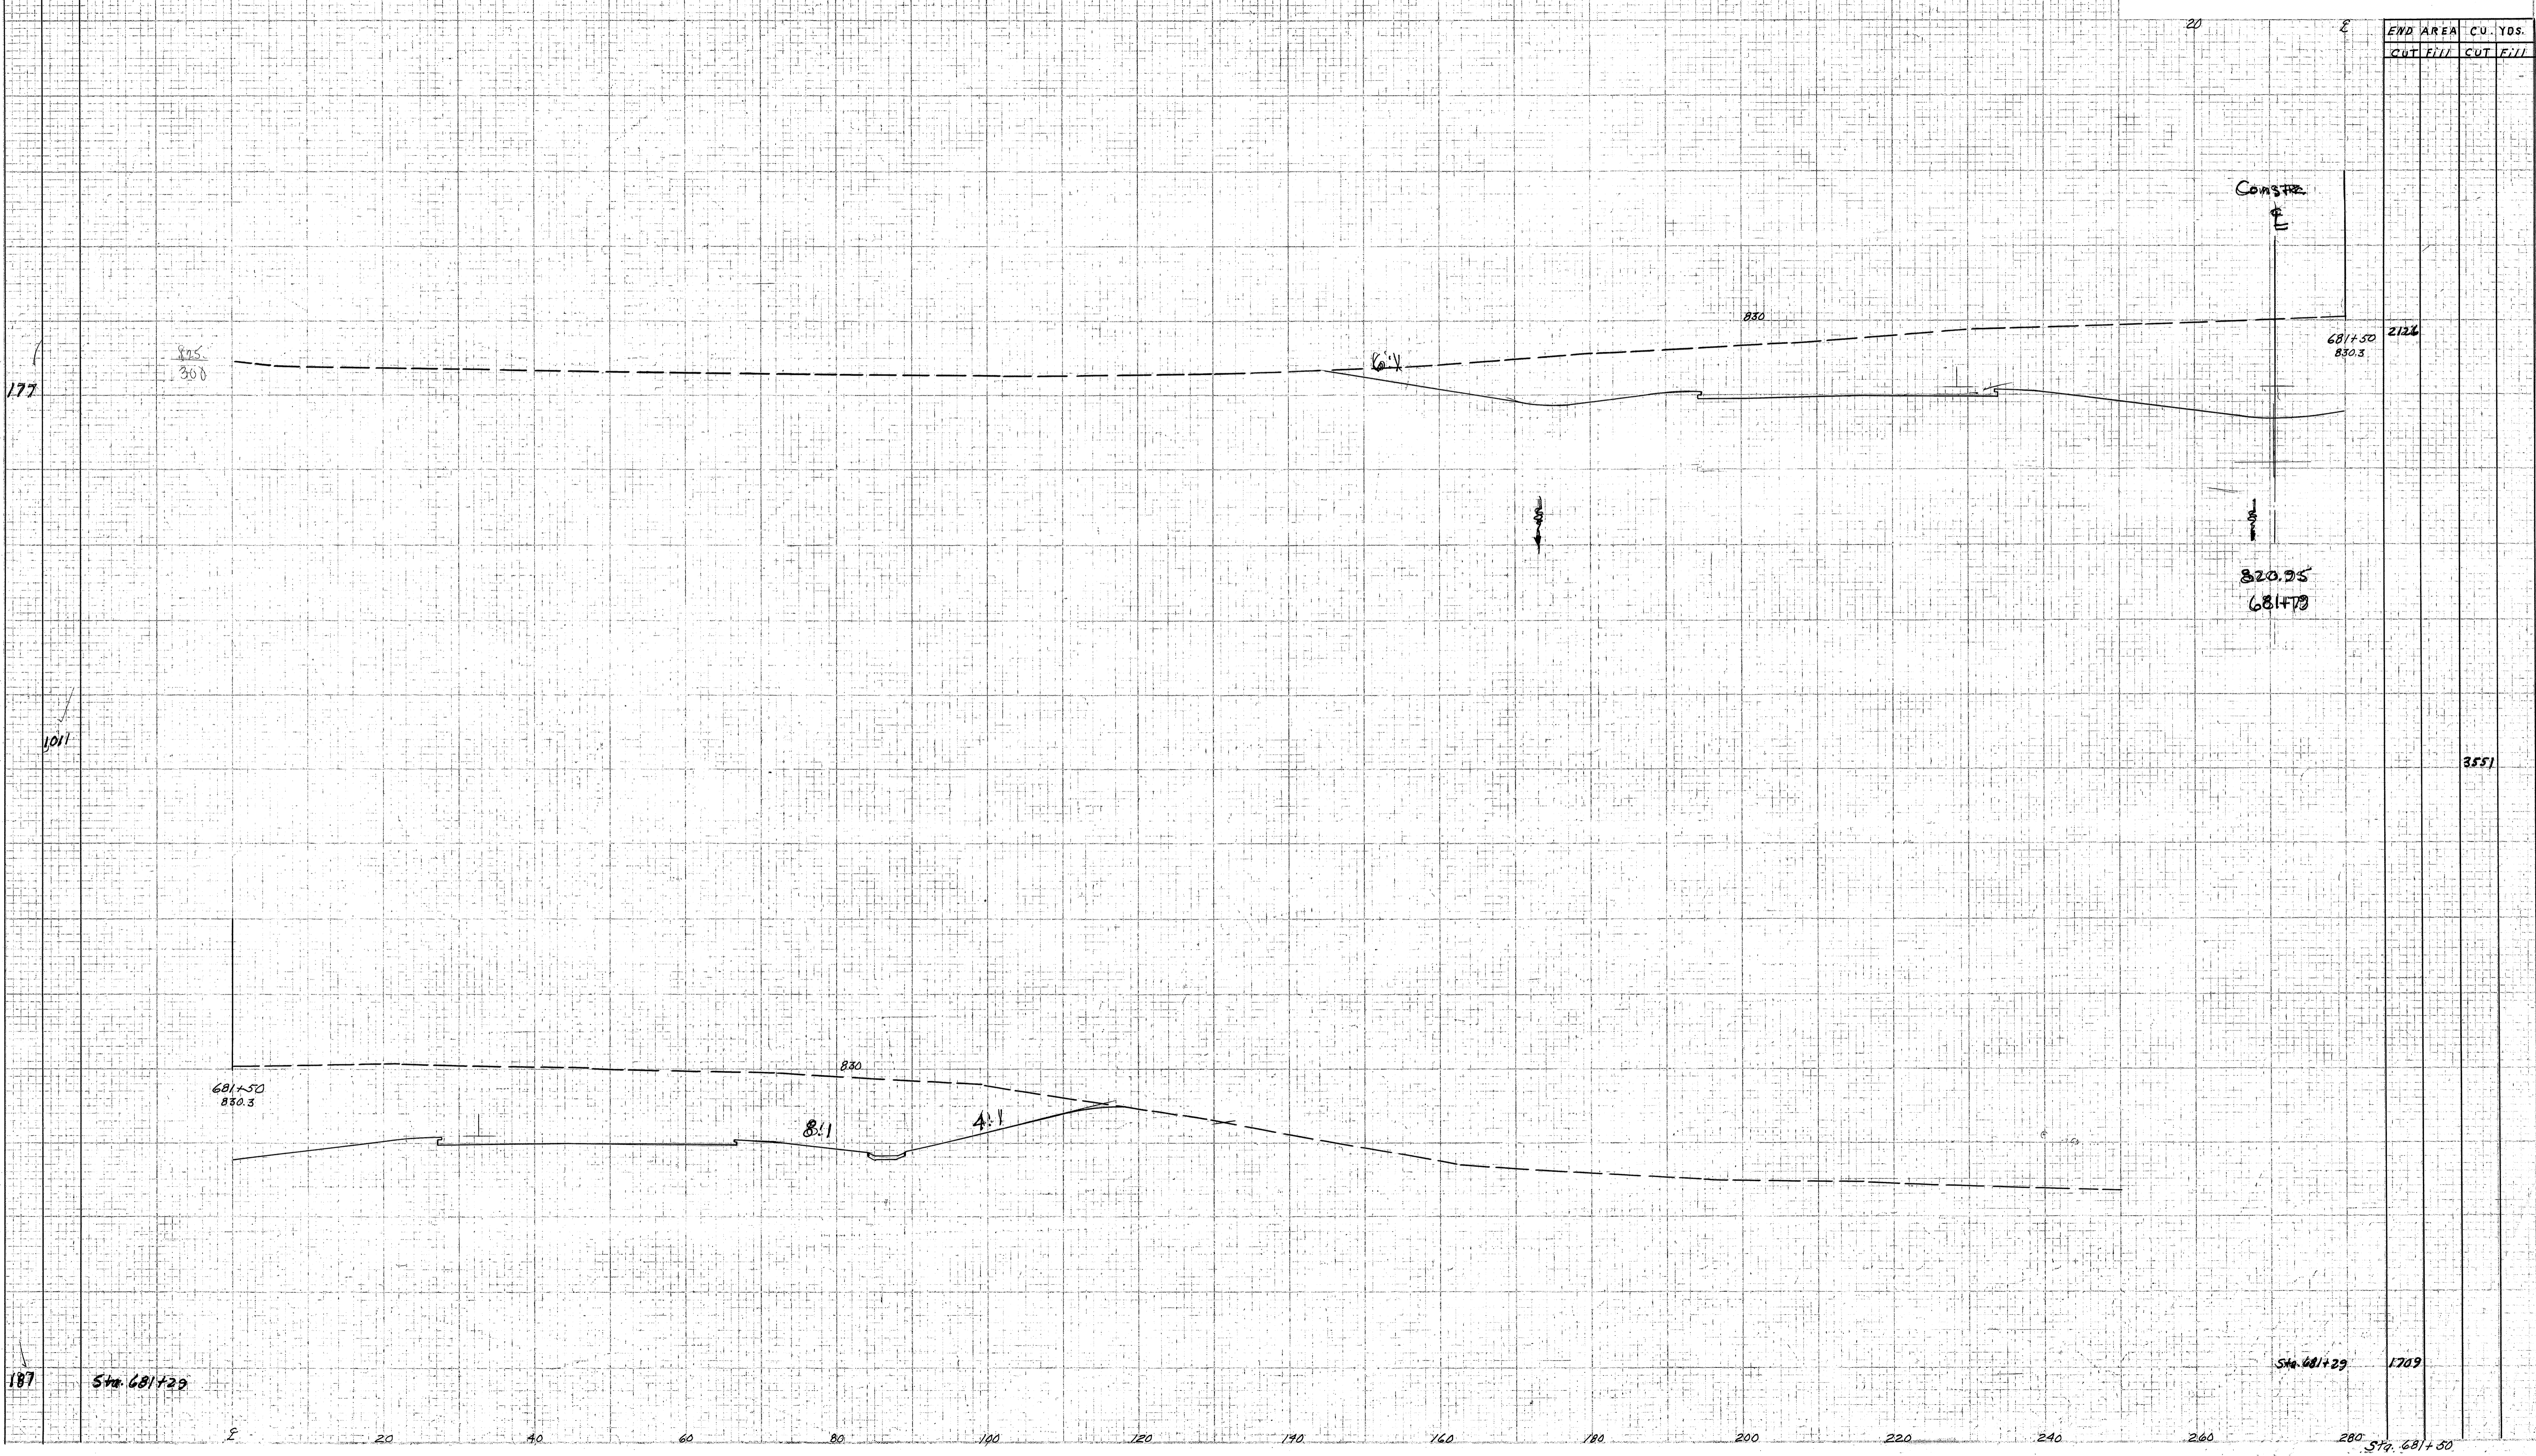

177

1011

187

Sta. 681+29

Sta. 681+29

1709

Sta. 681+30

chd. 8MB p. 2158

Revised 11-7