



MICROFILMED  
APR 6 1968

FED. RD. DIVISION	STATE	PROJECT	
2	OHIO	ACI-1103 (27)	387 413

LAKE COUNTY  
SEC. LAK-1-16.55

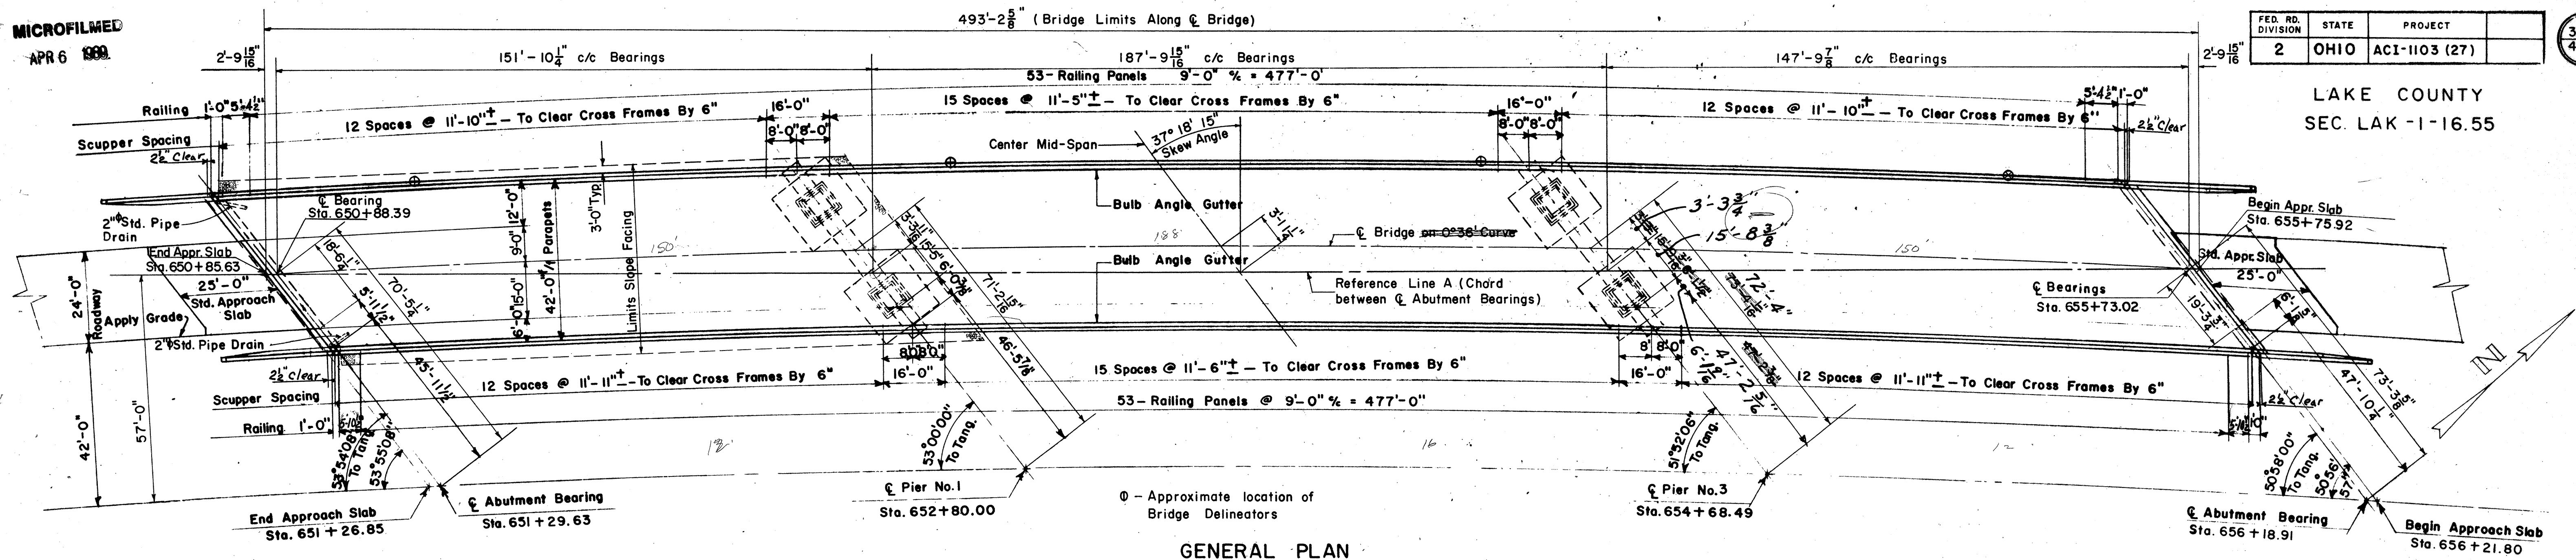

GENERAL PLAN

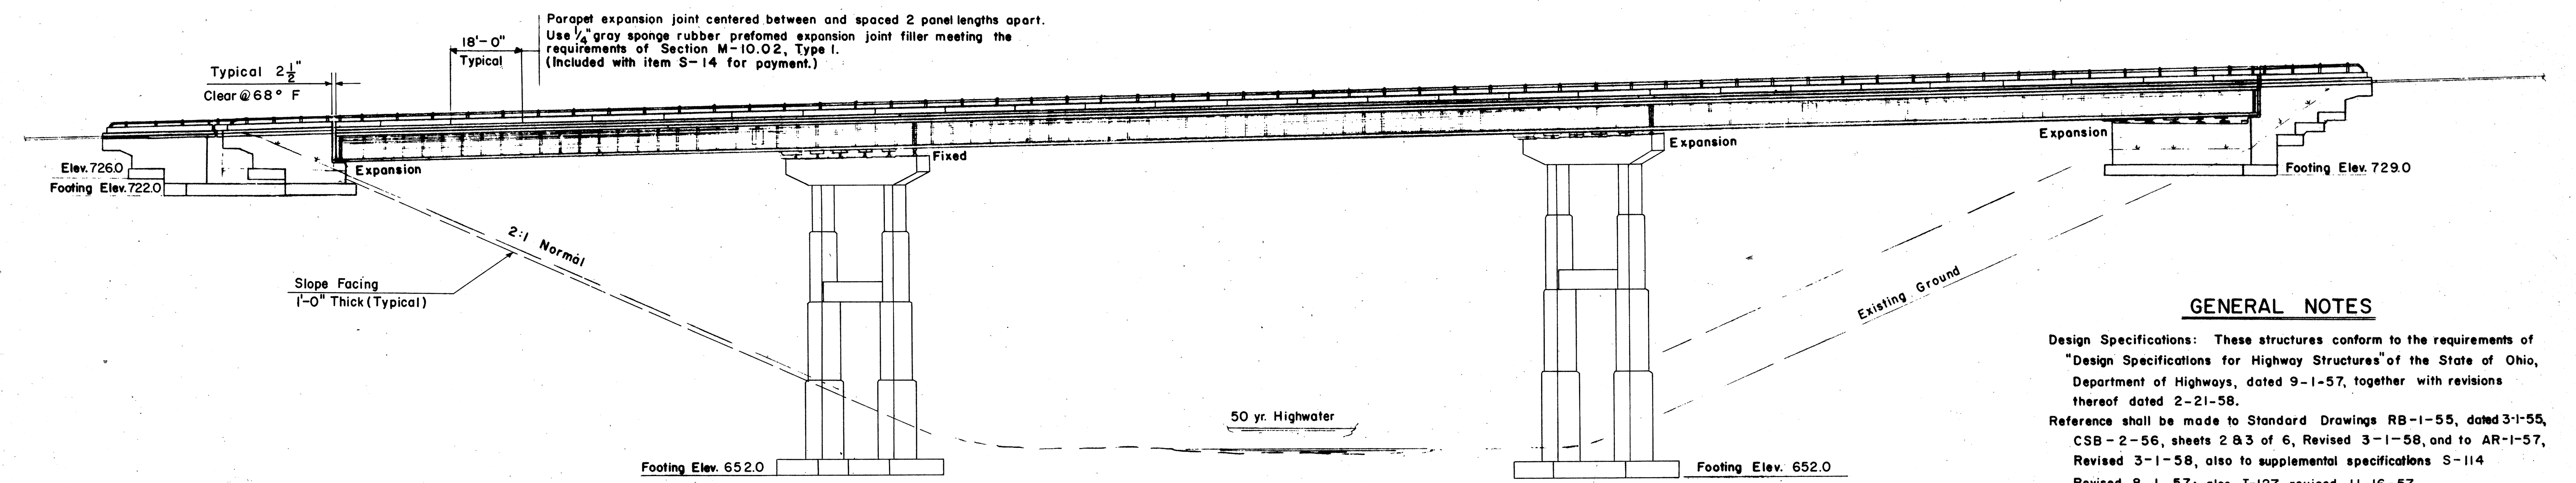

ELEVATION

GENERAL NOTES

Design Specifications: These structures conform to the requirements of "Design Specifications for Highway Structures" of the State of Ohio, Department of Highways, dated 9-1-57, together with revisions thereof dated 2-21-58.

Reference shall be made to Standard Drawings RB-1-55, dated 3-1-55, CSB-2-56, sheets 2 & 3 of 6, Revised 3-1-58, and to AR-1-57, Revised 3-1-58, also to supplemental specifications S-114 Revised 8-1-57; also I-127 revised 11-16-57.

Slope Facing (S-29.05), One Foot thick shall be provided as indicated on General Plan.

Excavation Quantity includes the removal of fill material between the bottom of abutment and the surface of the proposed embankment. Backfill behind the abutments shall be made with material meeting the requirements of Sec. I-22 and shall be compacted in accordance with requirements for embankment compaction. Payment for backfill shall be included with Item E-2.

SEC. C-33 FED. AID PROJ. NO. ACI-1103 (27)  
unclassified excavation.

PREPARED BY  
CAPITOL ENGINEERING ASSOCIATES, DILLSBURG, PA.  
FOR

STATE OF OHIO  
DEPARTMENT OF HIGHWAYS

GENERAL PLAN  
BRIDGE NO. LAK-1-1905  
S.R.1 OVER PAINE CREEK (NORTH BRIDGE)  
LAKE COUNTY  
STA. 654+75

DESIGNED	DRAWN	TRACED	CHECKED	REVISED	DATE	REVISED
JHT	JHT					6-3-58 8-12-58