


LAKE COUNTY
LAK - 1-22.43

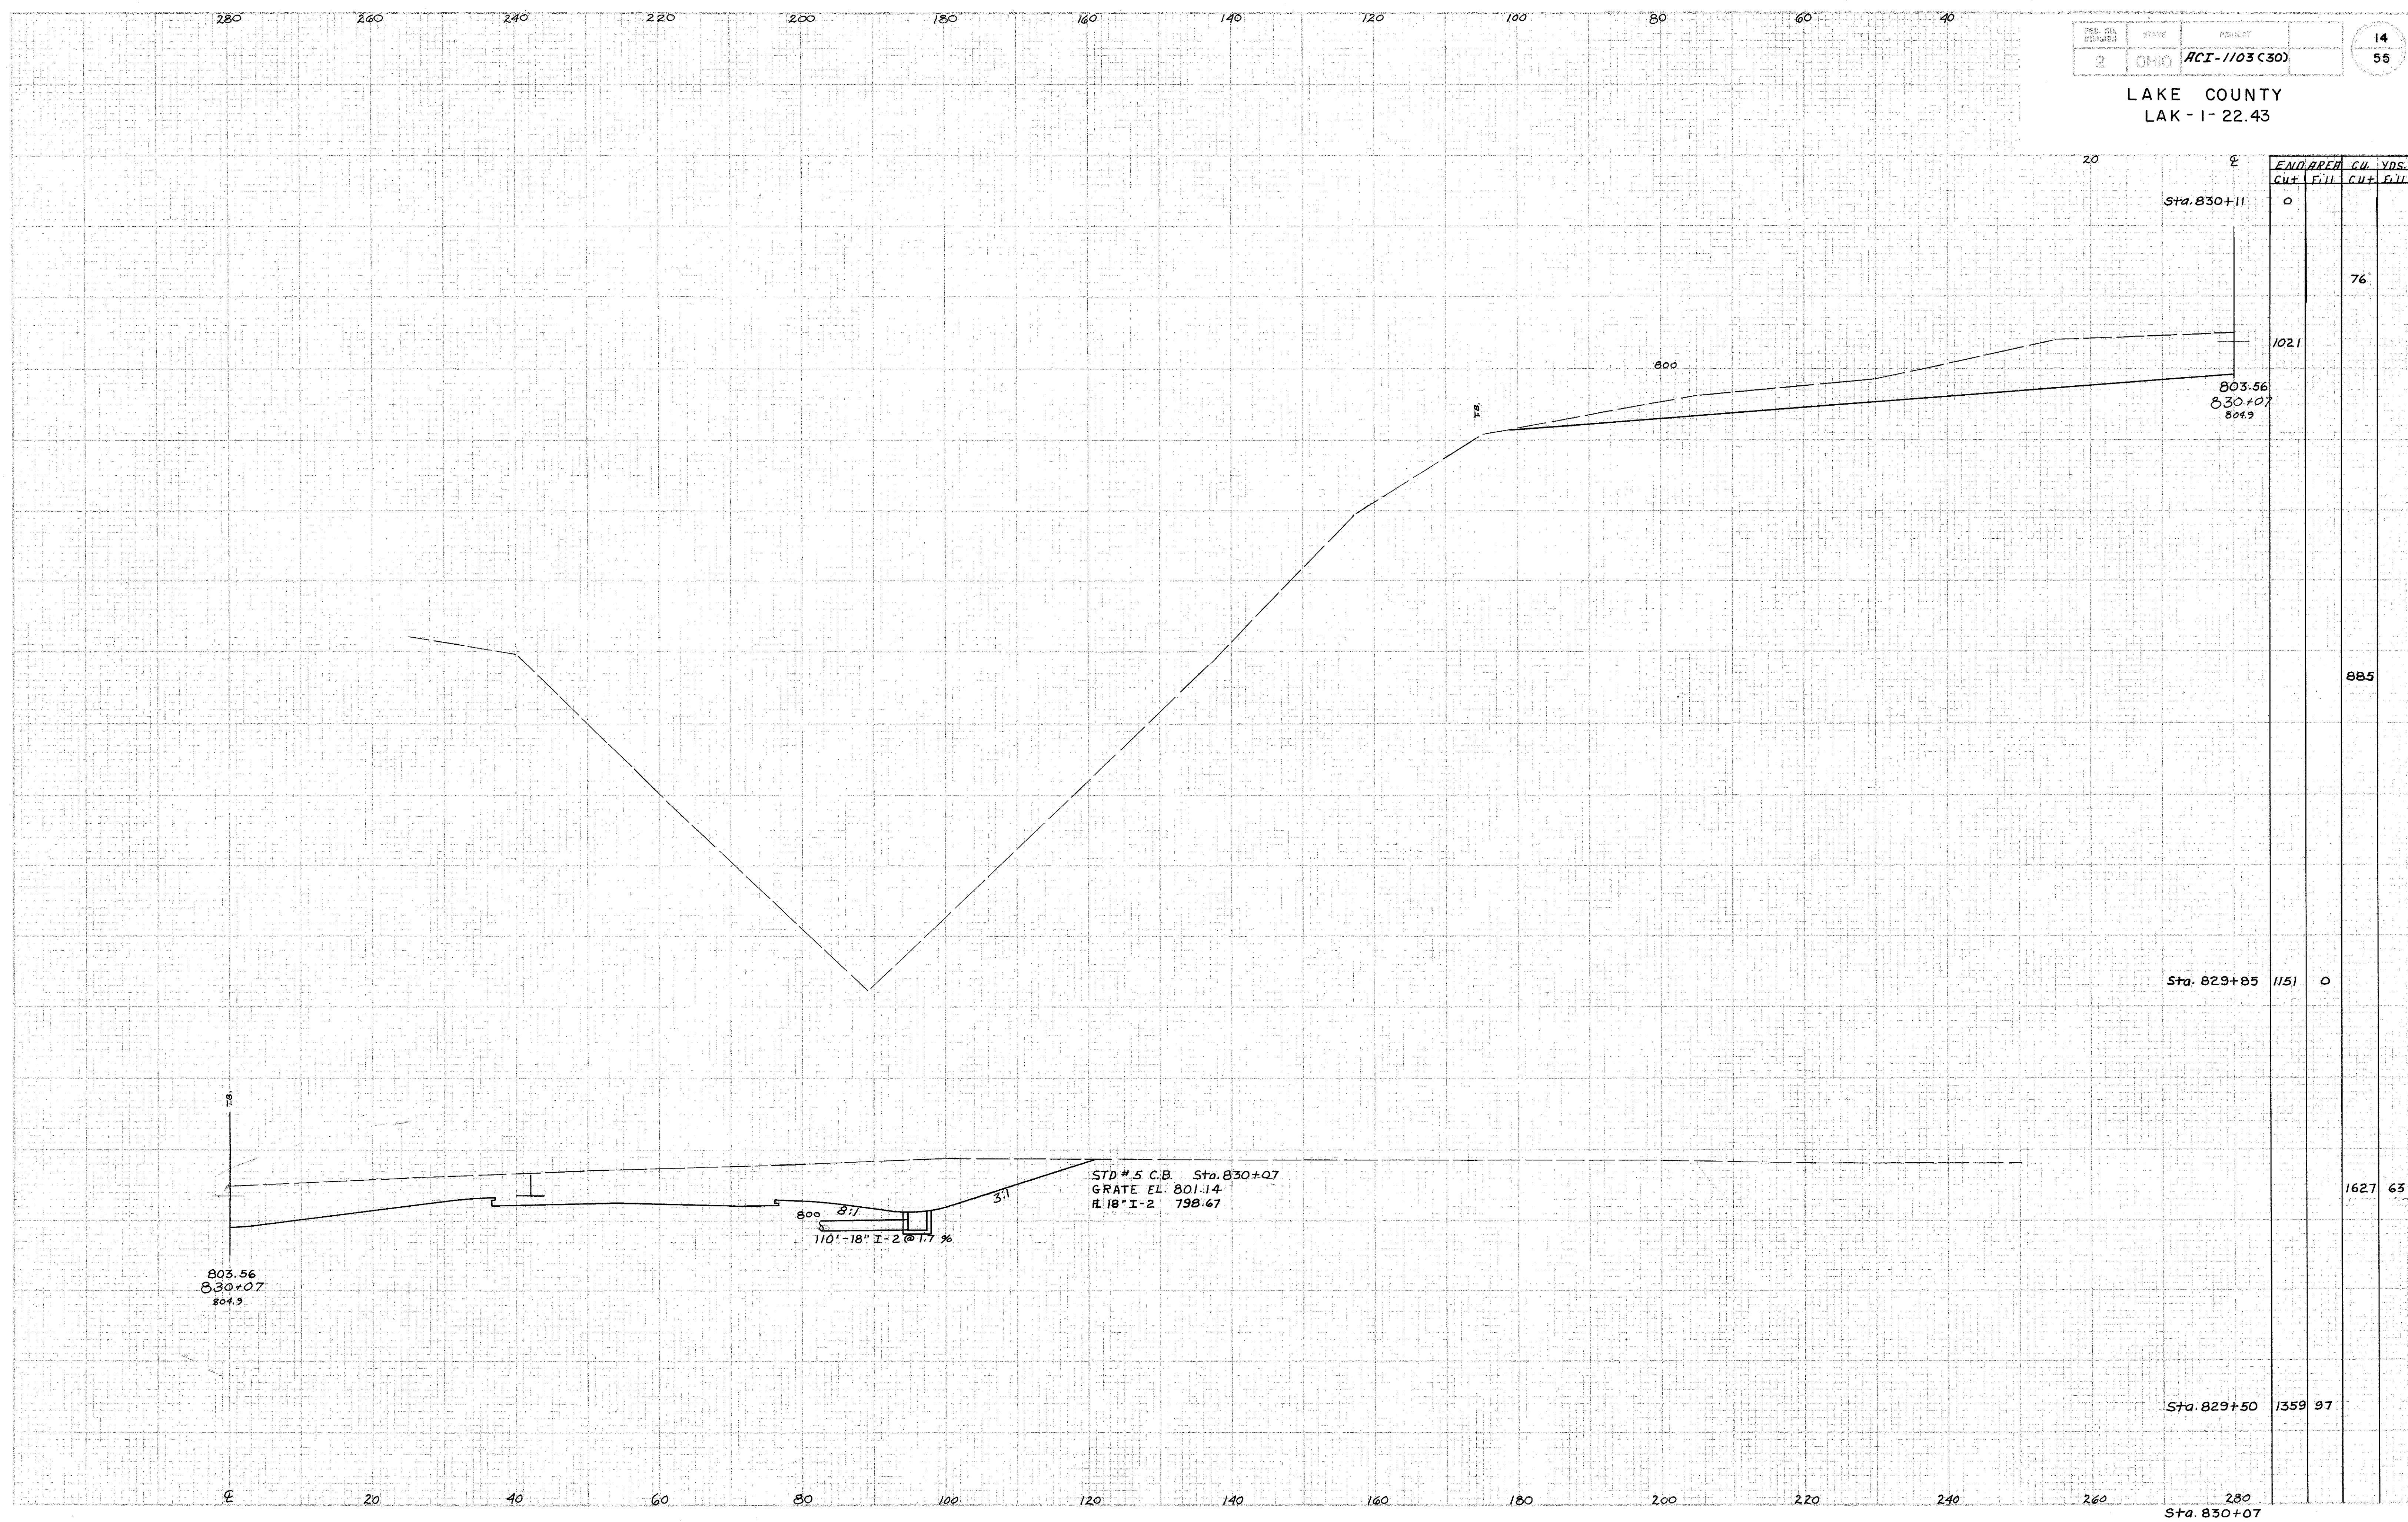

Sta.	Elev.	CUT		FILL		VOLS.
		CU.	YDS.	CU.	YDS.	
Sta. 830+11	0					
	1021					76
	803.56 830+07 804.9					
						885
Sta. 829+85	1151					
						1627
						63
Sta. 829+50	1359					
						97
Sta. 830+07	280					

803.56
830+07
804.9

STD # 5 C.B. Sta. 830+07
GRATE EL. 801.14
18" I-2 798.67

8.1
3.1
110'-18" I-2 @ 1.7 %

measured from
6-26-59
Plotted by
B.C.
X.I.