


LAKE COUNTY
SEC. LAK-1-22.43

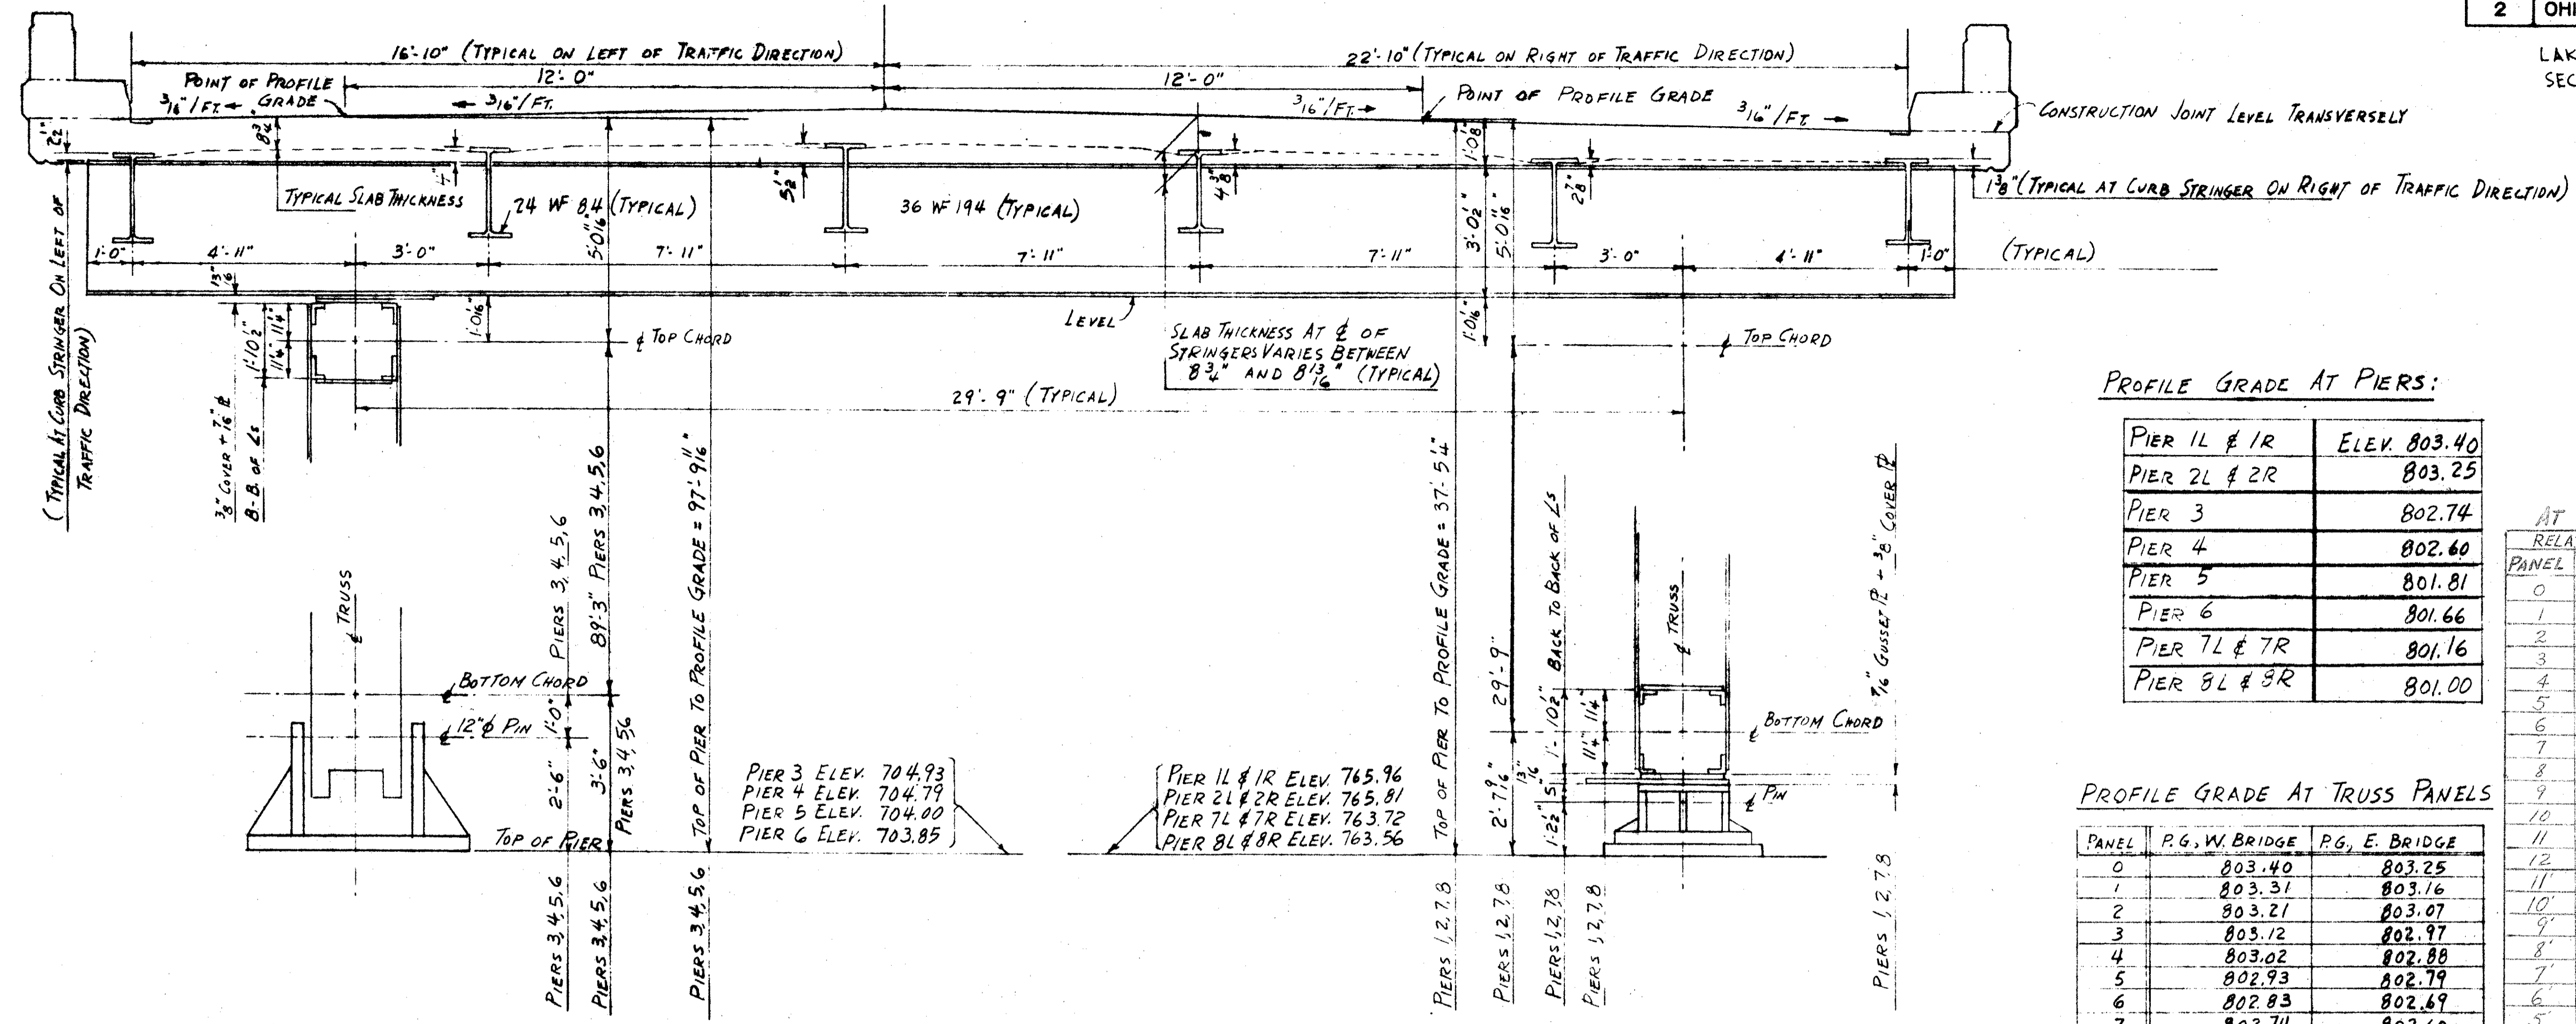

PROFILE GRADE AT PIERS:

PIER 1L & 1R	ELEV. 803.40
PIER 2L & 2R	803.25
PIER 3	802.74
PIER 4	802.60
PIER 5	801.81
PIER 6	801.66
PIER 7L & 7R	801.16
PIER 8L & 8R	801.00


CURB OFFSET
AT TRUSS PANEL POINTS

PANEL	OFFSET, W. BR. (IN.)	OFFSET, E. BR. (IN.)
0	* -0 1/2	-0 1/2
1	-0 1/2	-0 1/2
2	-0 1/2	-0 1/2
3	-0 1/2	-0 1/2
4	-0 1/2	-0 1/2
5	-0 1/2	-0 1/2
6	-0 1/2	-0 1/2
7	-0 1/2	-0 1/2
8	-0 1/2	+0 1/4
9	-0 1/2	+2 1/2
10	-1 1/4	-0 3/8
11	-2 1/4	-2 1/4
12	-2	-3
11'	-0 3/8	-3 1/2
10'	+0 3/8	-2 3/4
9'	+3 3/4	-0 3/4
8'	+0 5/8	-3 1/2
7'	-2 1/4	-5 3/8
6'	-4	-7
5'	-4 1/2	-7 3/4
4'	-4 1/2	-6 3/4
3'	-4	-5 1/2
2'	-2 1/4	-3 1/4
1'	+3/8	-0 1/8
0'	+3 3/4	+3 1/2

PROFILE GRADE AT TRUSS PANELS

PANEL	P.G. W. BRIDGE	P.G. E. BRIDGE
0	803.40	803.25
1	803.31	803.16
2	803.21	803.07
3	803.12	802.97
4	803.02	802.88
5	802.93	802.79
6	802.83	802.69
7	802.74	802.60
8	802.65	802.51
9	802.56	802.42
10	802.46	802.32
11	802.37	802.23
12	802.28	802.13
11'	802.18	802.04
10'	802.09	801.94
9'	802.00	801.85
8'	801.90	801.75
7'	801.81	801.66
6'	801.72	801.57
5'	801.63	801.48
4'	801.54	801.38
3'	801.44	801.29
2'	801.35	801.19
1'	801.25	801.10
0	801.16	801.00

PART SECTION THRU TRUSS BRIDGE LOOKING IN THE DIRECTION OF TRAFFIC MOVEMENT
"TYPICAL" MEANS "AT EVERY CORRESPONDING LOCATION"

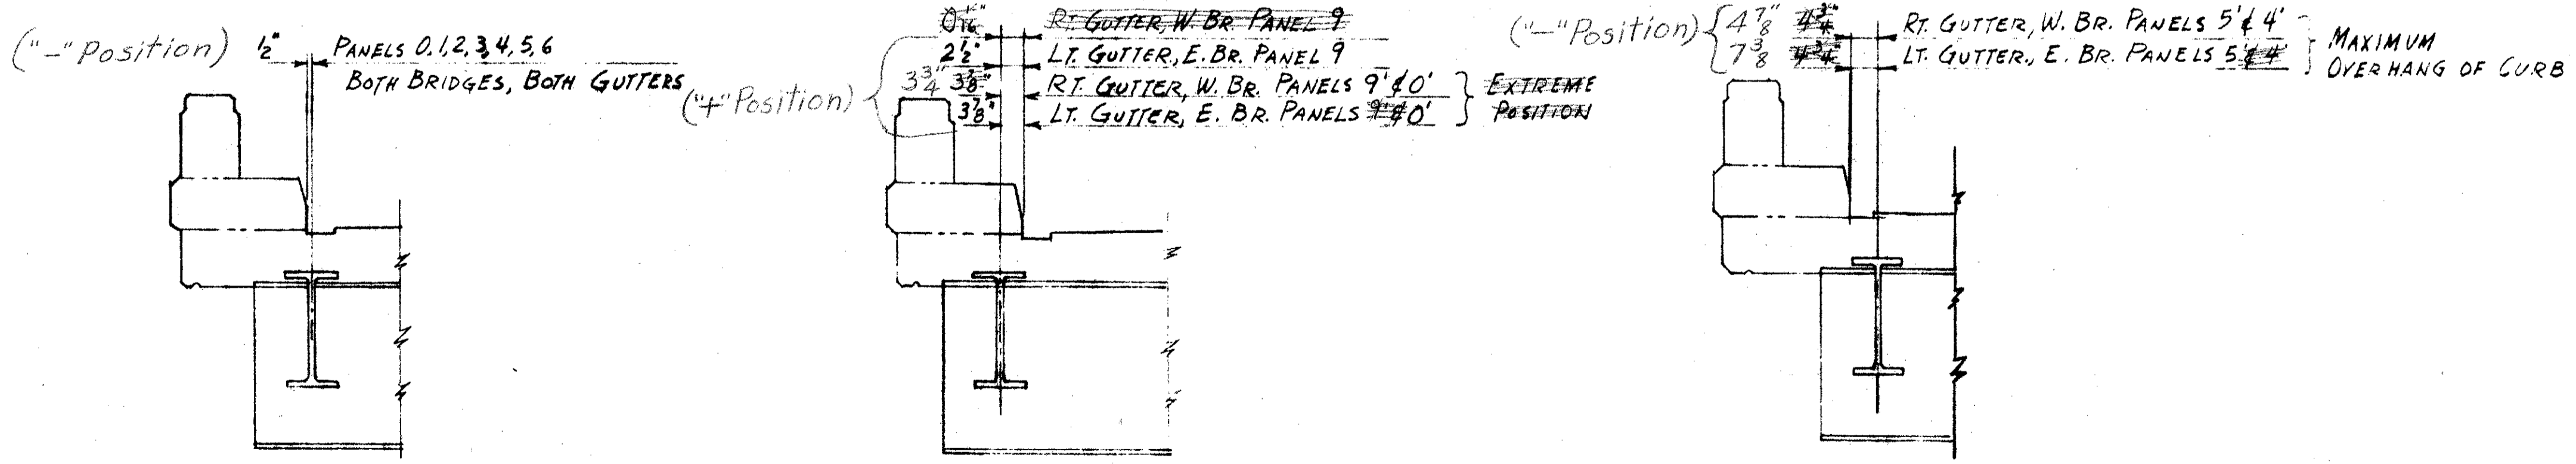

RELATION OF CURB STRINGER TO GUTTER

"Rt." MEANS ON THE RIGHT OF TRAFFIC
"Lt." MEANS ON THE LEFT OF TRAFFIC

This sheet is to be used for construction and is added to those replacing the Bidding Plans. Date: 10-21-58.

SEC. C-34B FED. AID PROJECT NO. ACI-1103(30)

PREPARED BY
CAPITOL ENGINEERING ASSOCIATES, DILLSBURG, PA.
FOR
STATE OF OHIO
DEPARTMENT OF HIGHWAYS
DIVISION OF DESIGN AND CONSTRUCTION
BUREAU OF BRIDGES

SUPPLEMENTAL TRUSS DIMENSIONS & ELEVATIONS
BRIDGE NO. LAK-1-2252
OVER GRAND RIVER
LAKE COUNTY
STA. 833+75.00

DESIGNED	DRAWN	TRACED	CHECKED	REVISED DATE	REVISED
				11-5-58	2-2-59

Rev. 2-2-59