


SEEDING
END
WIDTH
SQ.
YDS.

2 OHIO PCI-1103 (29)

43
280

LAKE COUNTY
LAK - I-2260

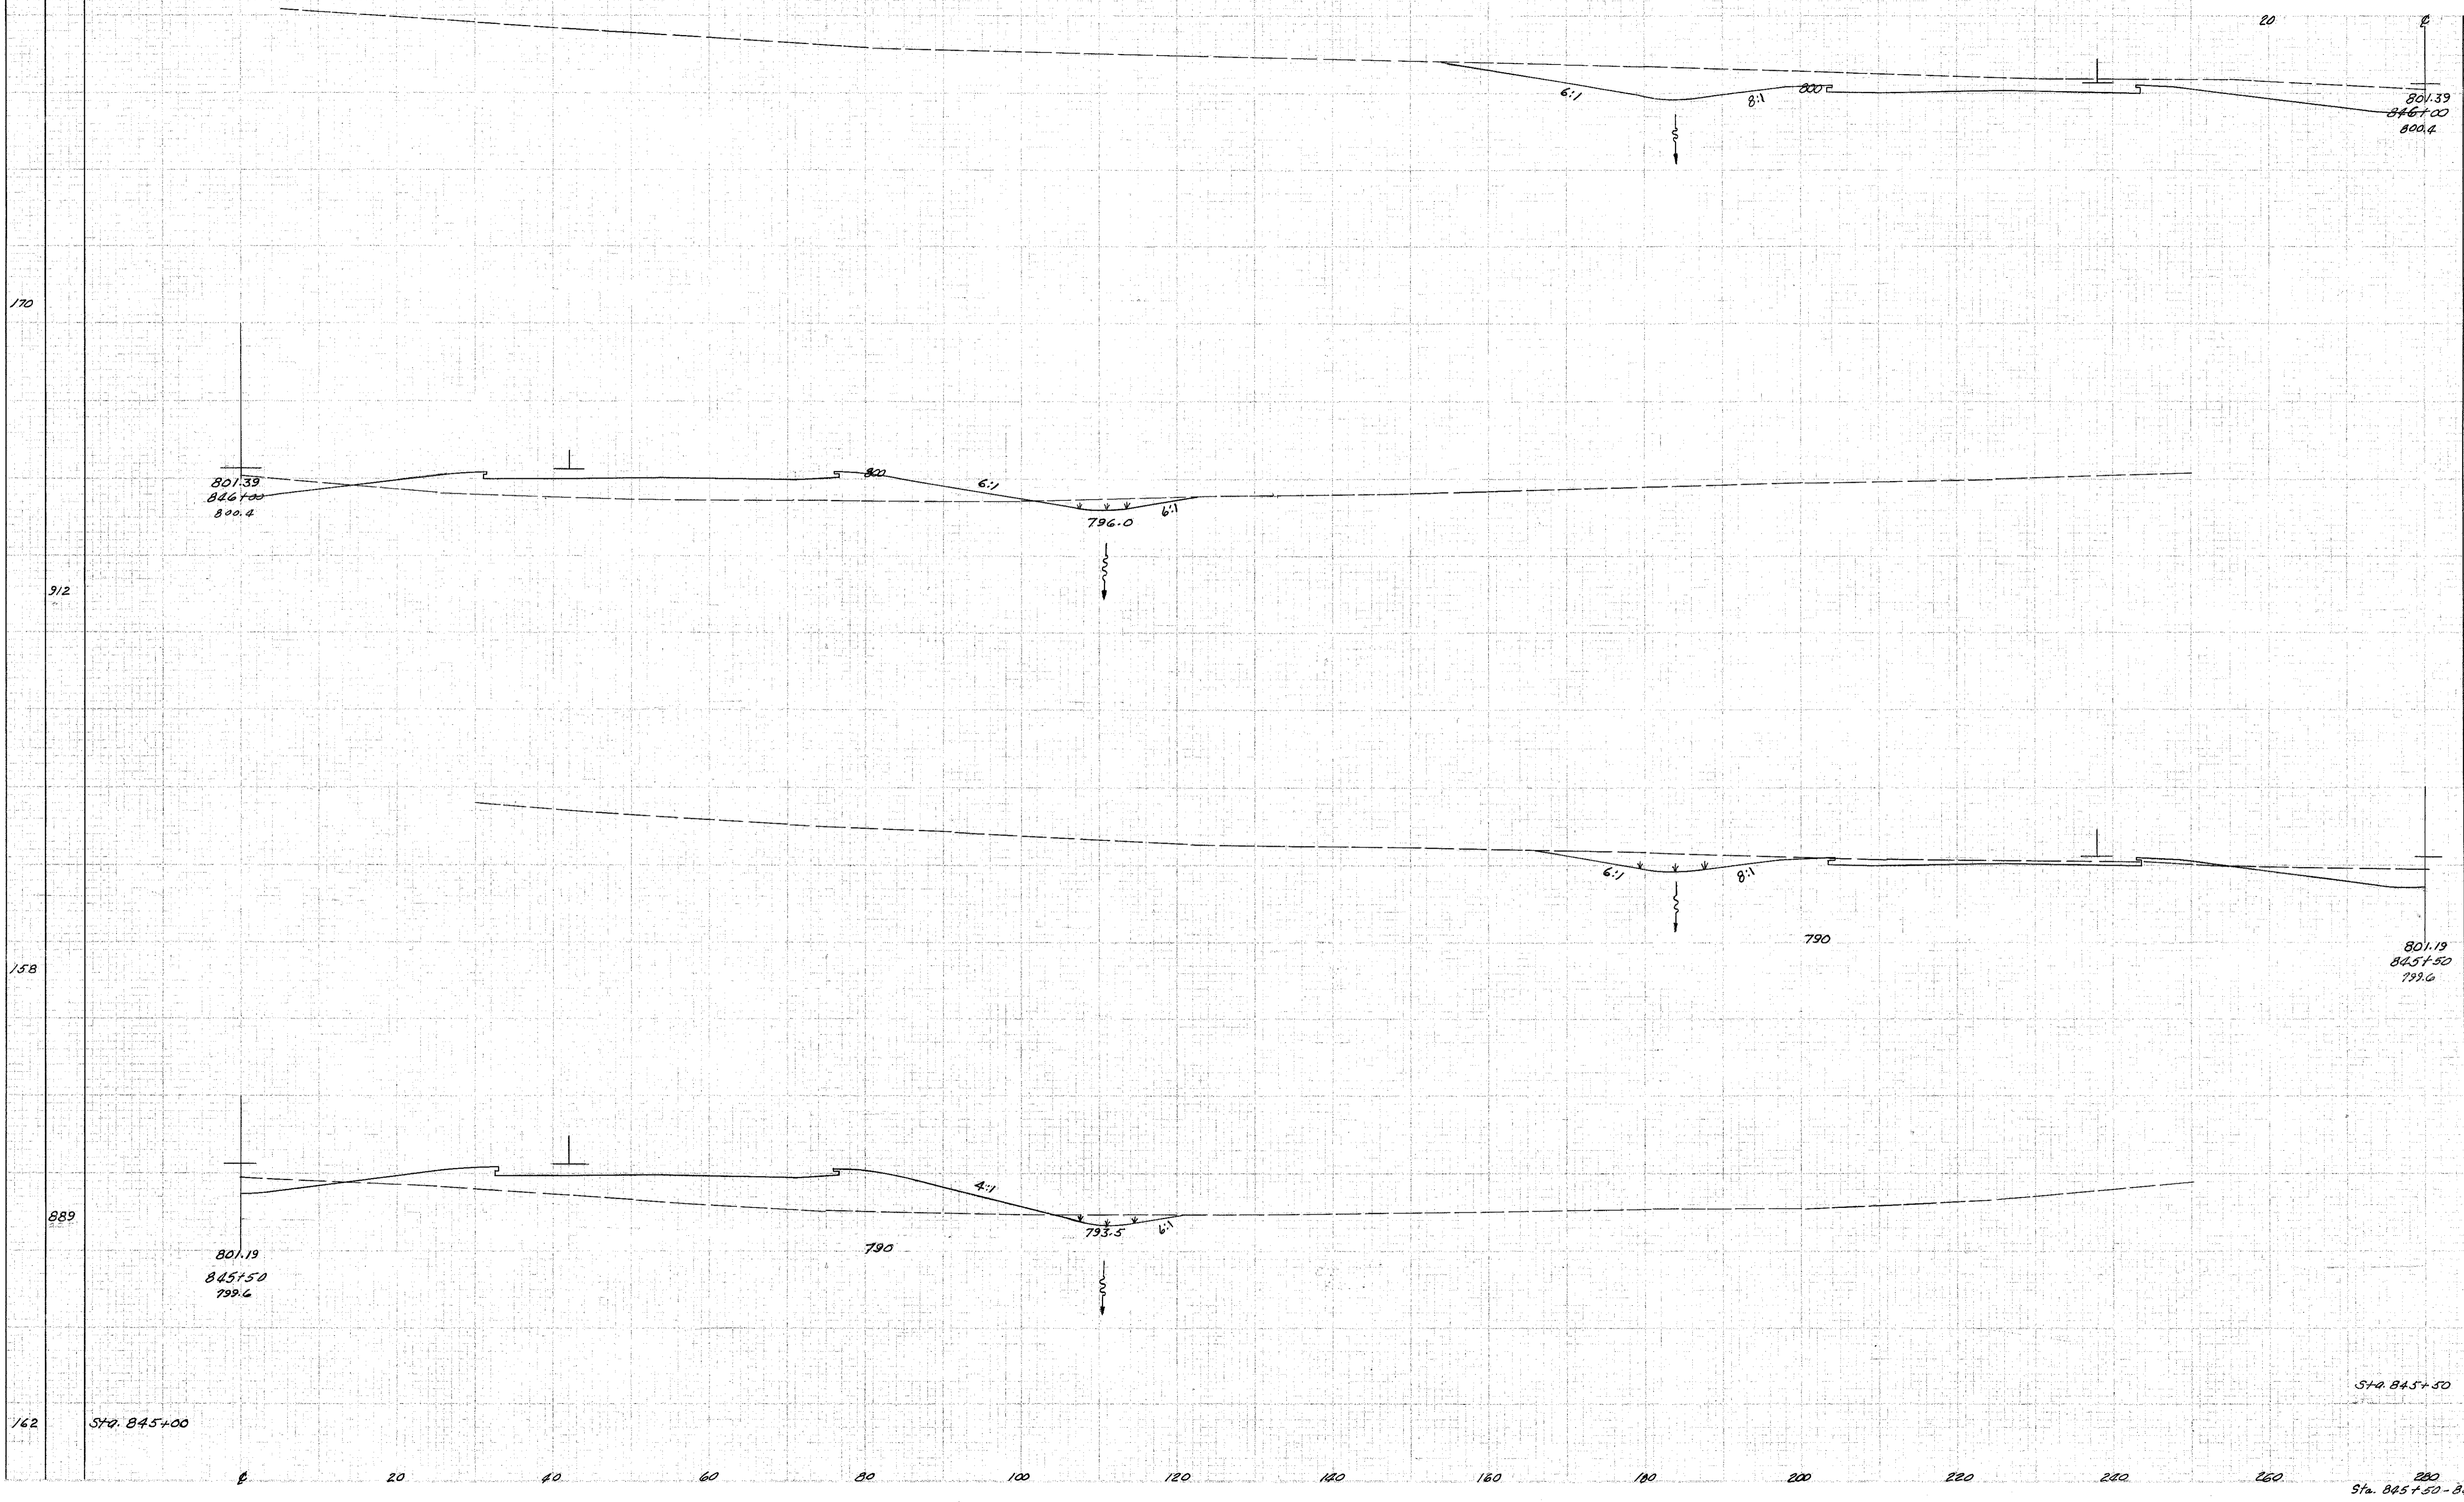

END AREA		CU. YDS.	
CUT	FILL	CUT	FILL
330	198		
		435	432
139	268		
		186	587
		61	365

Rev. 5-19-58
Rev. 7-19-58

Rev.
4-30-58

Sta. 845+50 - 846+00