


SEEDING
END STA
WIDTH YDS.

PROJECT NO.	STATE	PROJECT
2	OHIO	WCI-1103 (29)

47
280

LAKE COUNTY
LAK-1-22.60

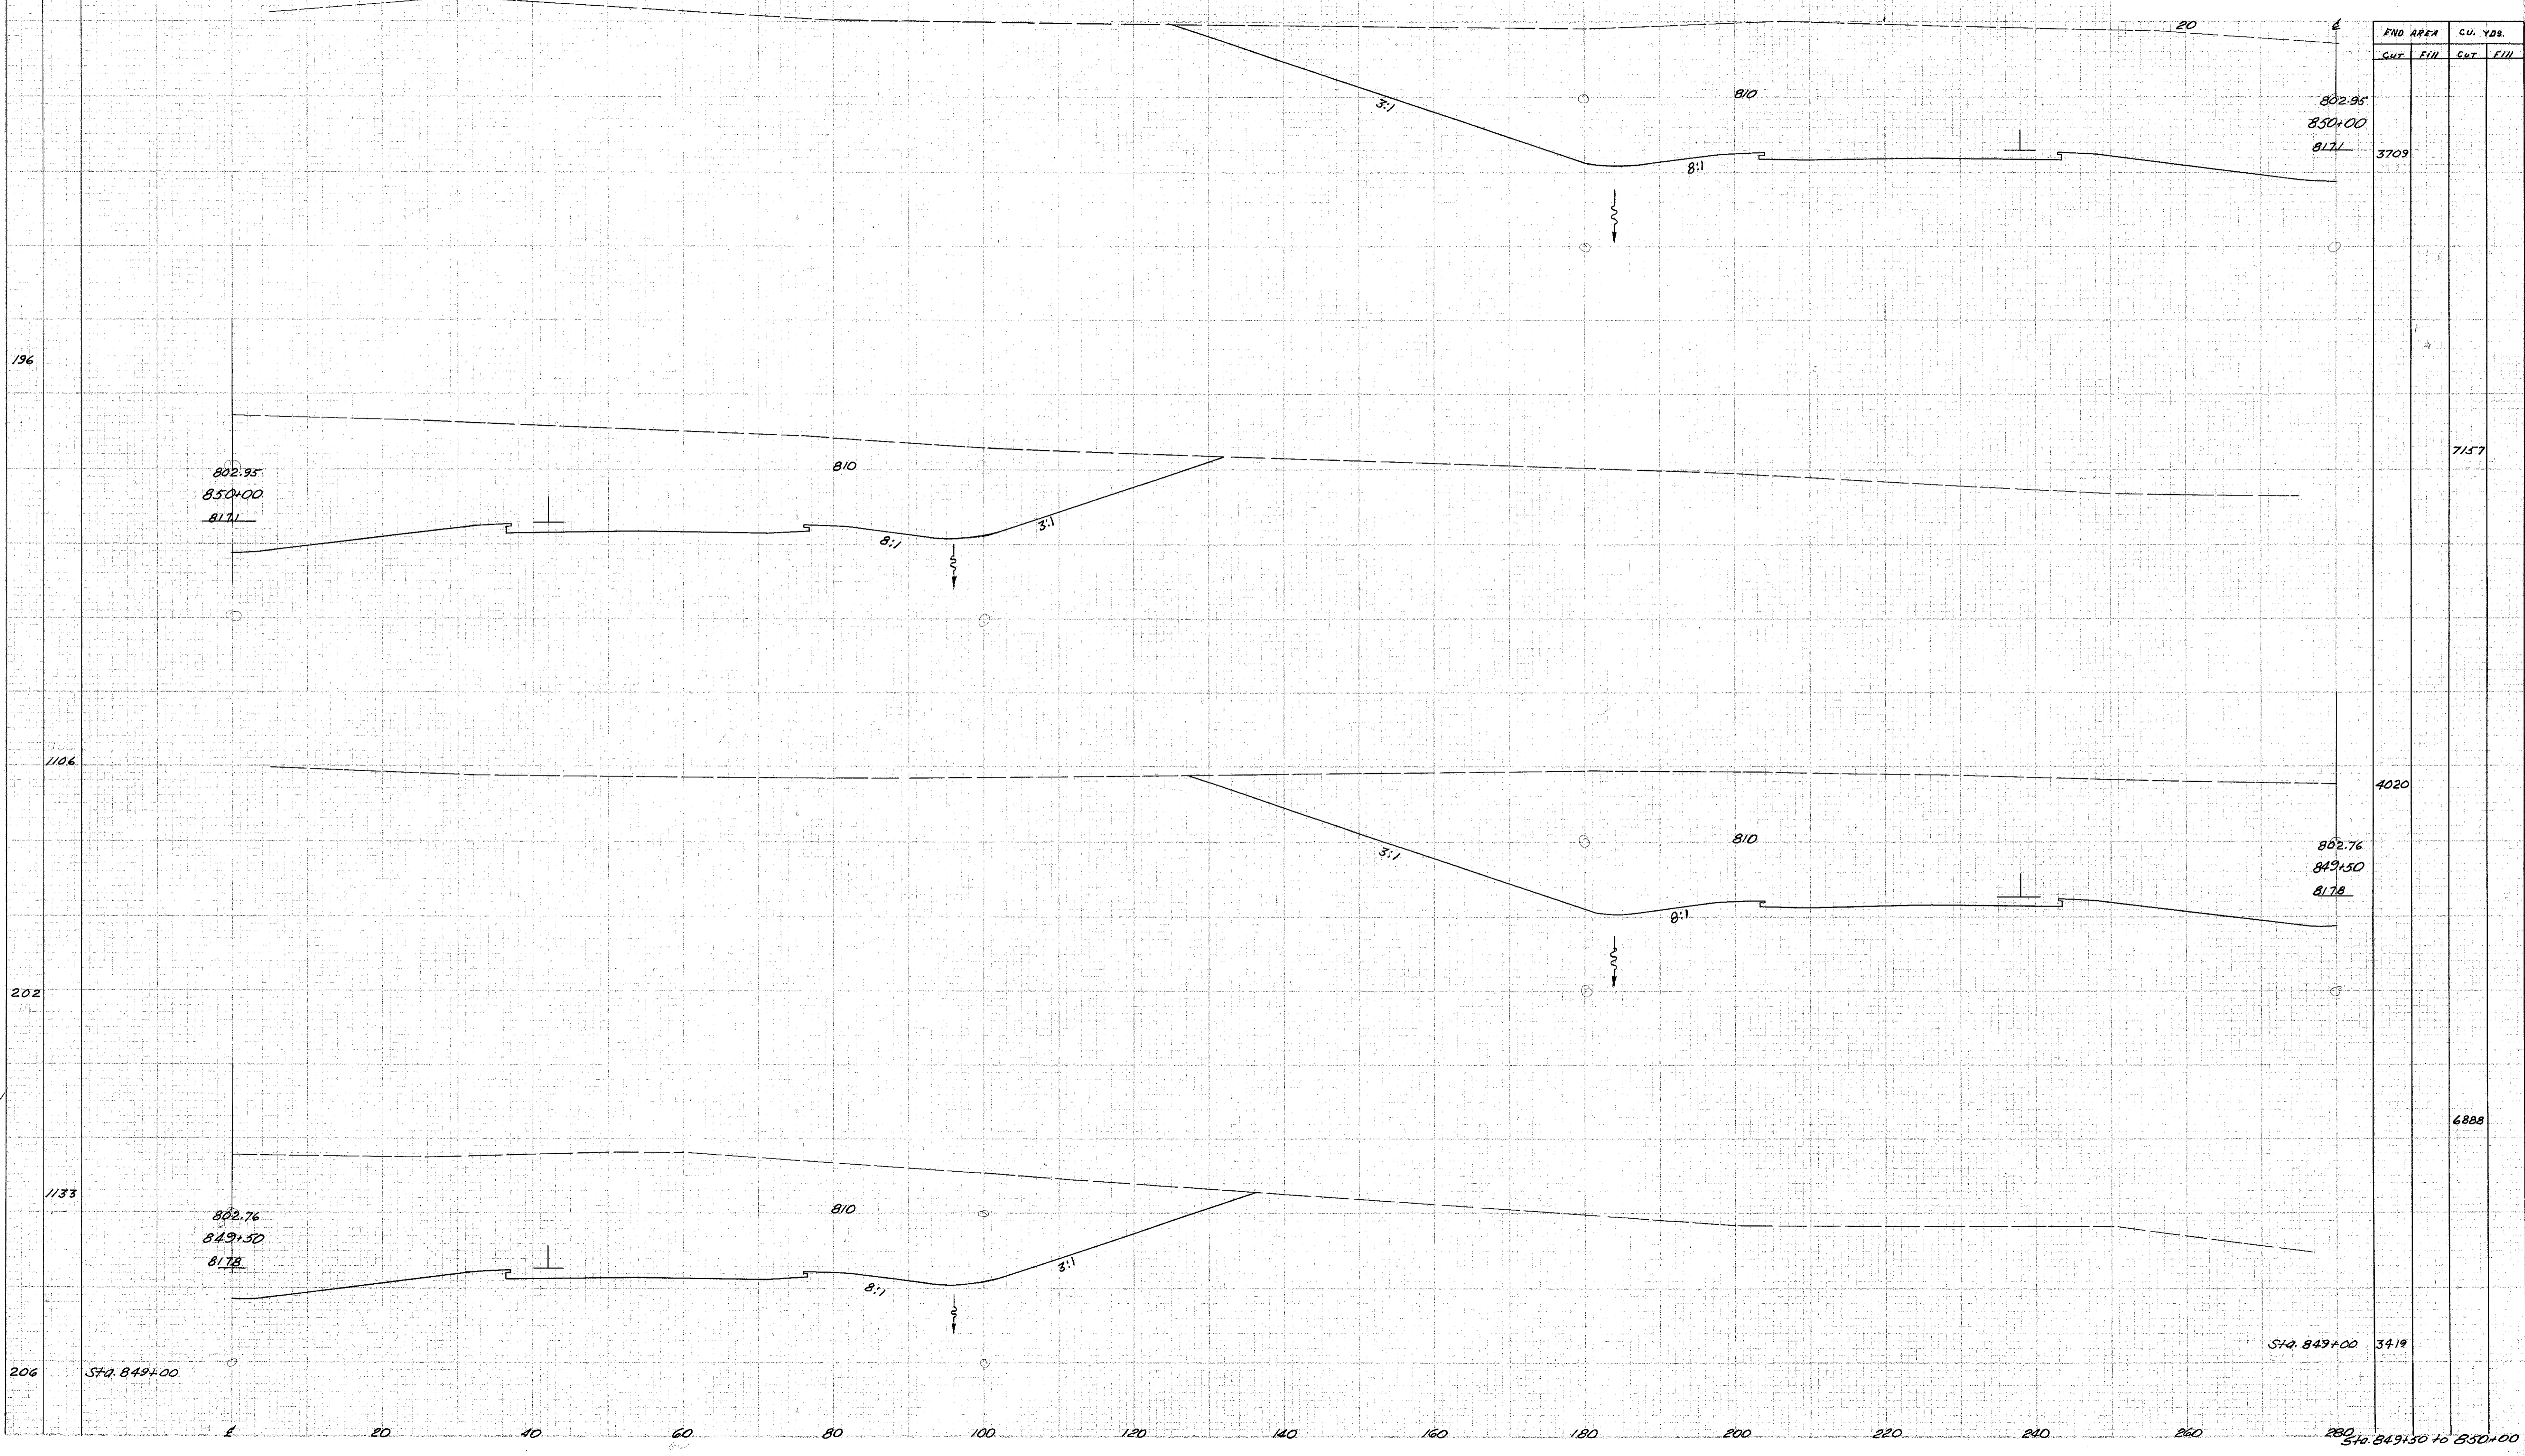

Handwritten note: 1106 STA. 849+50 TO 850+00

Handwritten note: Rev.
4-30-58

STA. 849+00 TO 850+00