


SEEDING
END Sta.
WEATHER YRS

280 260 240 220 200 180 160 140 120 100 80 60 40

ED. YRS DIVISION	STATE	PROJECT	49 280
2	OHIO	HCE-1103 (29)	

LAKE COUNTY
LAK-1-22.60

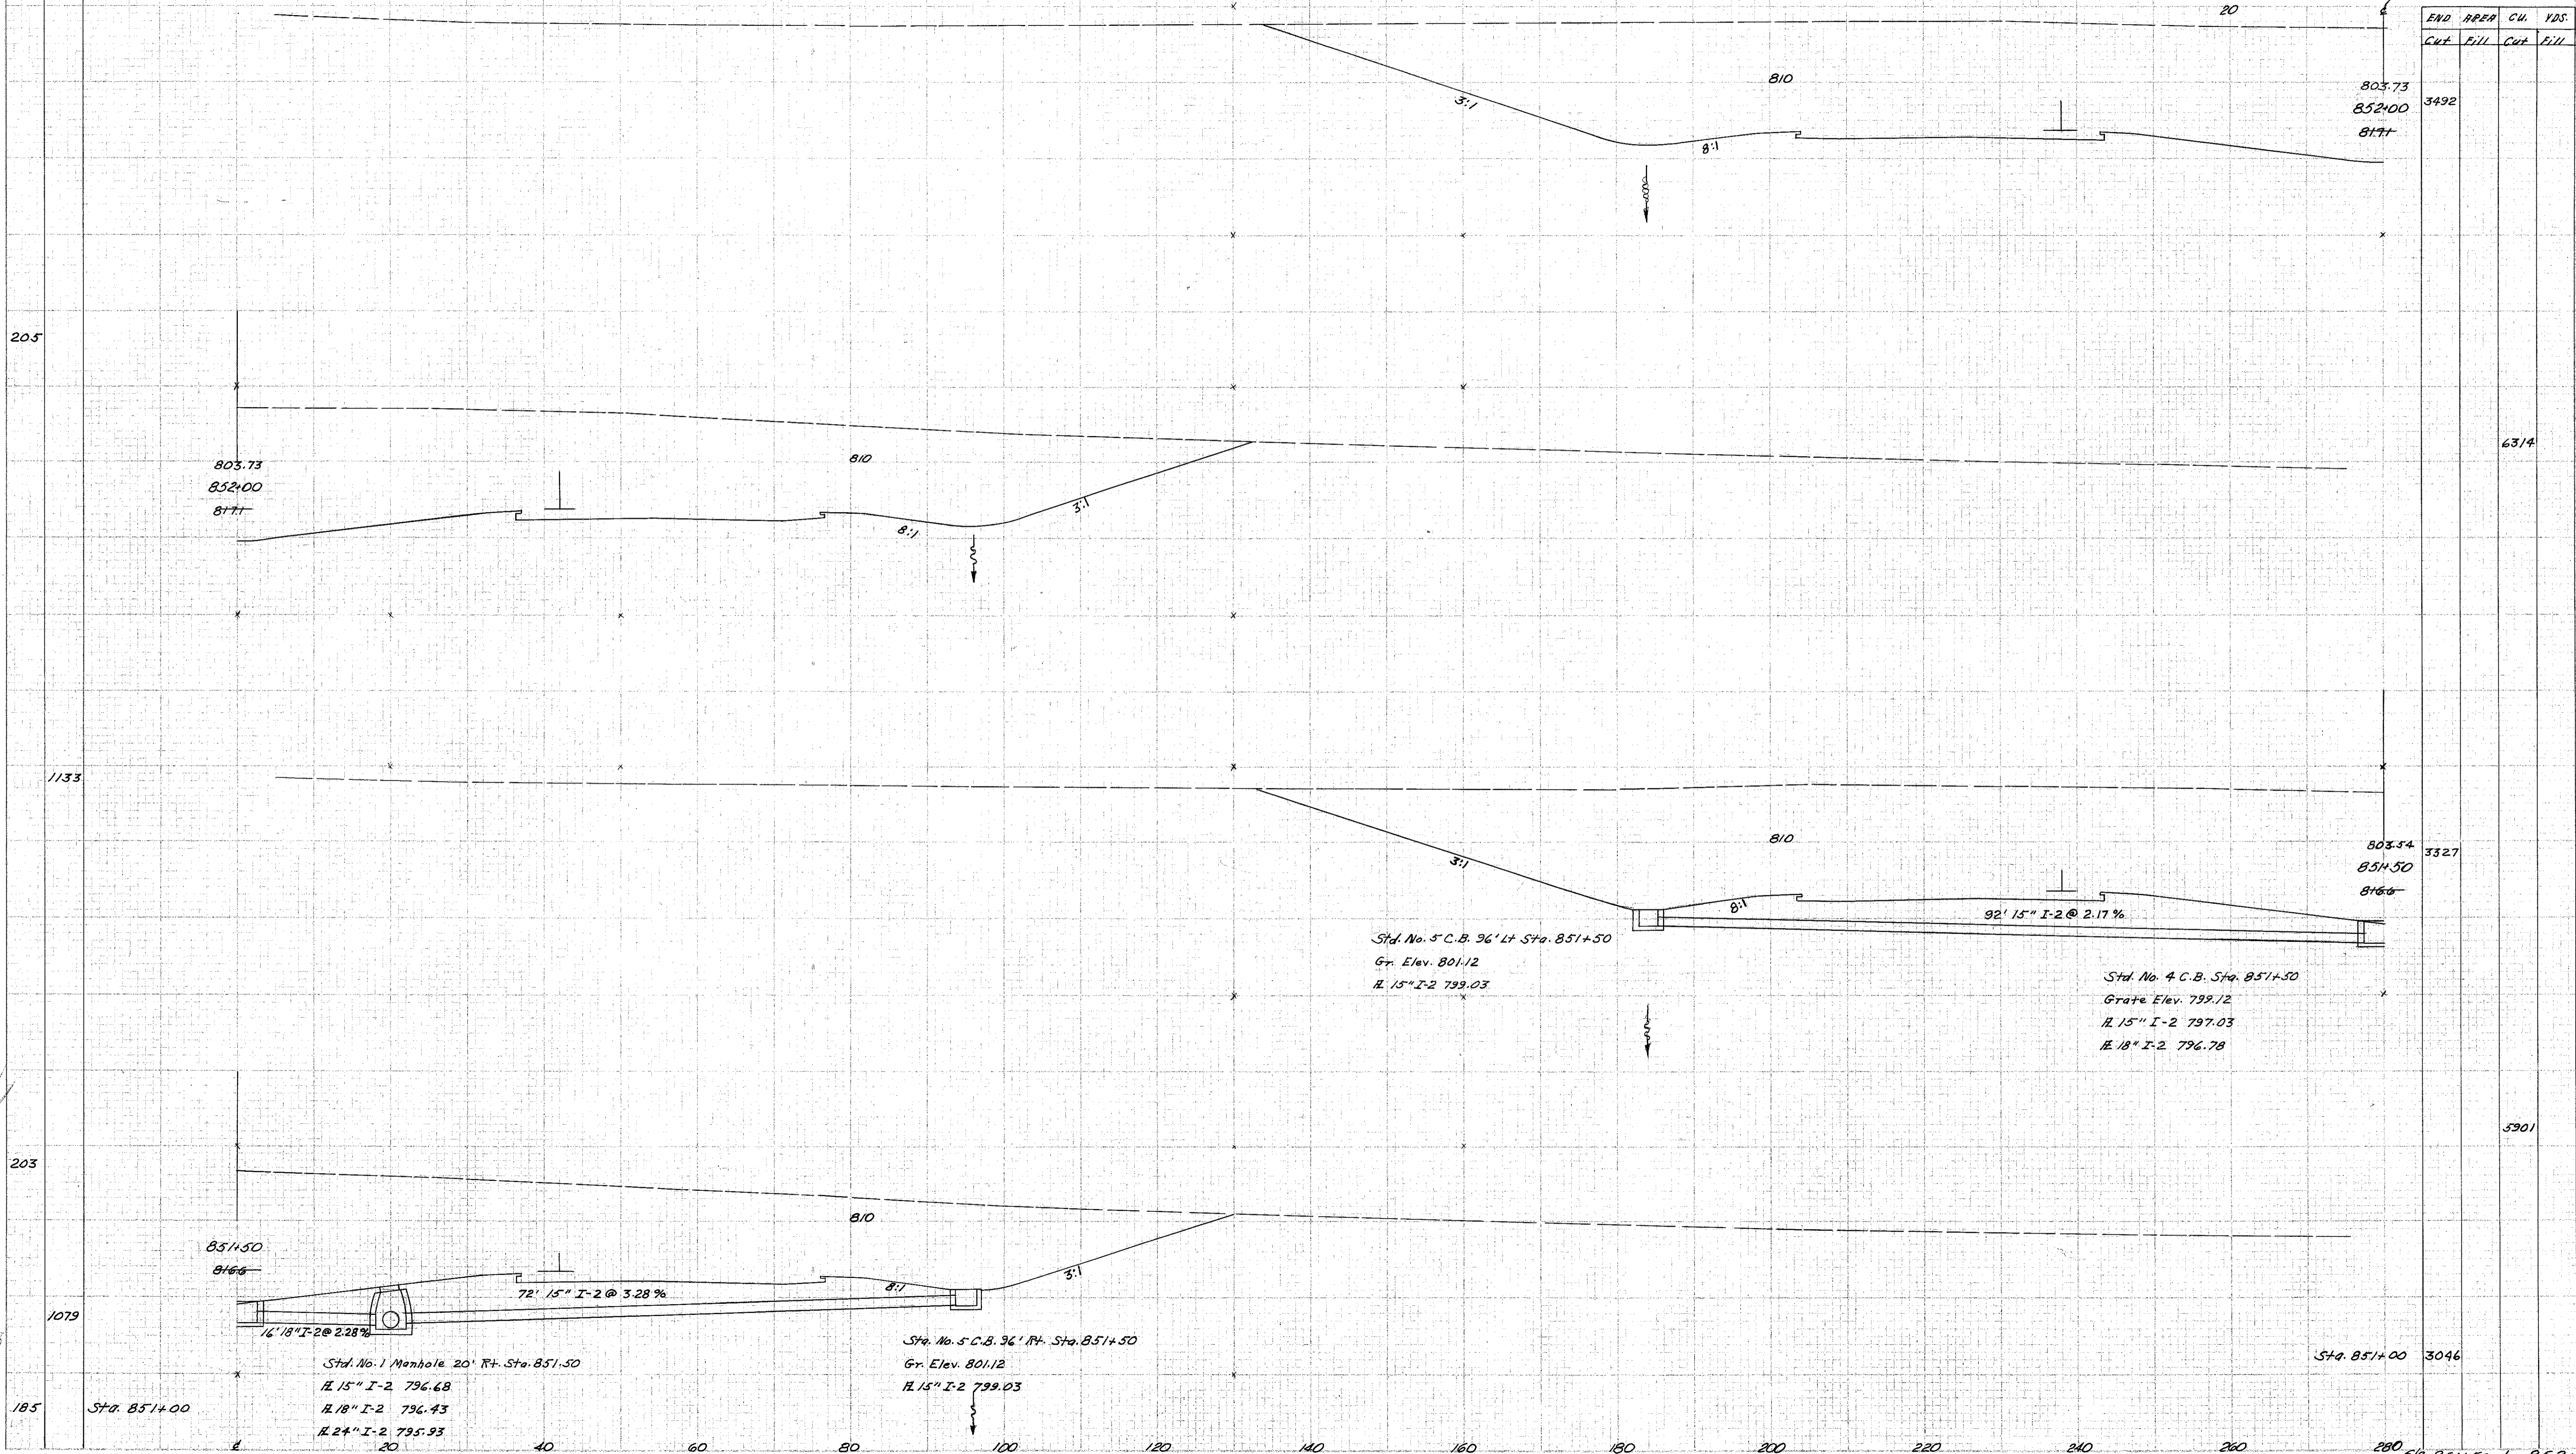

END	PREP	CW	YDS.
Cut	Fill	Cut	Fill
			3492
			6314
			3327
			3901
			3046

Rev. ✓
4-30-58

851+50
8166
16' 18" I-2 @ 2.28%
Std. No. 1 Manhole 20' R+ Sta. 851+50
Gr. Elev. 801.12
H. 15" I-2 796.68
H. 18" I-2 796.43
H. 24" I-2 795.93

Sta. No. 5 C.B. 96' R+ Sta. 851+50
Gr. Elev. 801.12
H. 15" I-2 799.03

Std. No. 5 C.B. 96' Lt Sta. 851+50
Gr. Elev. 801.12
H. 15" I-2 799.03

Std. No. 4 C.B. Sta. 851+50
Grate Elev. 799.12
H. 15" I-2 797.03
H. 18" I-2 796.78

Sta. 851+00 3046

54 851+50 to 852+00