


SEEDING
AND
WEEDING

280 260 240 220 200 180 160 140 120 100 80 60 40

FED. DIST.	STATE	PROJECT
2	OHIO	AGE-1103 (29)

51
280

LAKE COUNTY
LAK-1-22.60

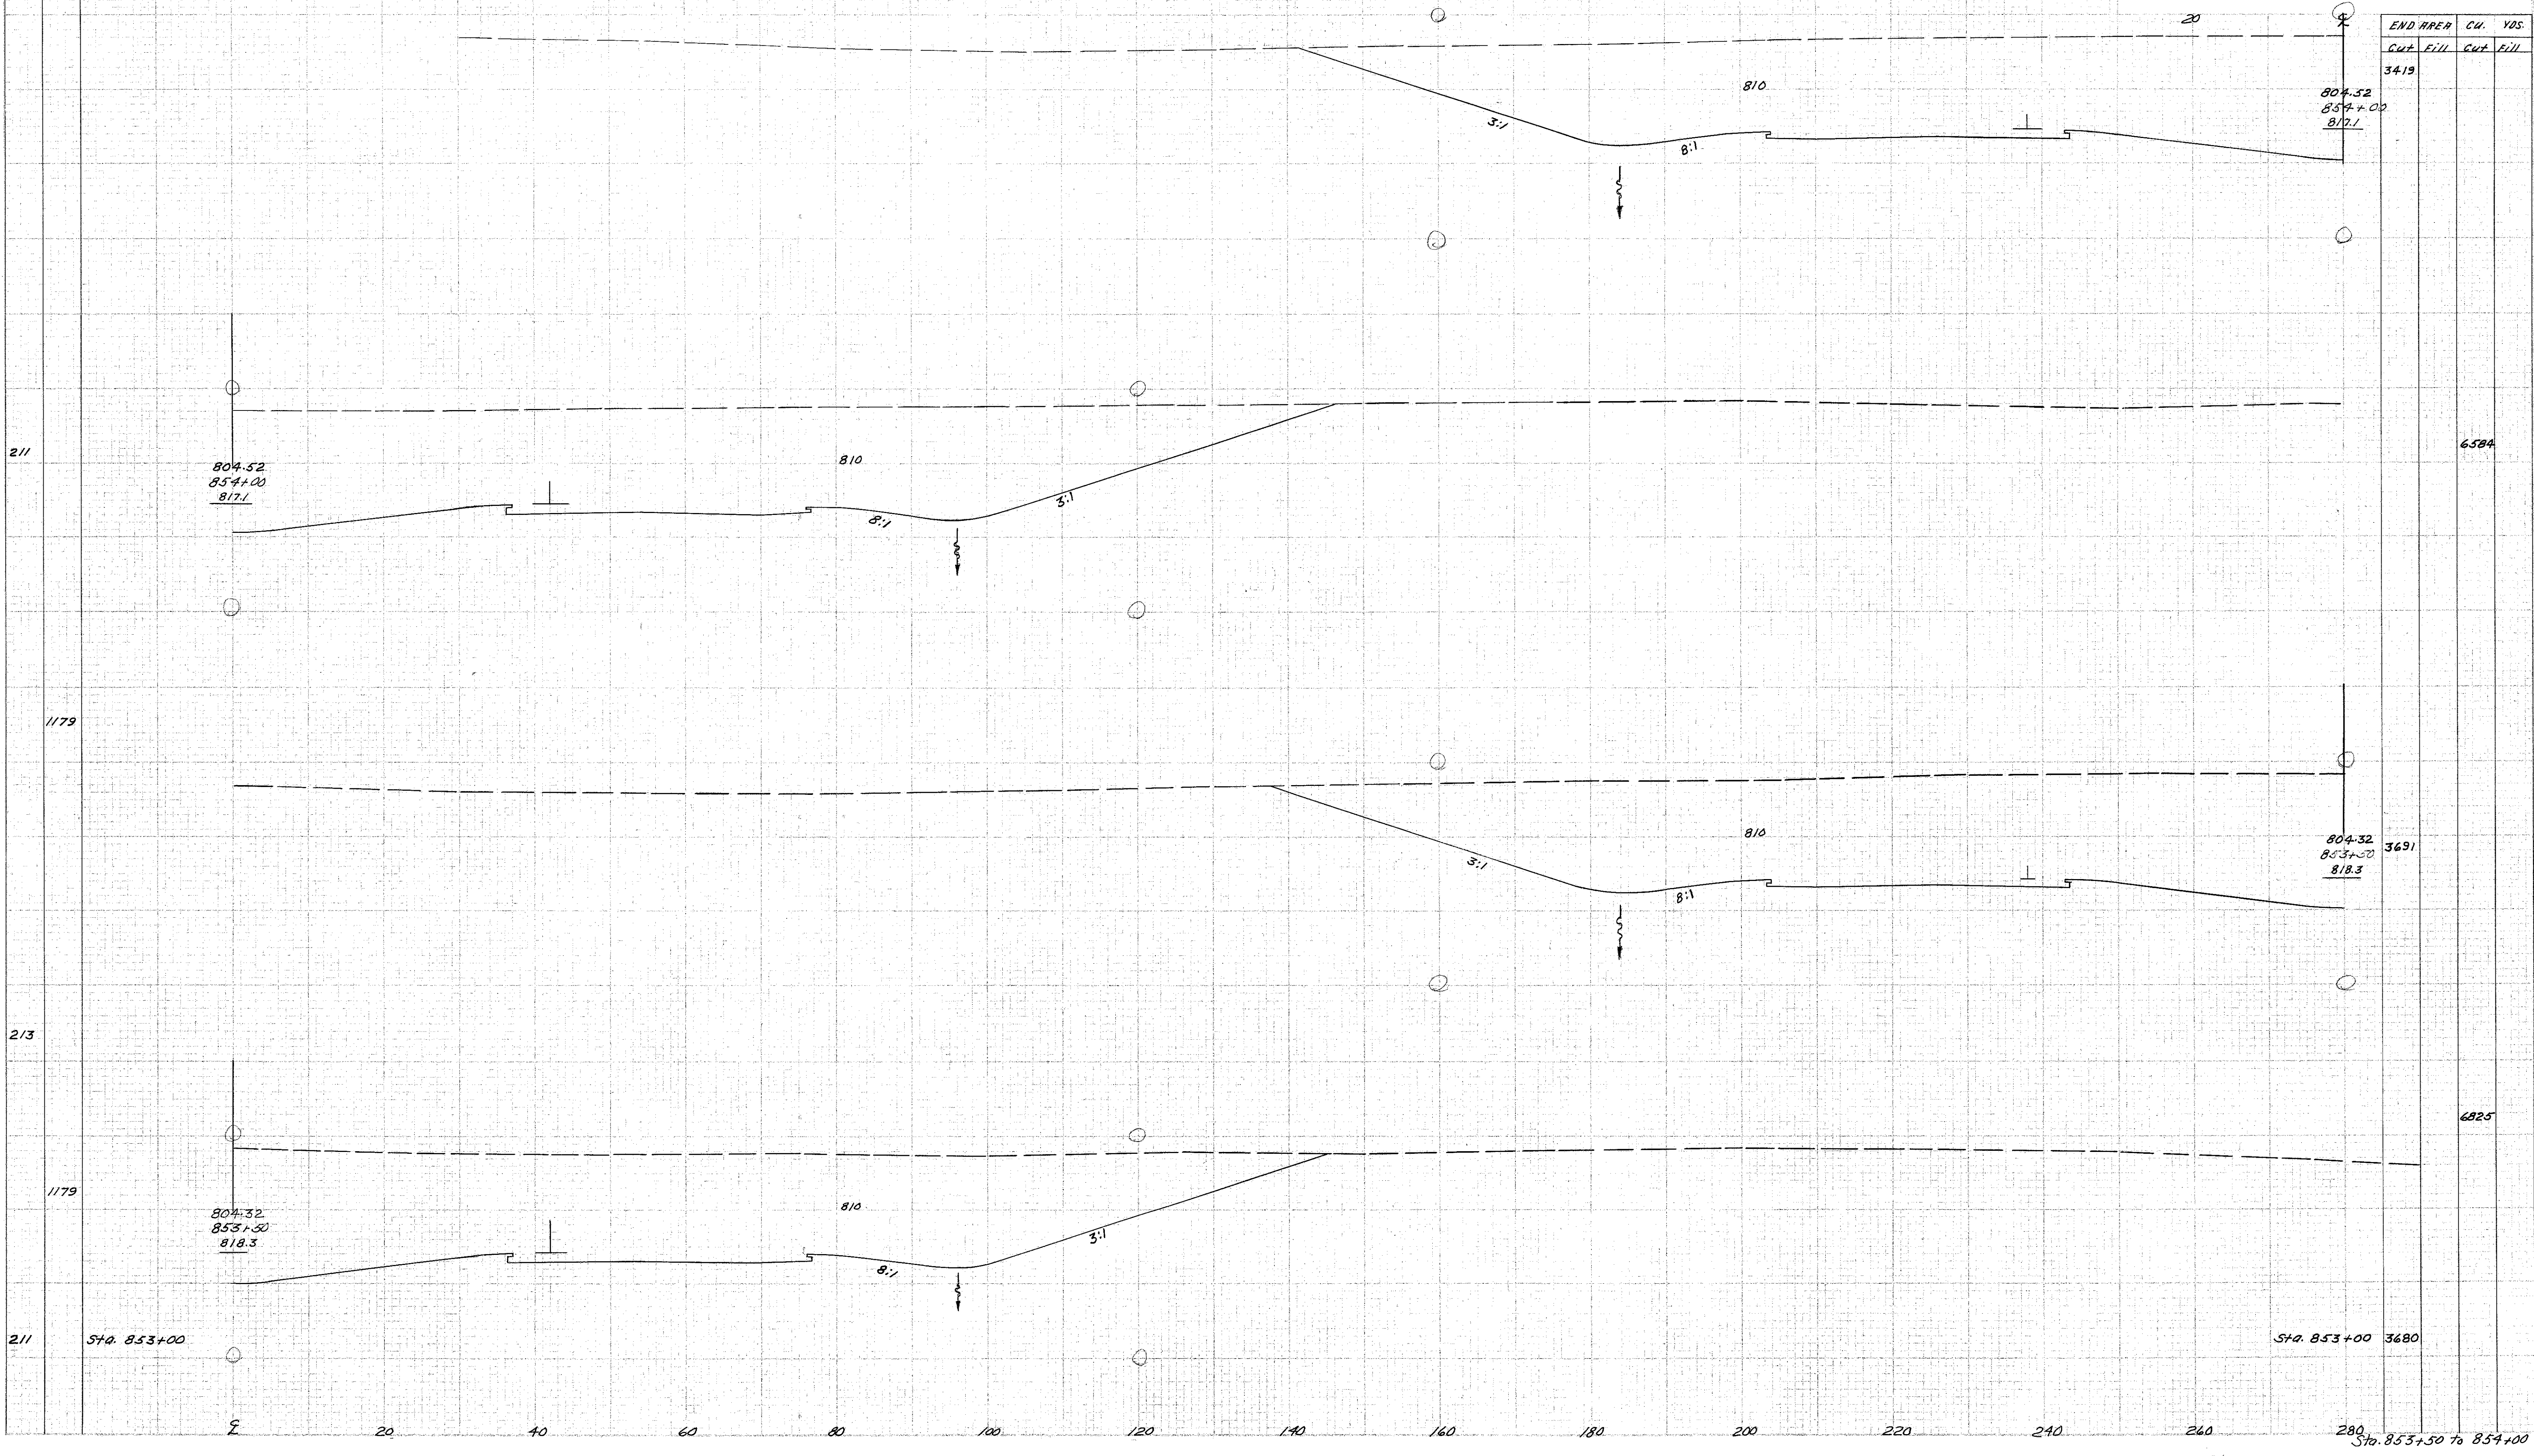

REVISED
4-30-58

Rev
4-30-58

5613