


SEEDING
FWD. WEATH. SQ. YDS.

REV. SHEET NO.	NO. OF SHEETS	SHEET NO.	57
2	0	HCI-1103 (29)	280

LAKE COUNTY
LAK-1-22.60

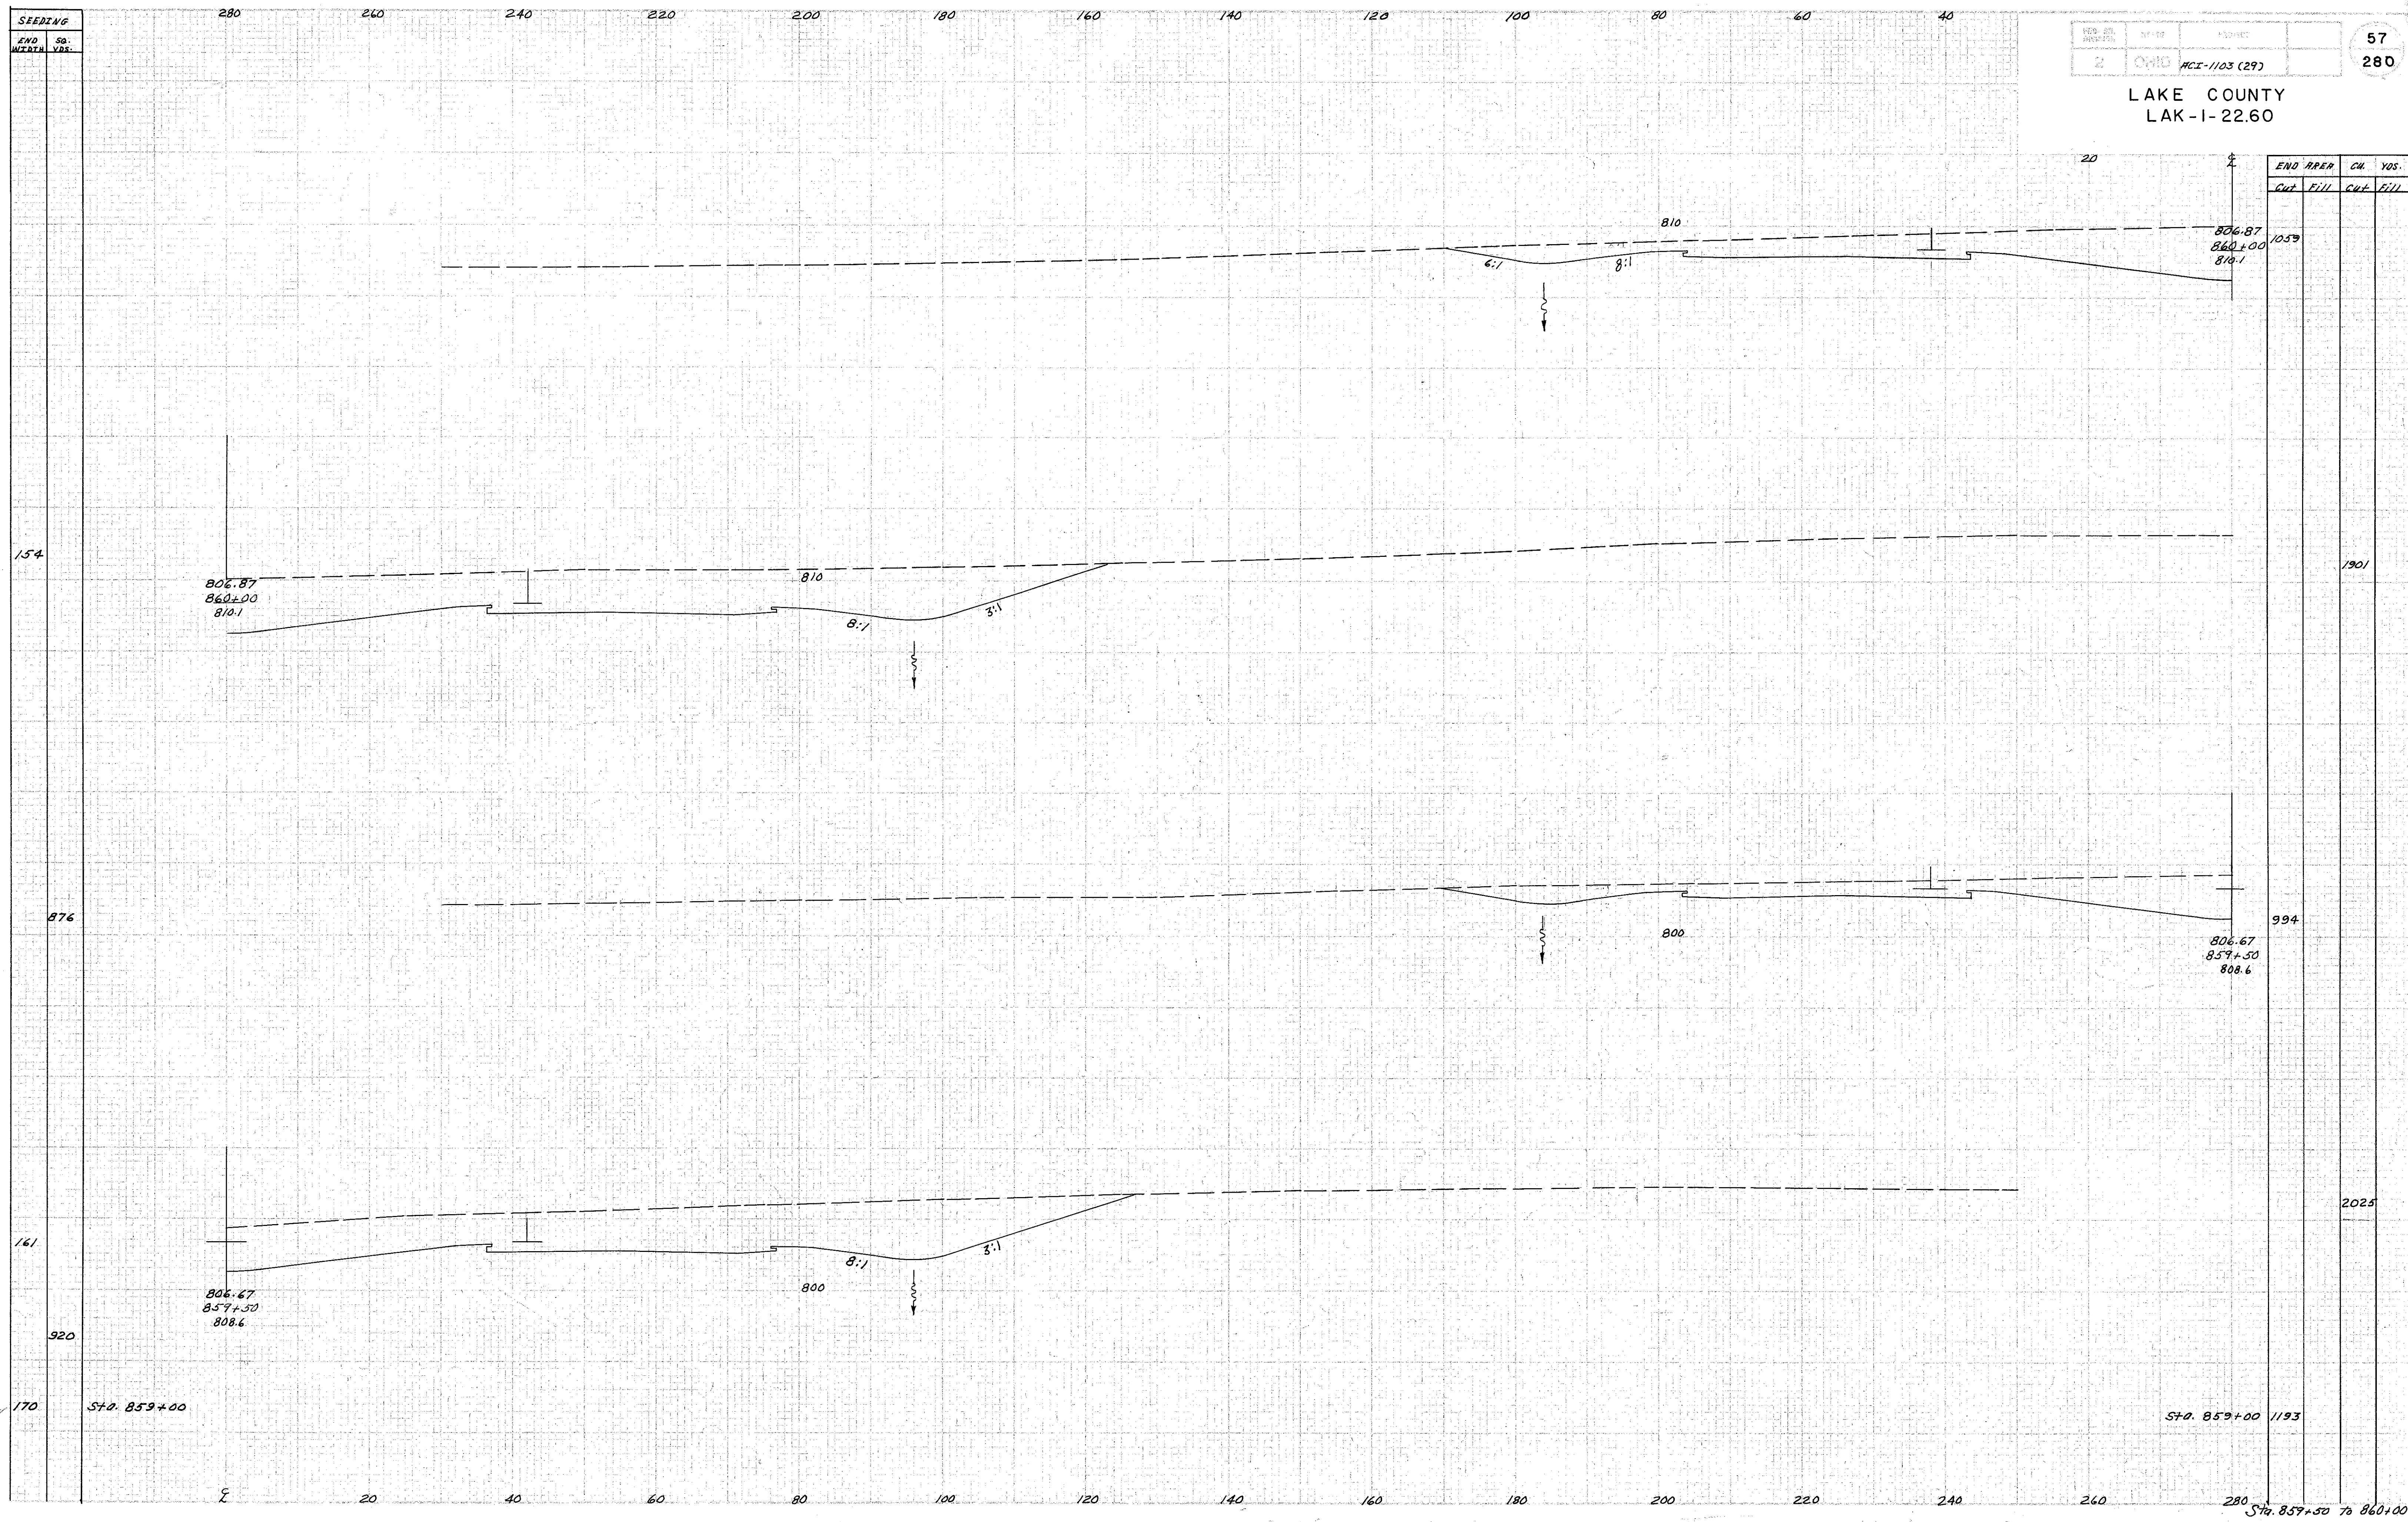

2

REVISED
7-30-58

Rev
7-30-58