


SEEDING

END STA. MARKED

DATE	PROJECT
2	PCI-1103 (29)

65  
280

LAKE COUNTY  
LAK-1-2260

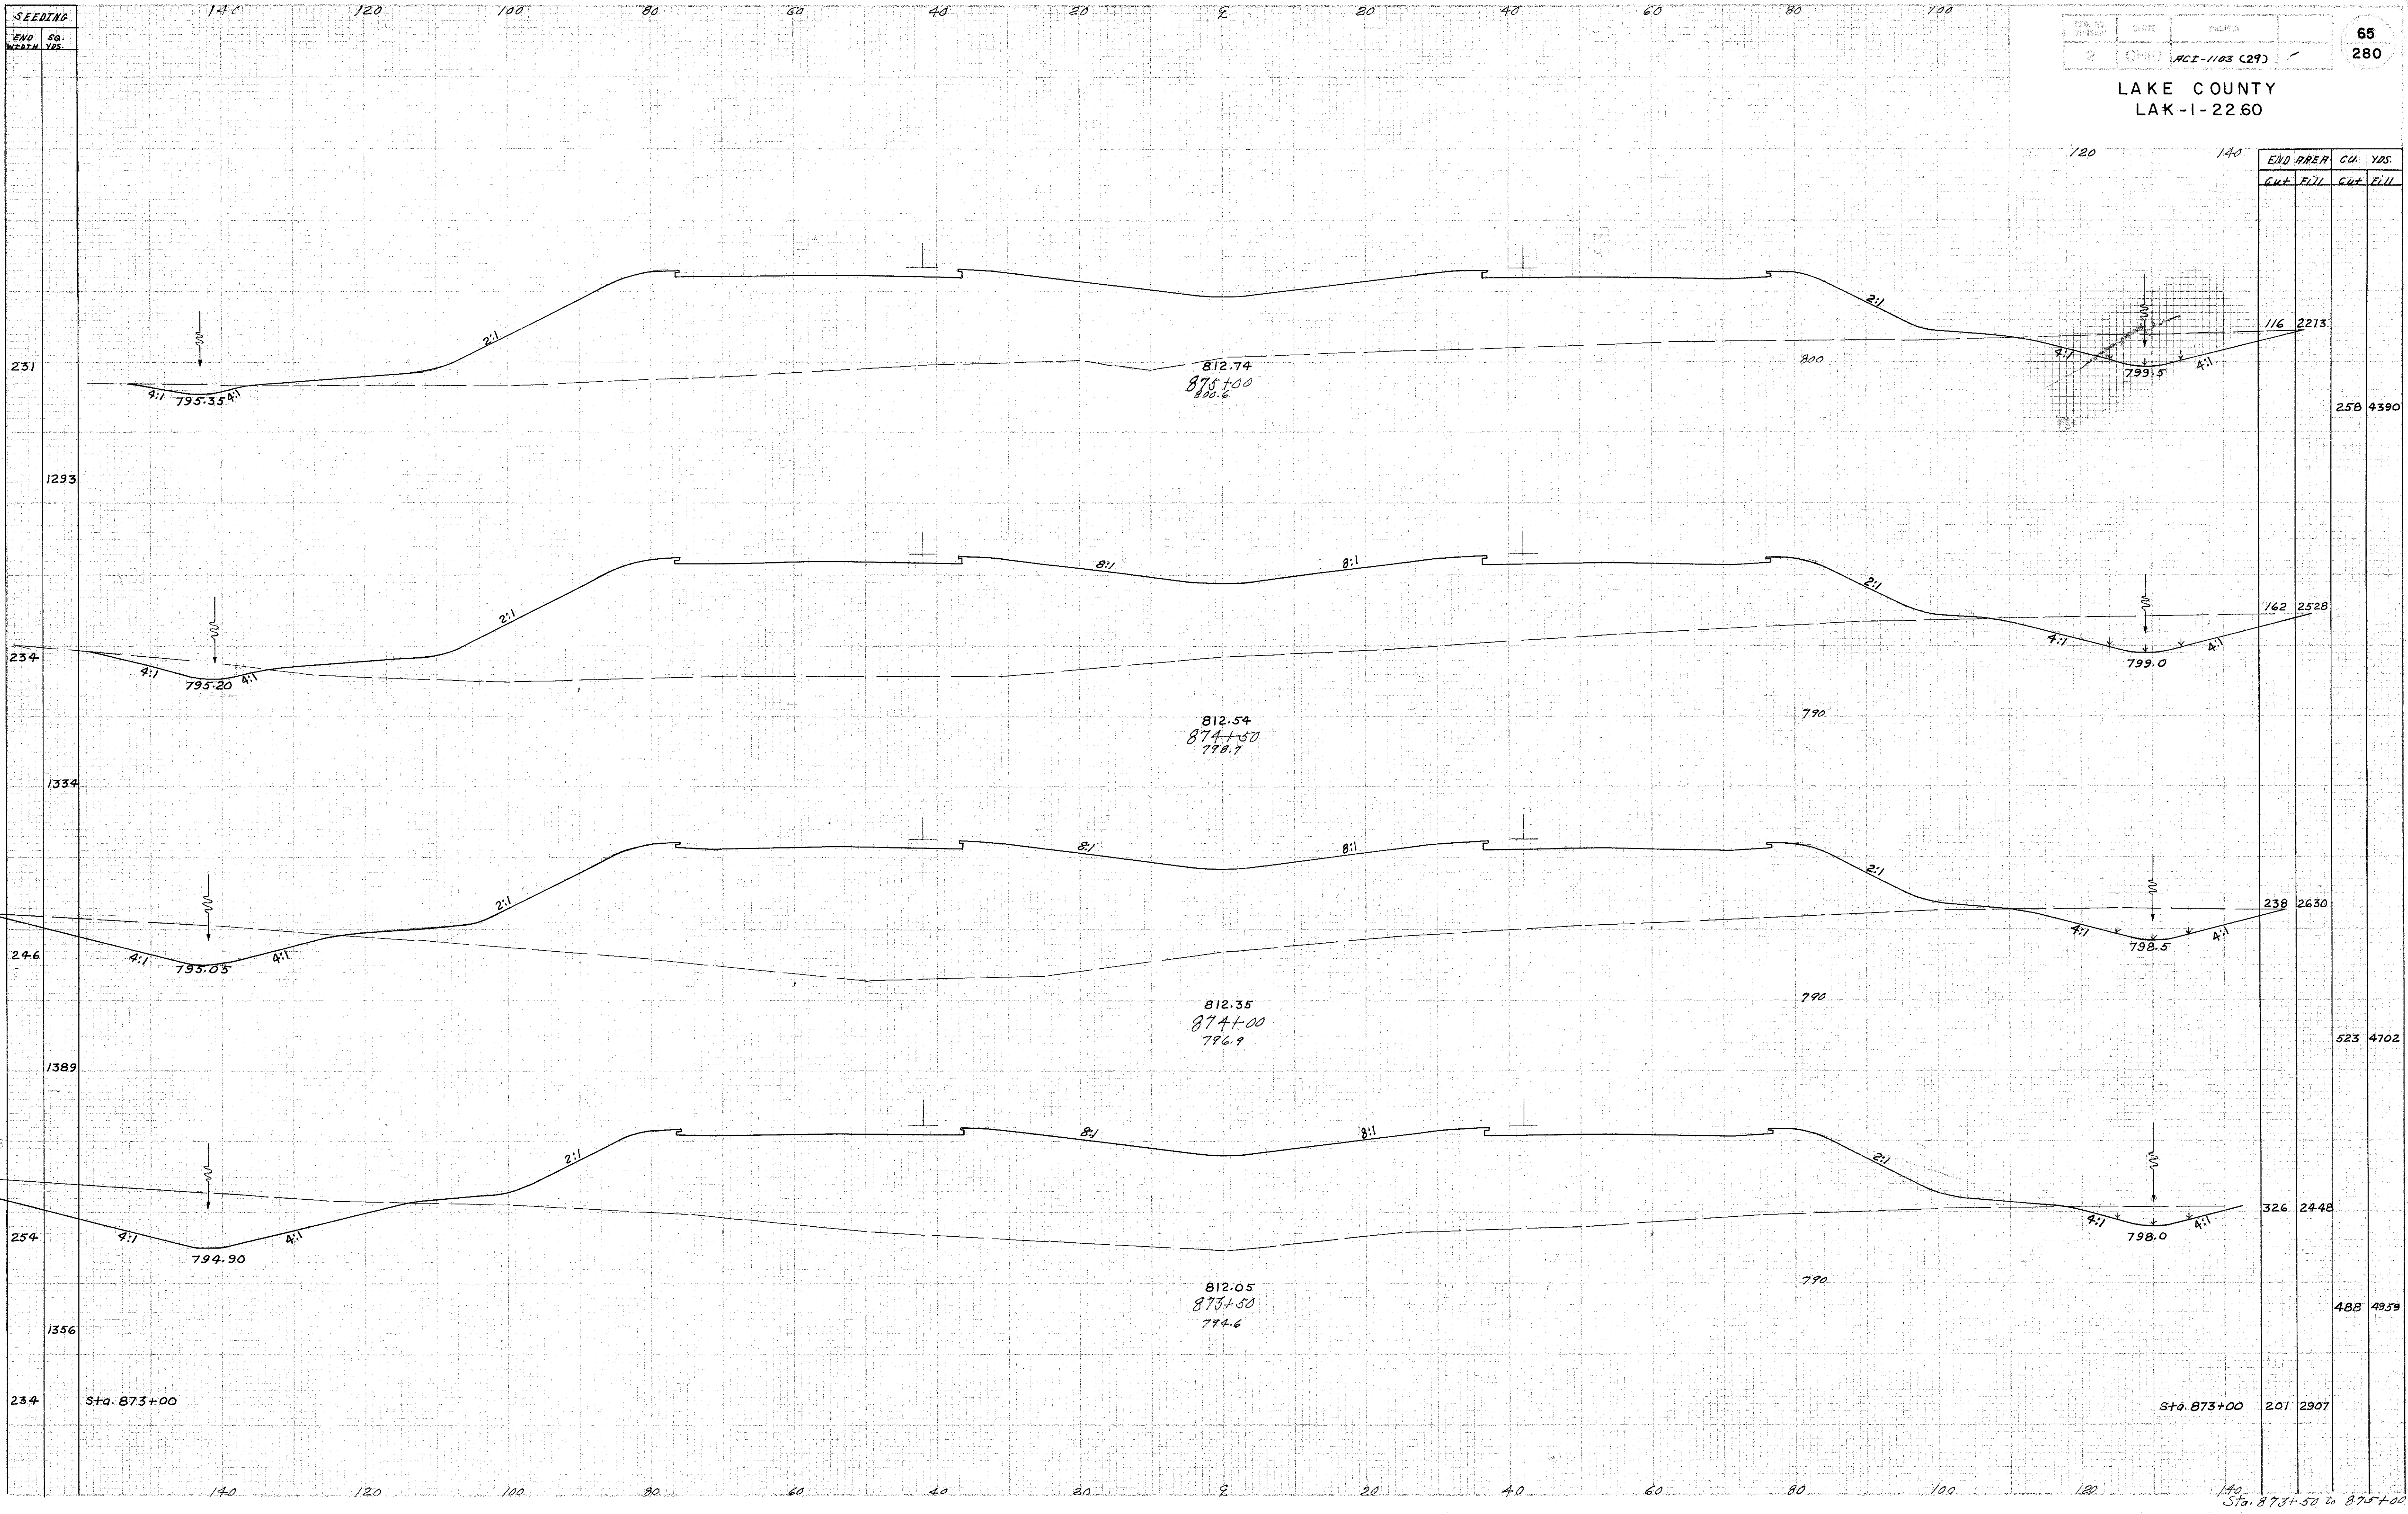

Rev.  
4-30-58

Sta. 873+50 to 875+00