
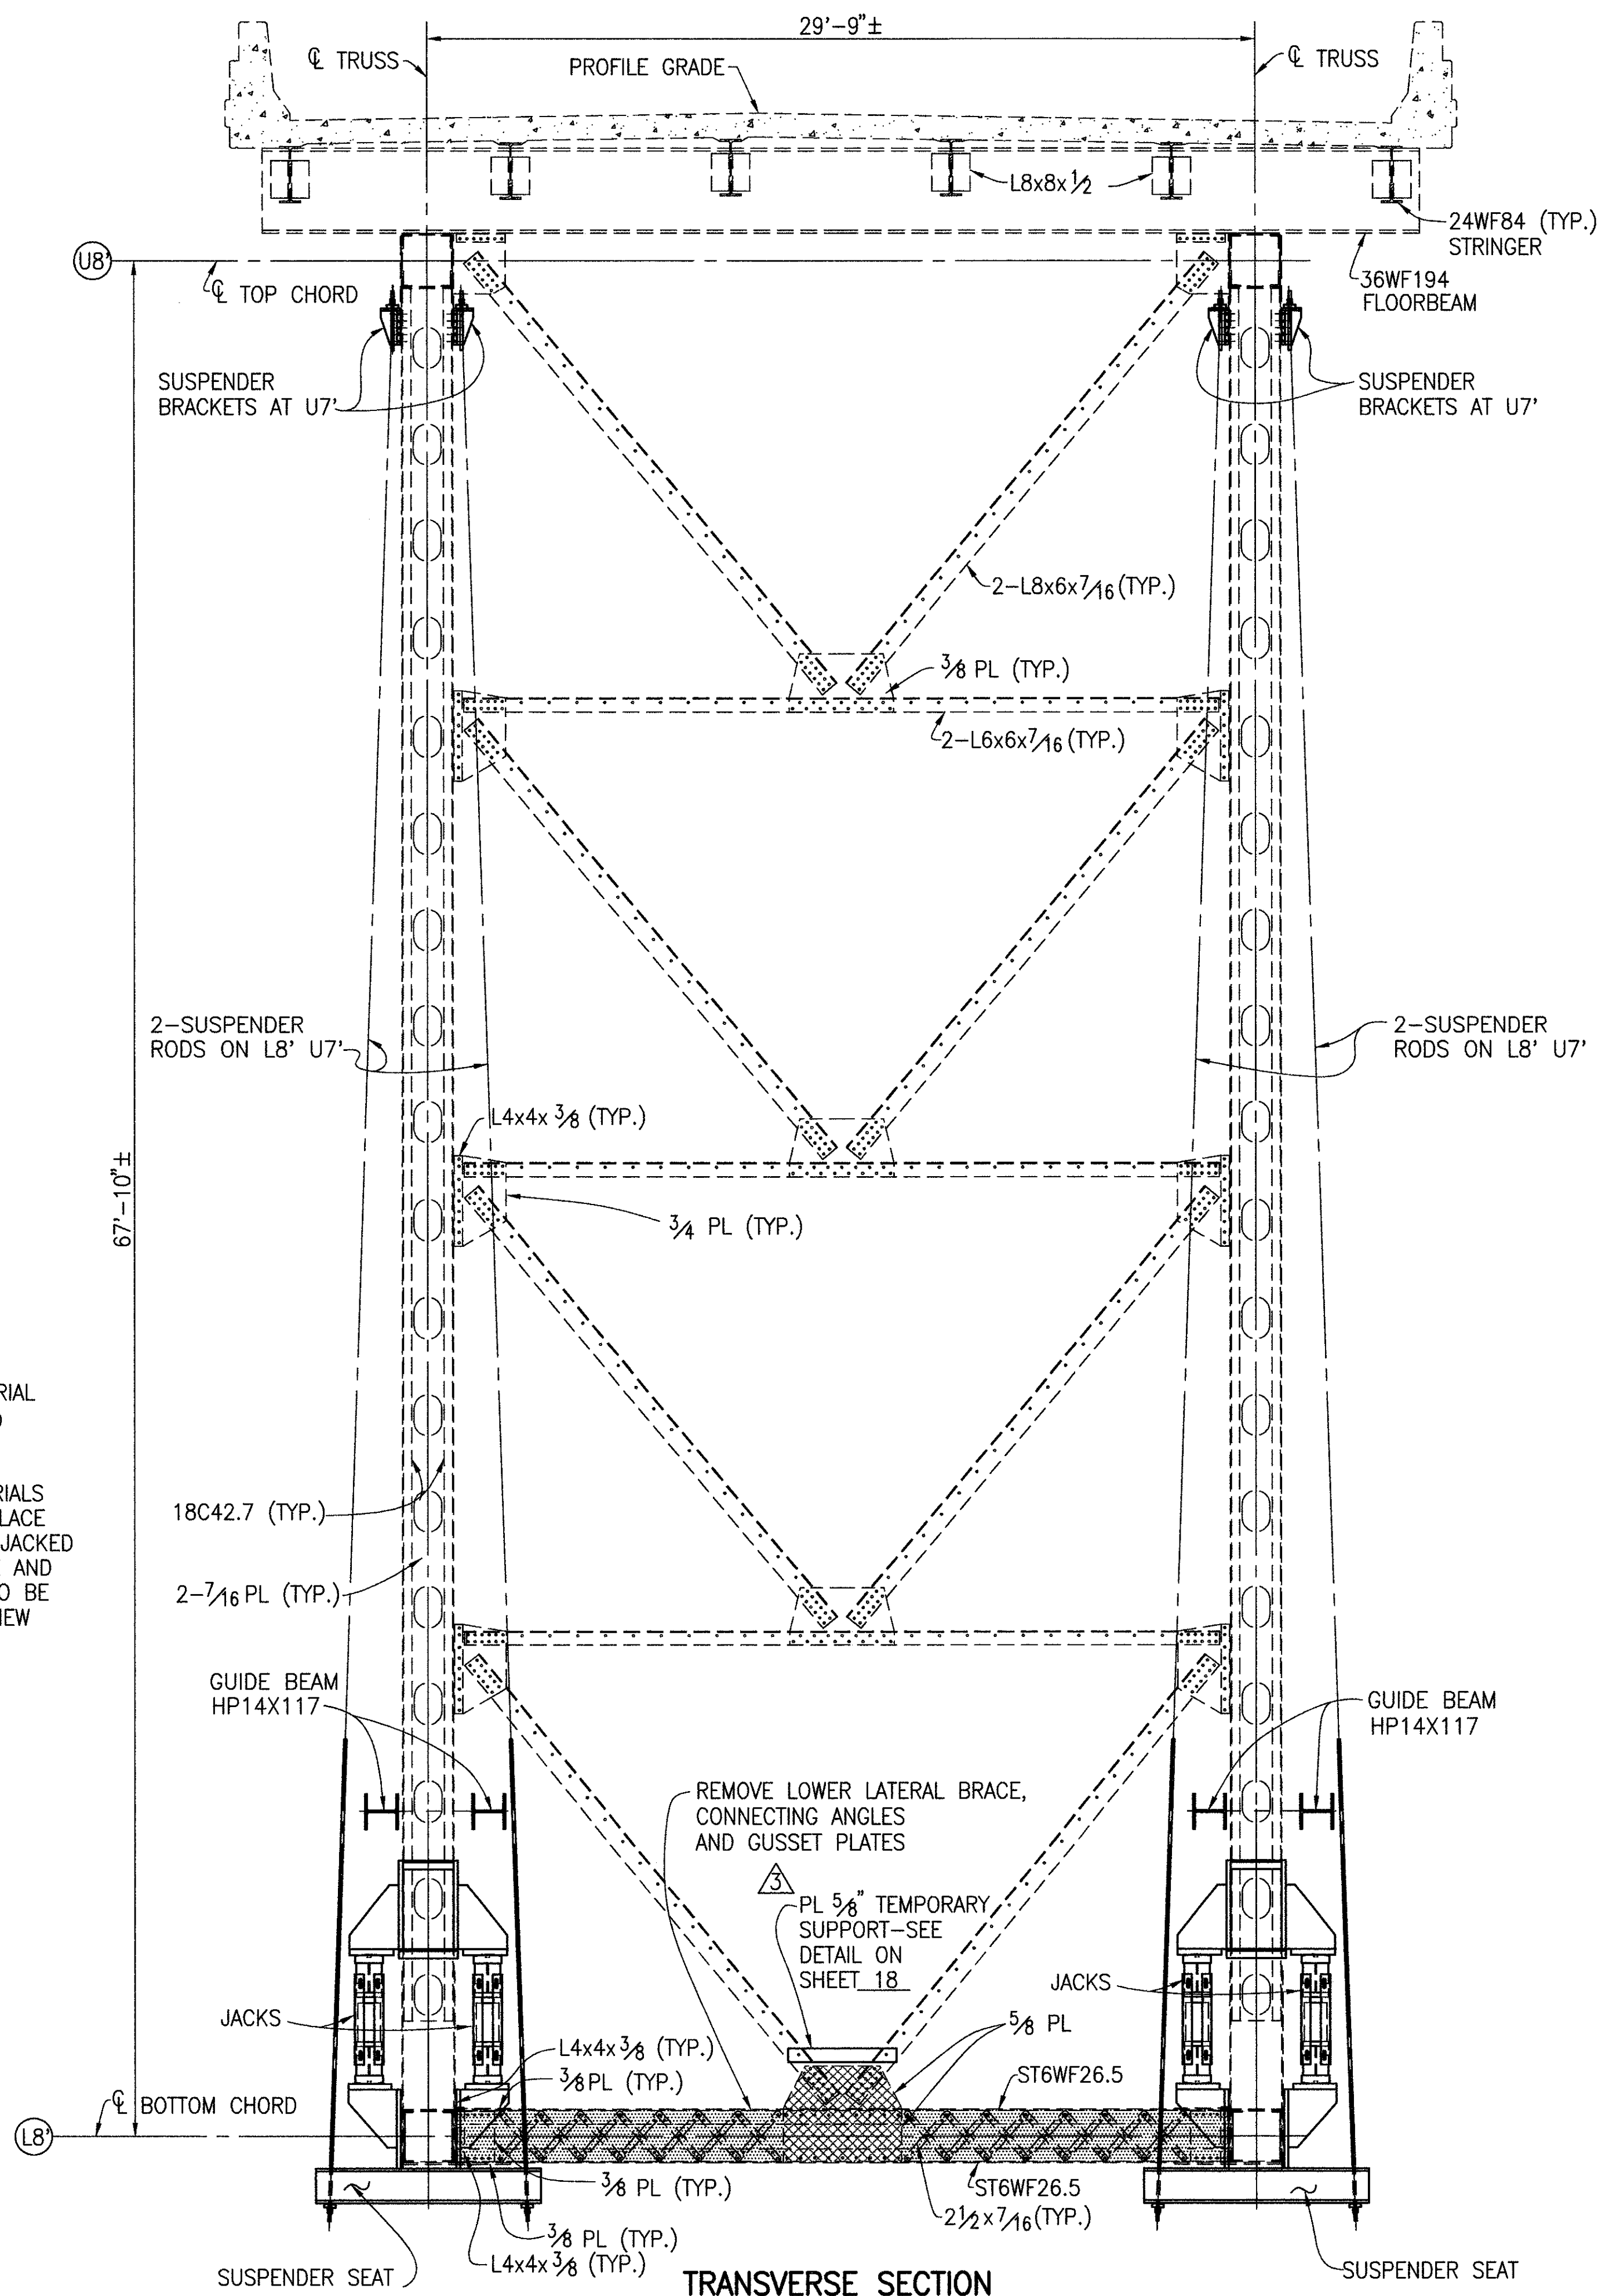



Job No. 96073P8 Date 3/12/97 Drawn By KH, KAK, JPS, TWH, JPS

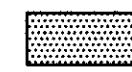

 INDICATES MATERIAL TO BE REMOVED  
 INDICATES MATERIALS TO BE LEFT IN PLACE UNTIL BRIDGE IS JACKED BACK INTO PLACE AND THEN REMOVED TO BE REPLACED WITH NEW MATERIAL.

TRANSVERSE SECTION

DATE	7/10/96
REVIEWED	DAP
DESIGNED	DM
DRAWN	KH
CHECKED	RWR
STRUCTURE FILE NO.	4304985
REVISED	2/20/97

TRANSVERSE SECTION  
 BRIDGE NO. LAK-90-2342 R  
 OVER THE GRAND RIVER

LAK-90-23.42 (L&R)