


Bolts in panel adjacent to end shoe shall be tightened for expansion, as per section 606.05.

TYPE G CONNECTION
(2-Way Cross Road)

See sheet 45 for pertinent notes including *POSTS note.

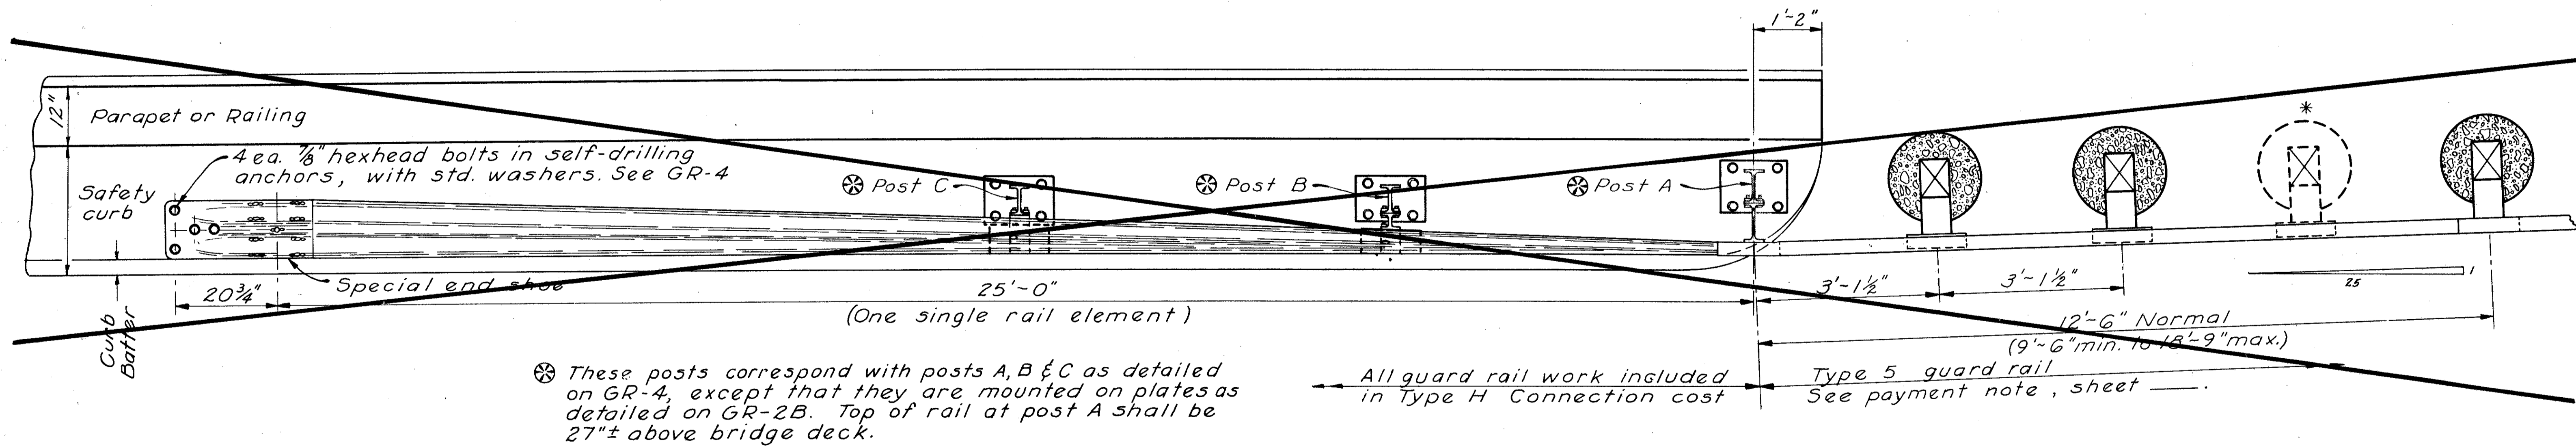

⊗ These posts correspond with posts A, B & C as detailed on GR-4, except that they are mounted on plates as detailed on GR-2B. Top of rail at post A shall be 27"± above bridge deck.

TYPE H CONNECTION