


QUANTITIES
 Made: REM 5-12-72
 Ckd: RAE 6-1-72

FED. RD. DIVISION	STATE	PROJECT	87
5	OHIO		III

LAKE COUNTY
 LAK-90-3.56

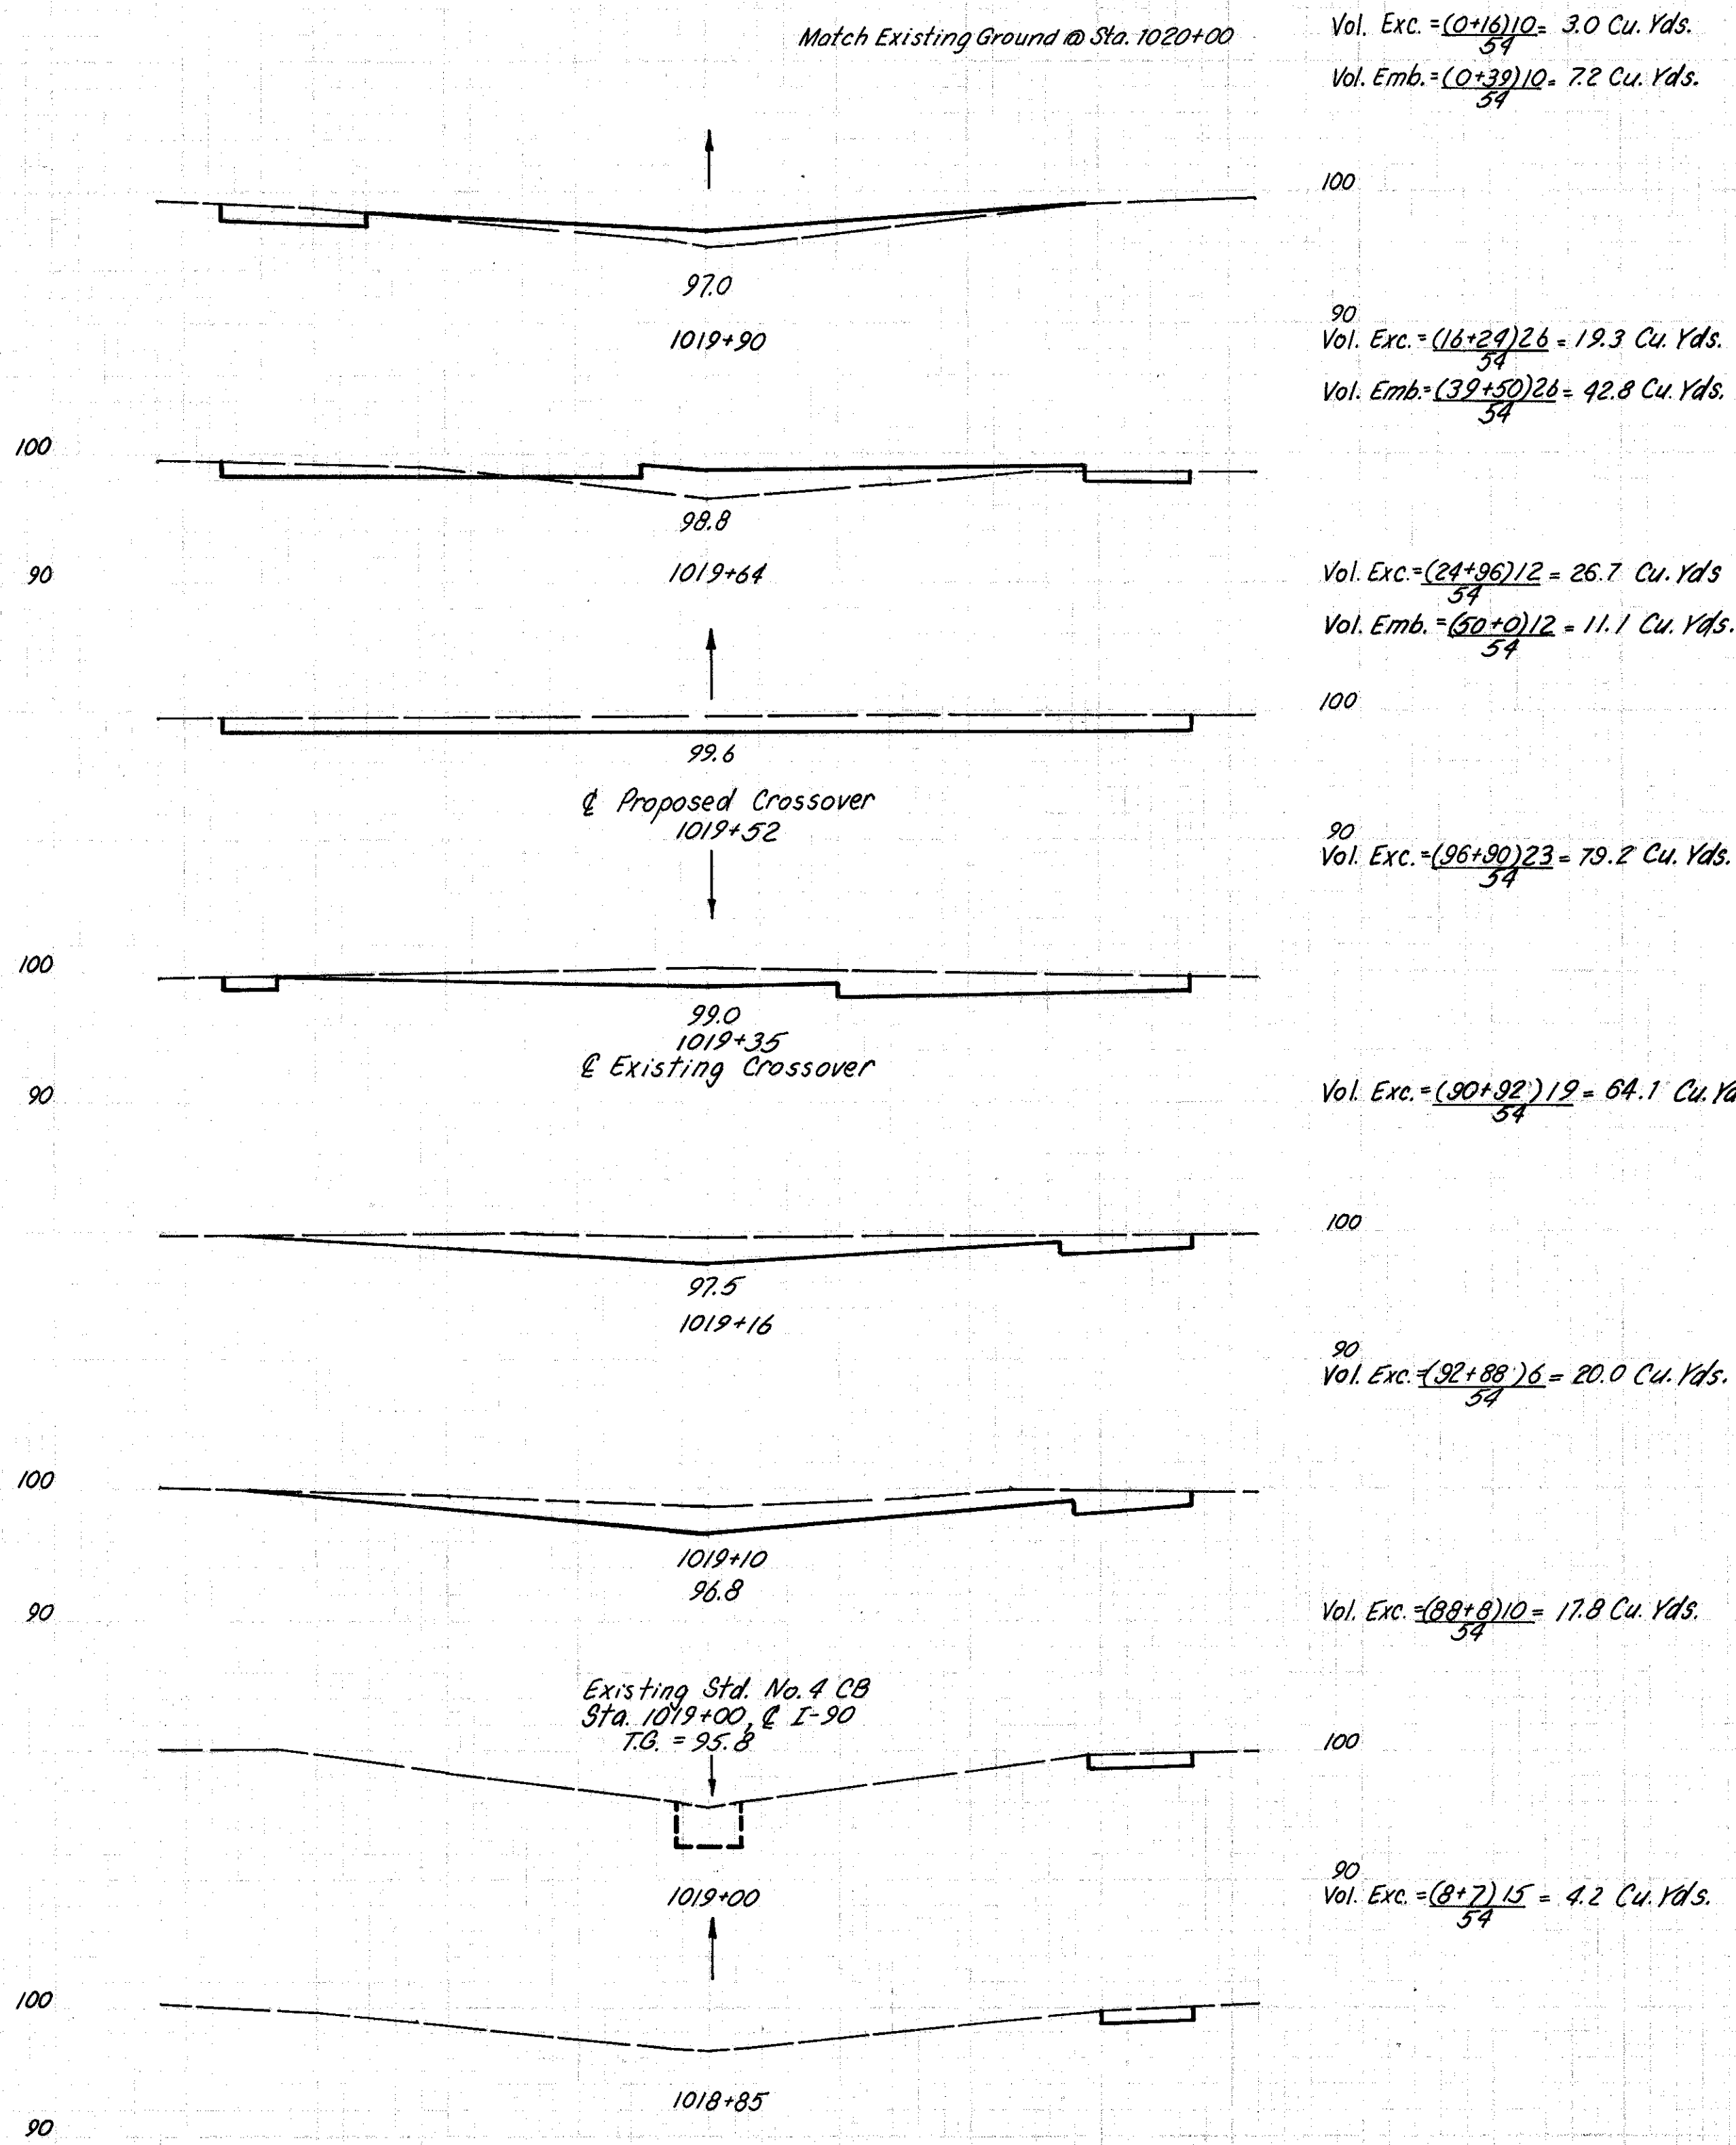










TOTAL VOLUME
 Excavation = 234 Cubic Yards
 Embankment = 61 Cubic Yards
 Seeding & Mulching = 425 Sq. Yds.
 (For Plan View See Sheet 28.)

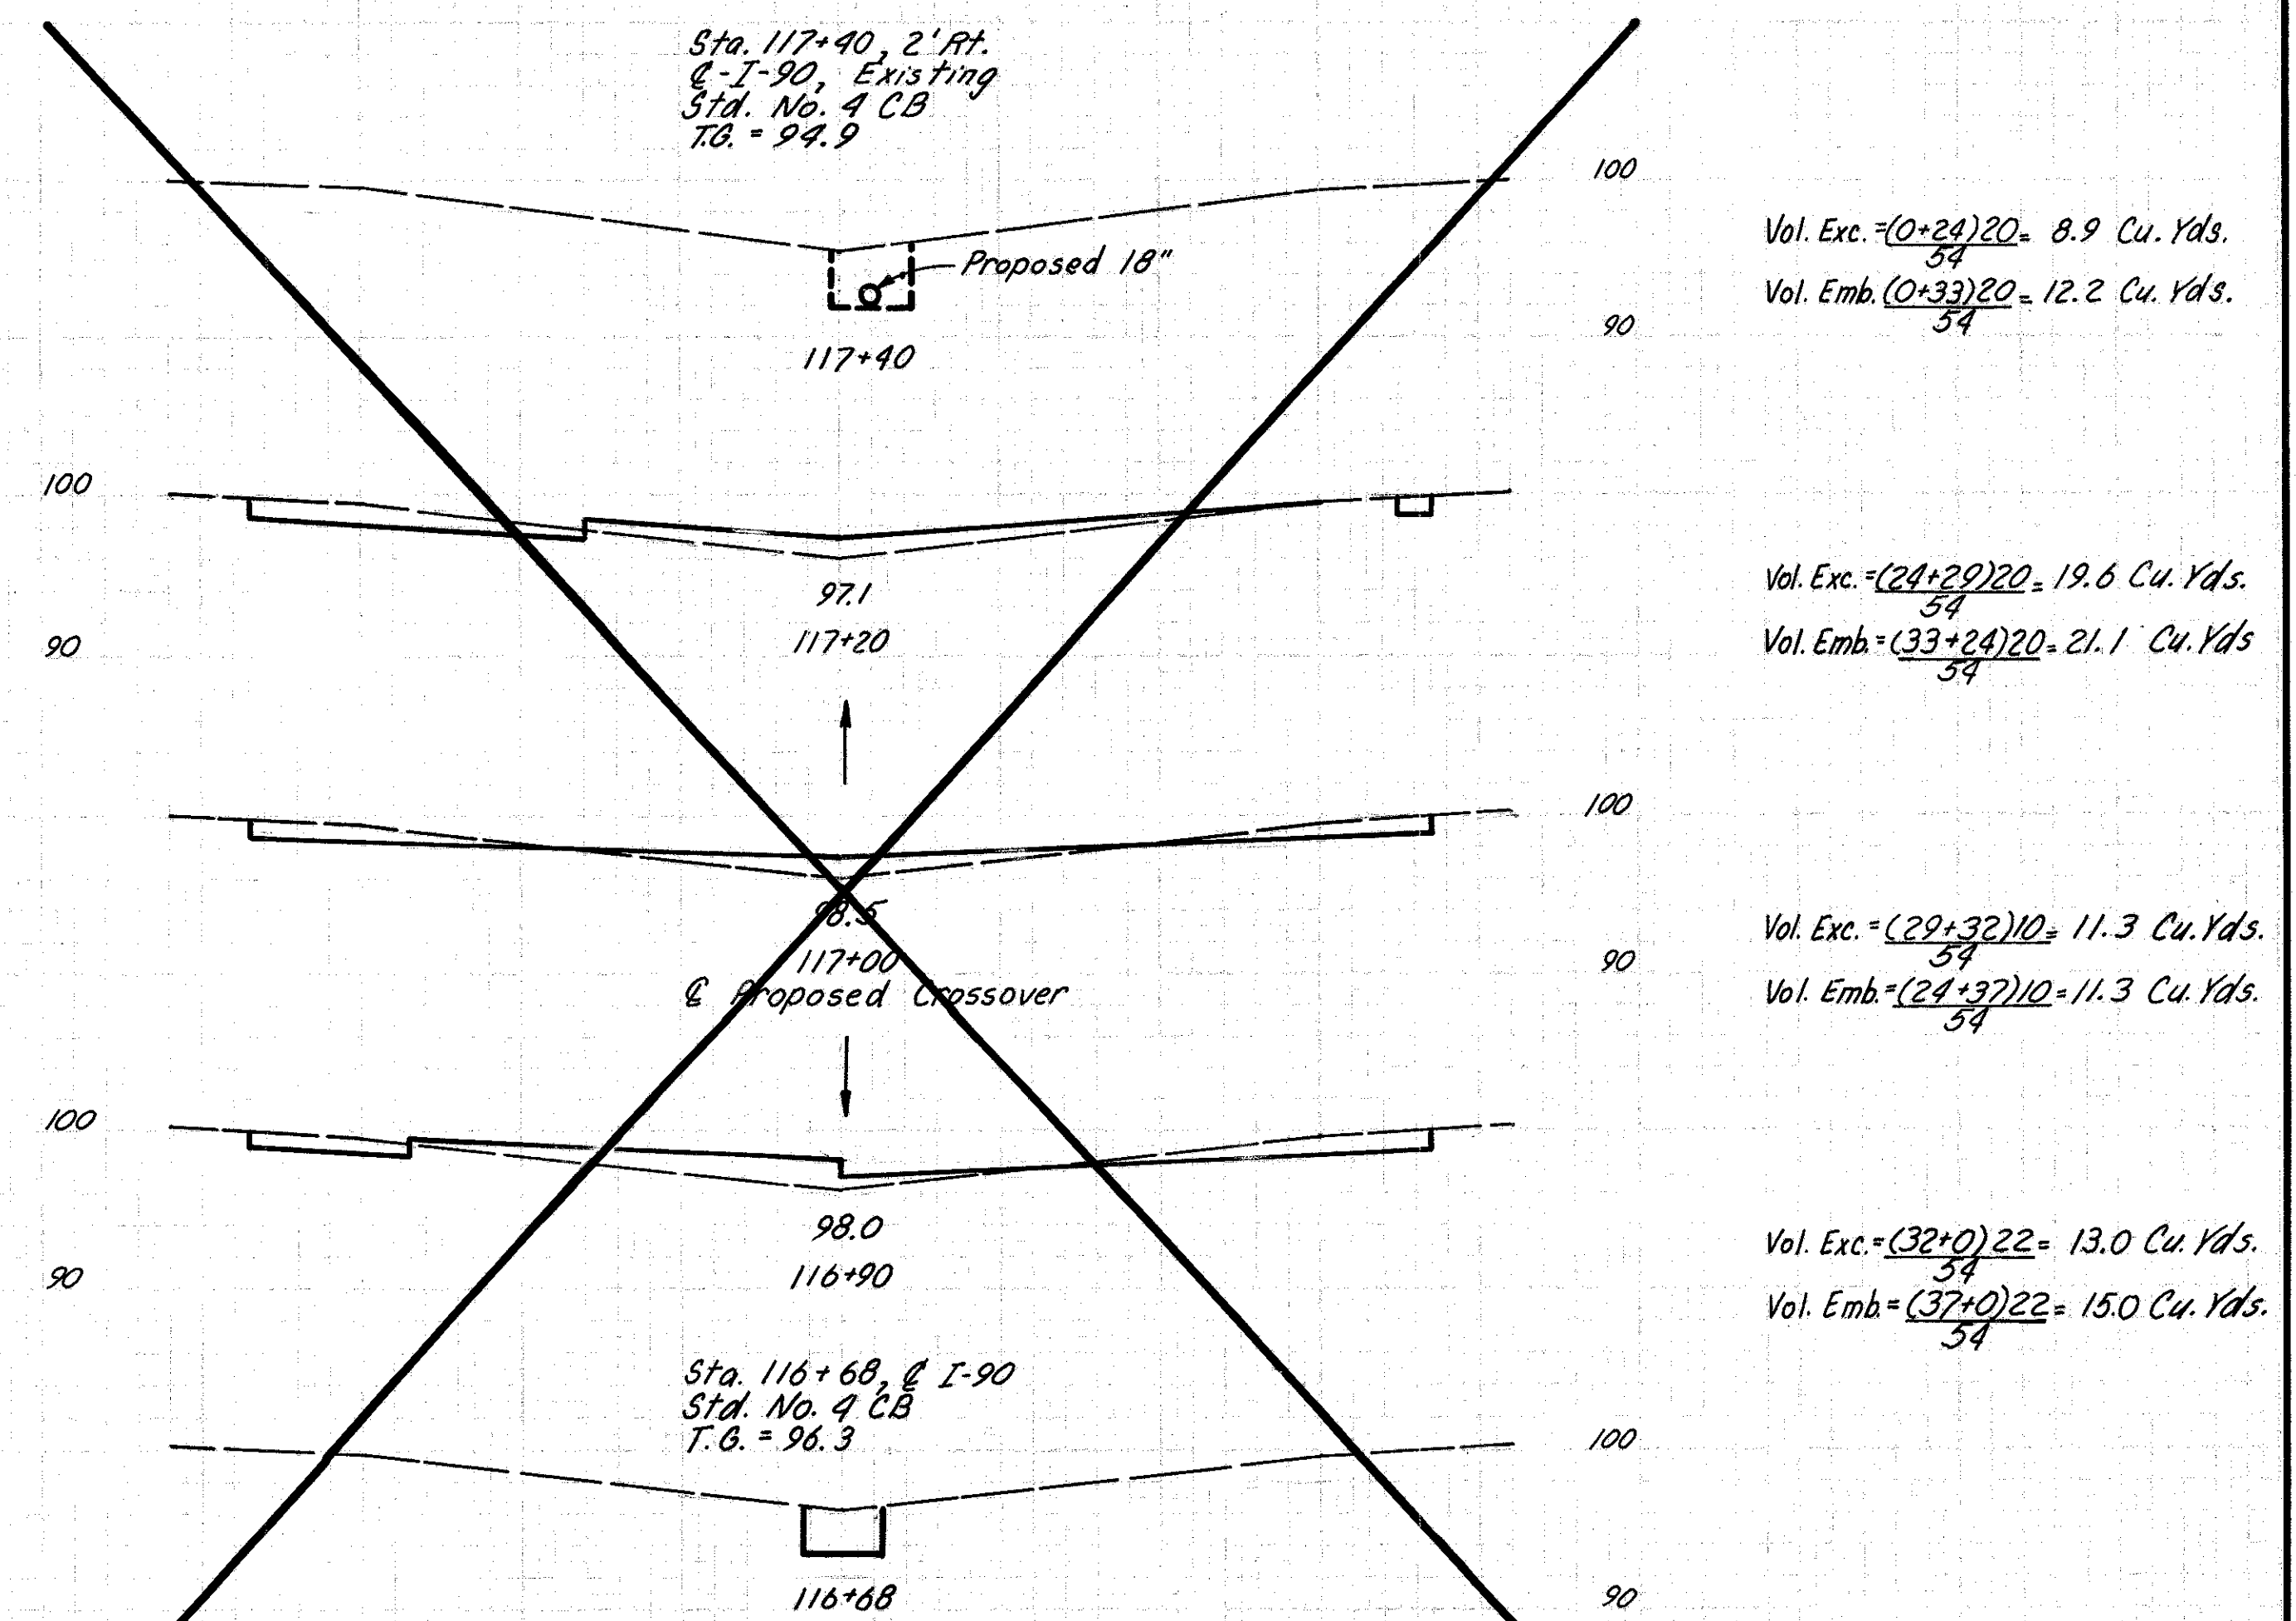





At Sta. 117+00, West Bound Lane, Left Edge of Pavement, Elevation = 100.00

S-105
 VOID

~~TOTAL VOLUME
 Excavation = 53 Cubic Yards
 Embankment = 60 Cubic Yards
 Seeding & Mulching = 147 Sq. Yds.
 (For Plan View See Sheet 30.)~~

At 1018+00 West Bound Lane, Left Edge of Pavement, Elevation = 100.00

HOWARD, NEEDLES, TAMMEN & BERGENDOFF
 CONSULTING ENGINEERS
 KANSAS CITY CLEVELAND NEW YORK