



Cross Section
 Sta. 631+00

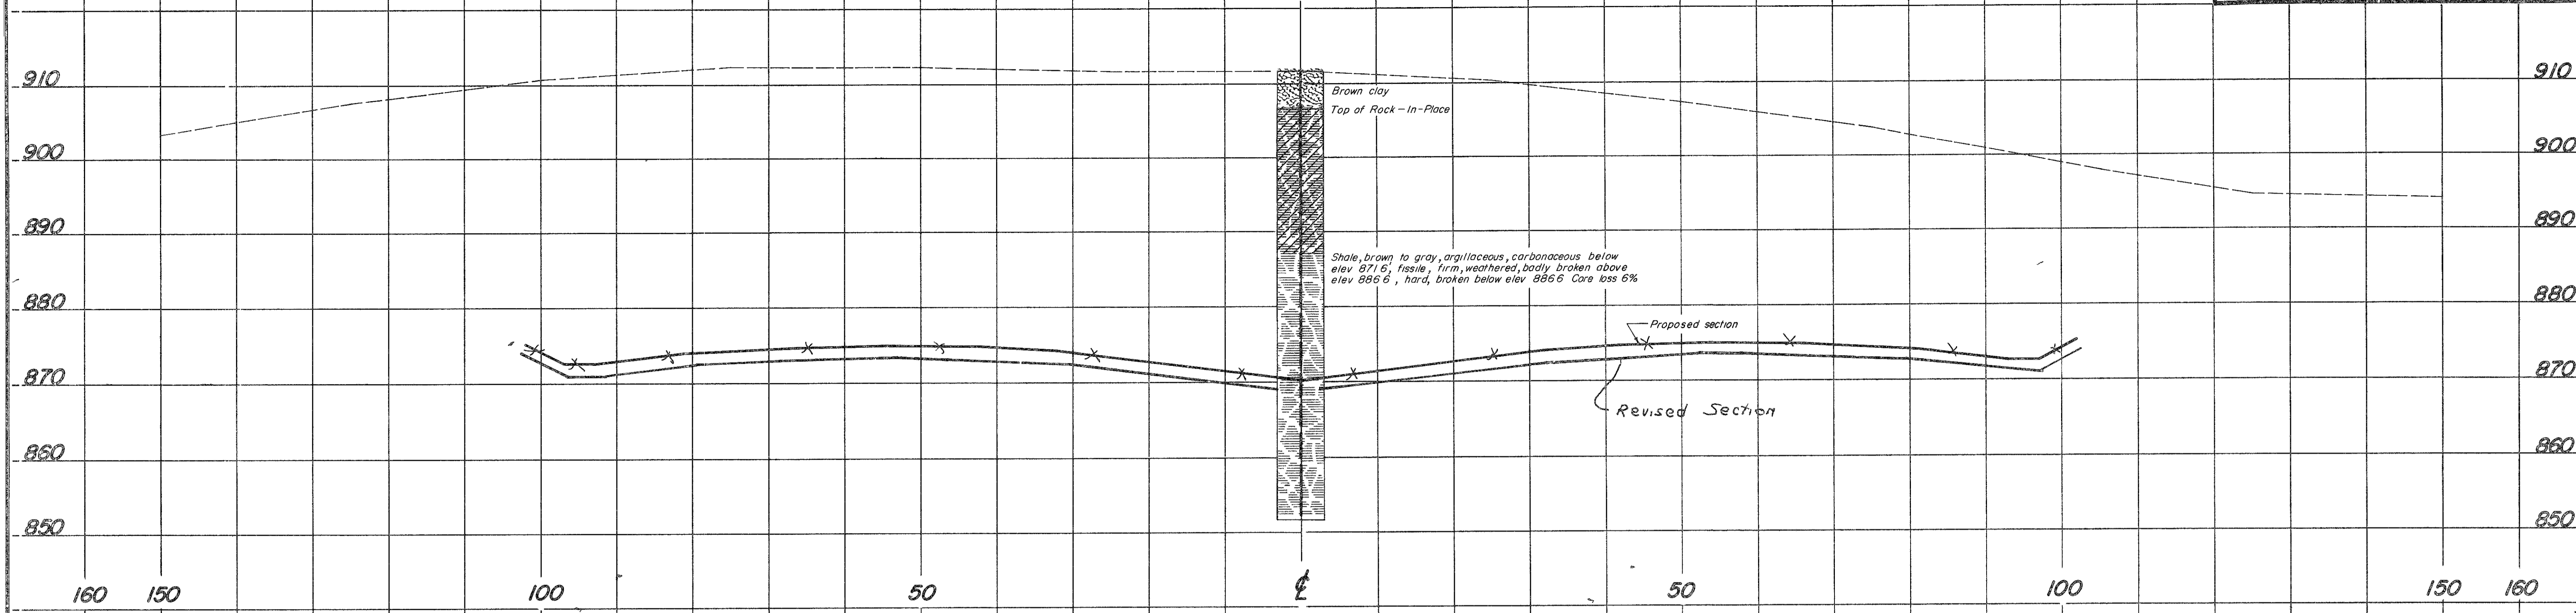

Cross Section
 Sta. 622+00

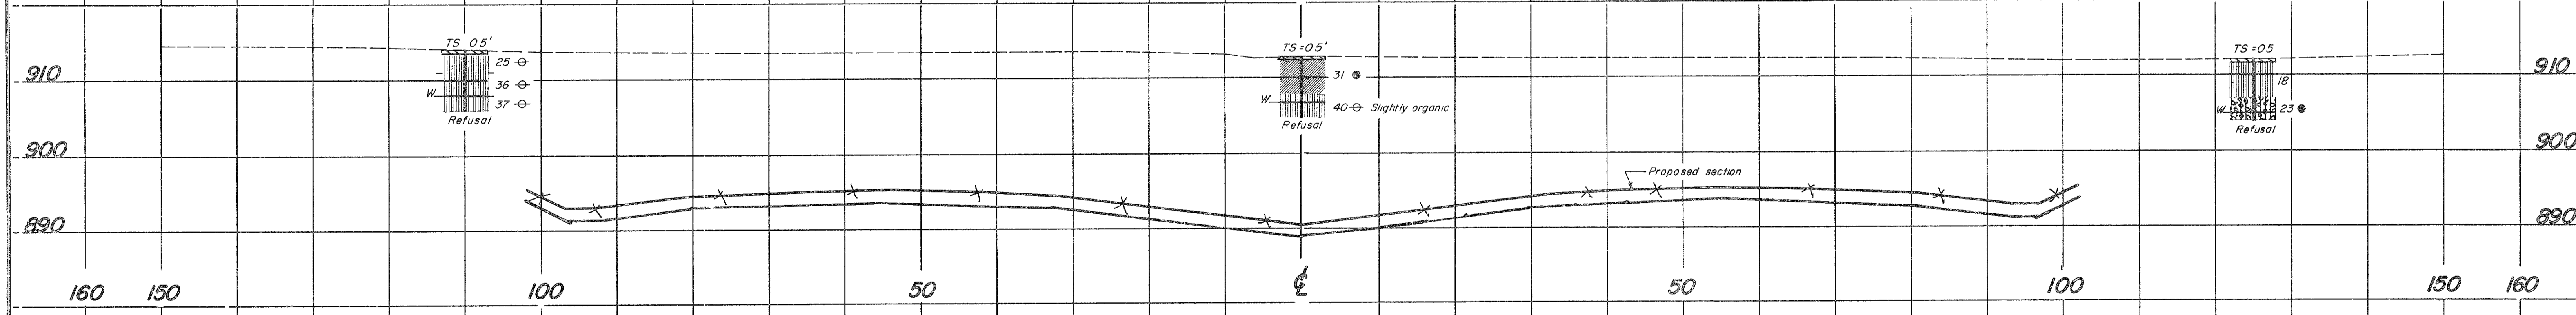

Cross Section
 Sta. 613+00

