



Cross Section  
Sta. 655+00

SOIL PROFILE  
MEDINA - CUYAHOGA COS. 20  
27  
MED - 42 - 26.17  
CUY - 42 - 000  
OHIO STATE HIGHWAY  
TESTING LABORATORY  
1620 W BROAD ST., COLUMBUS 23 OHIO

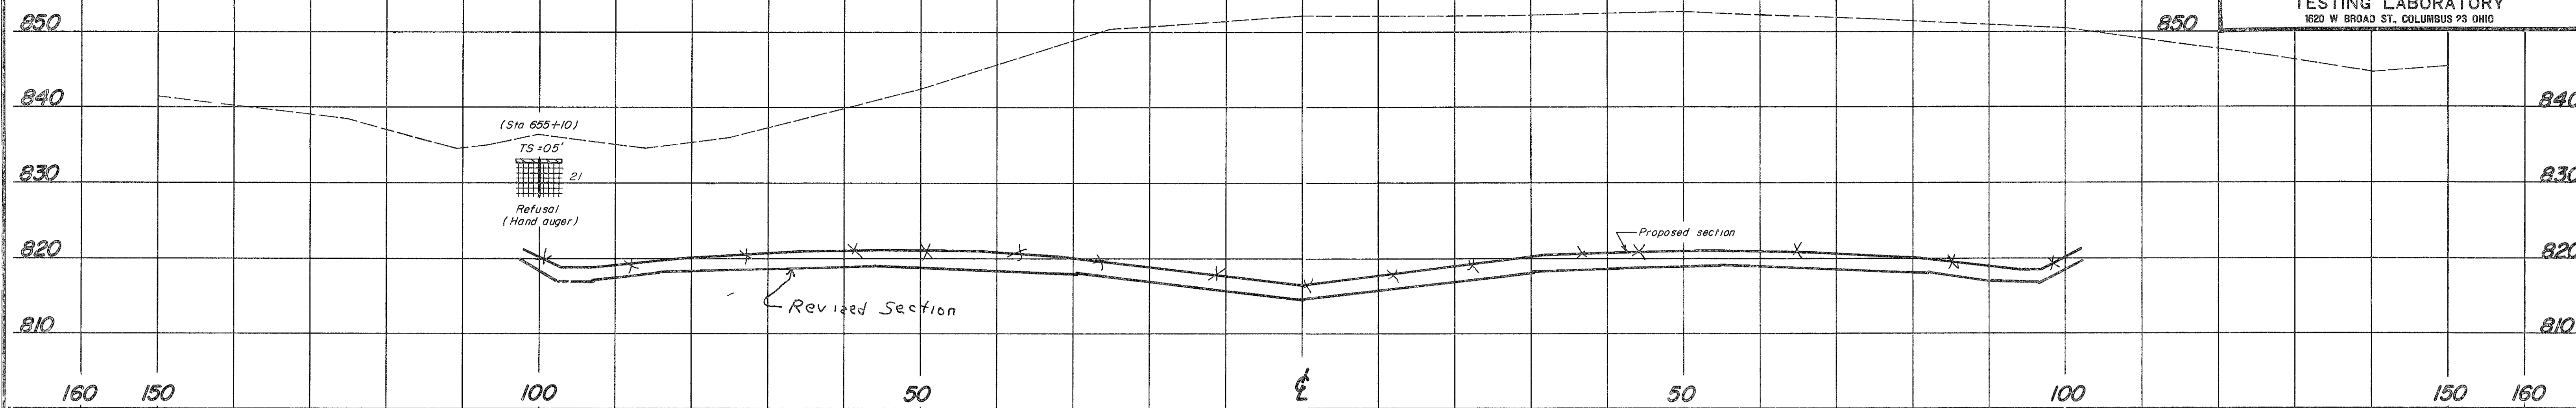

Cross Section  
Sta. 653+00

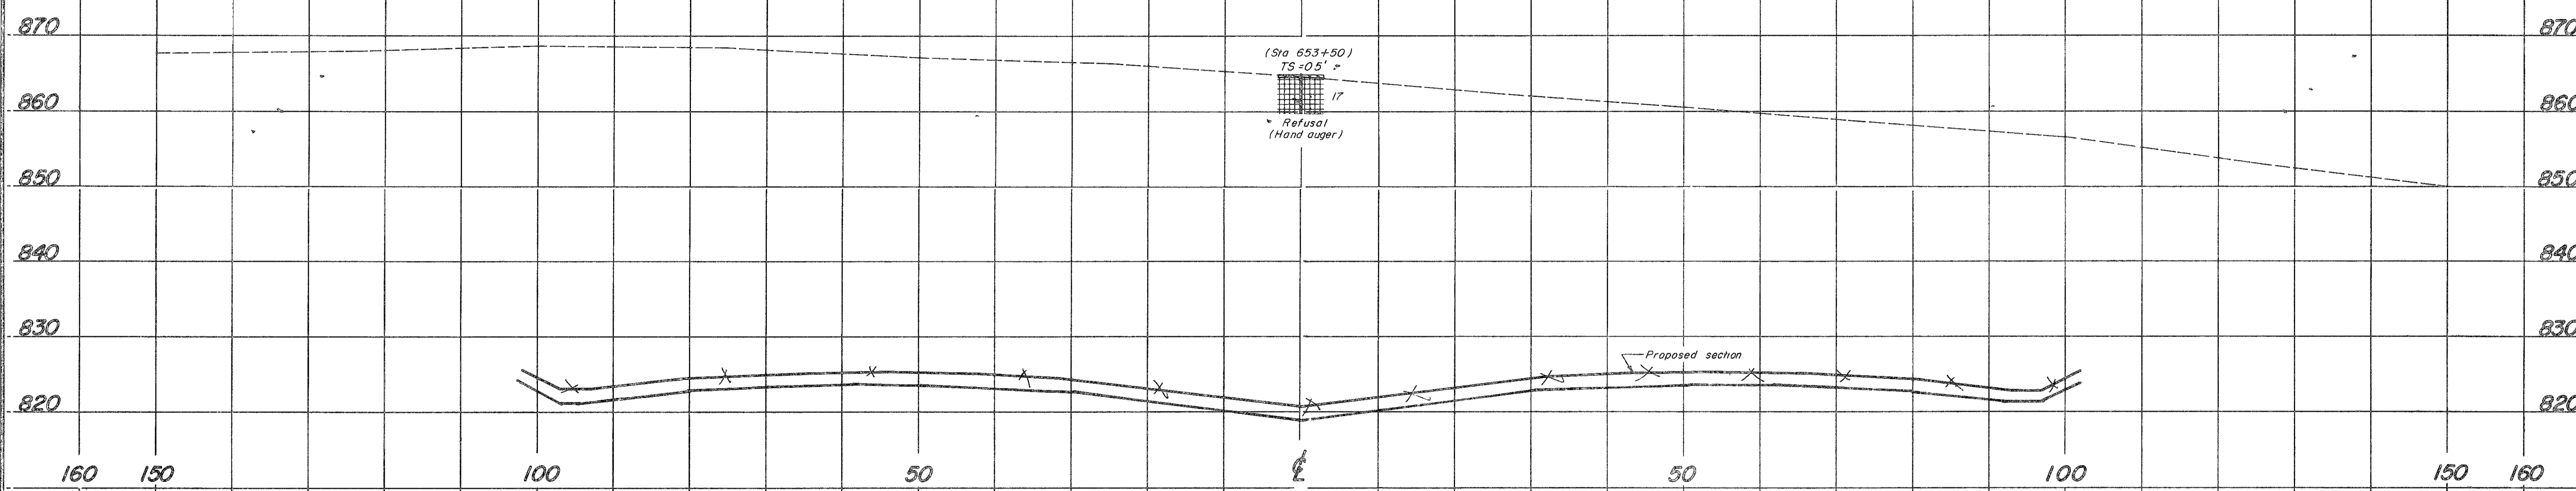

Cross Section  
Sta. 649+00

