


LAK - 1 - 6.97  
R/W PLAN  
LIMITED ACCESS

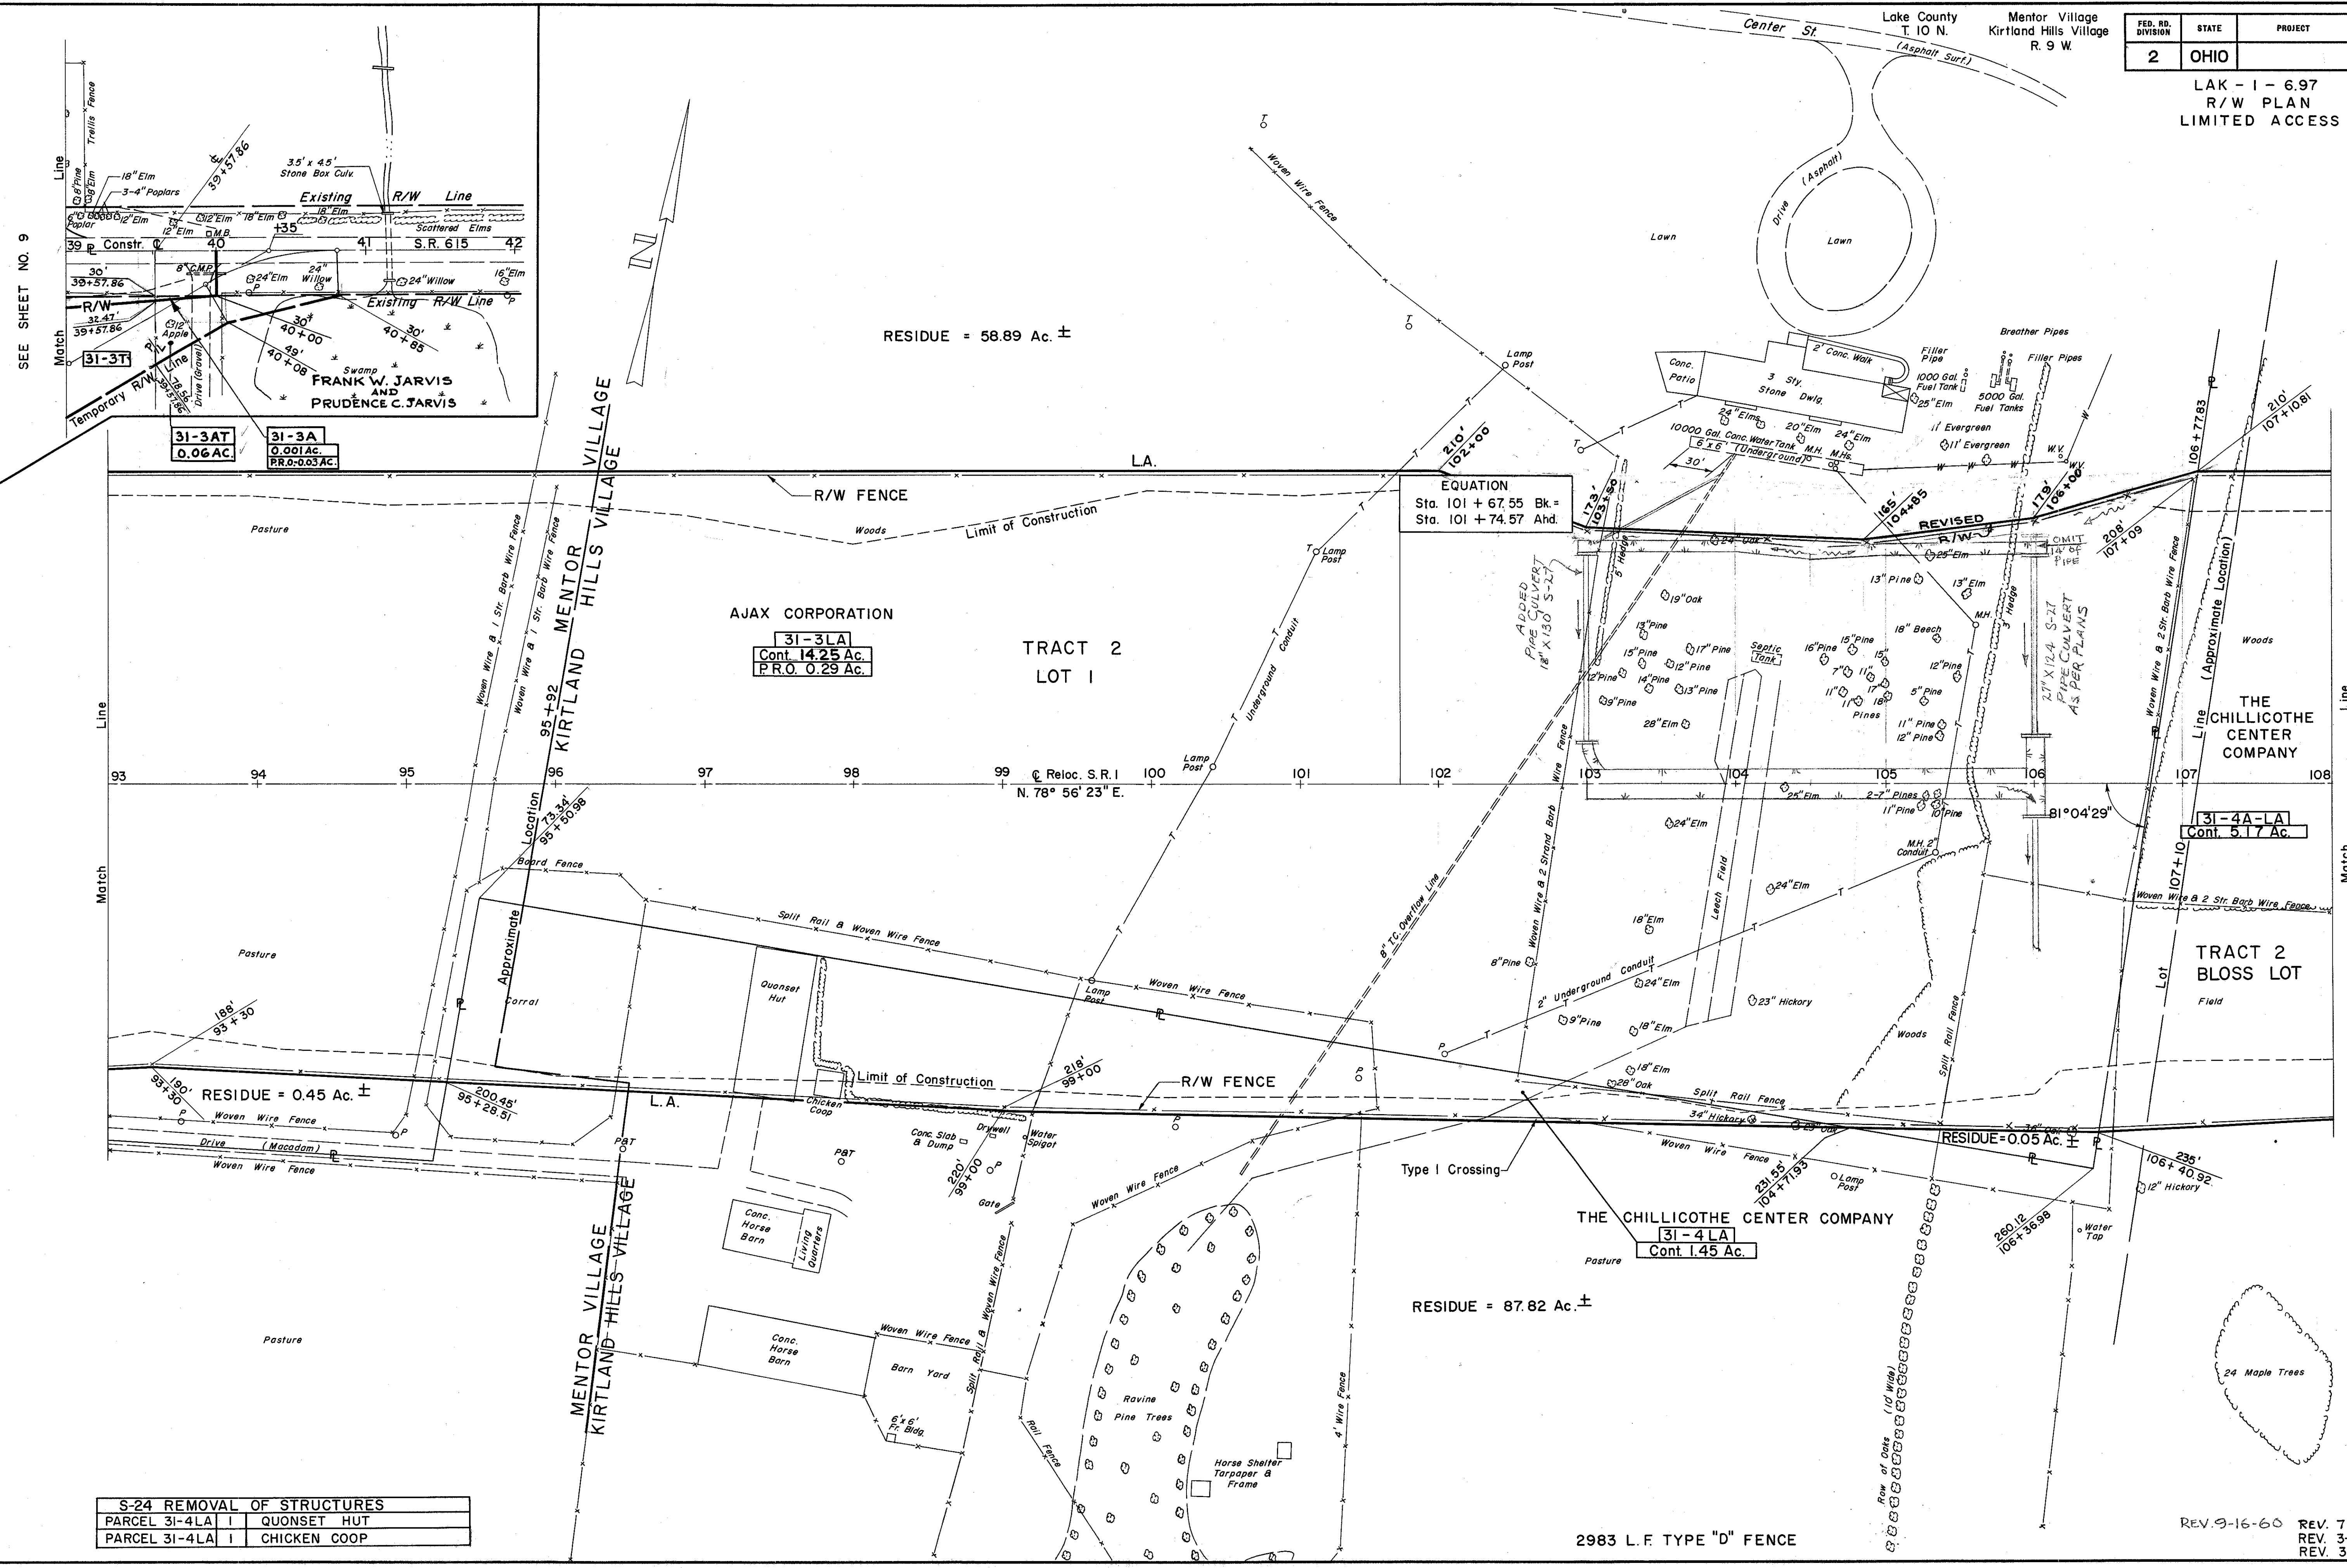

SEE SHEET NO. 9

S-24 REMOVAL OF STRUCTURES		
PARCEL 31-4LA	I	QUONSET HUT
PARCEL 31-4LA	I	CHICKEN COOP

2983 L.F. TYPE "D" FENCE

REV. 9-16-60 REV. 7-5-60  
REV. 3-29-60 REV. 3-9-60

R/W PLAN SR. I STA. 93 + 00 TO STA. 108 + 00