FED. RD. DIVISION	STATE	PROJECT	
2	OHIO		

306
306

11
11

Lake County
T. 10 N.

Concord Township
R 8 W

LAK - 1 - 10.38
R/W PLAN
LIMITED ACCESS

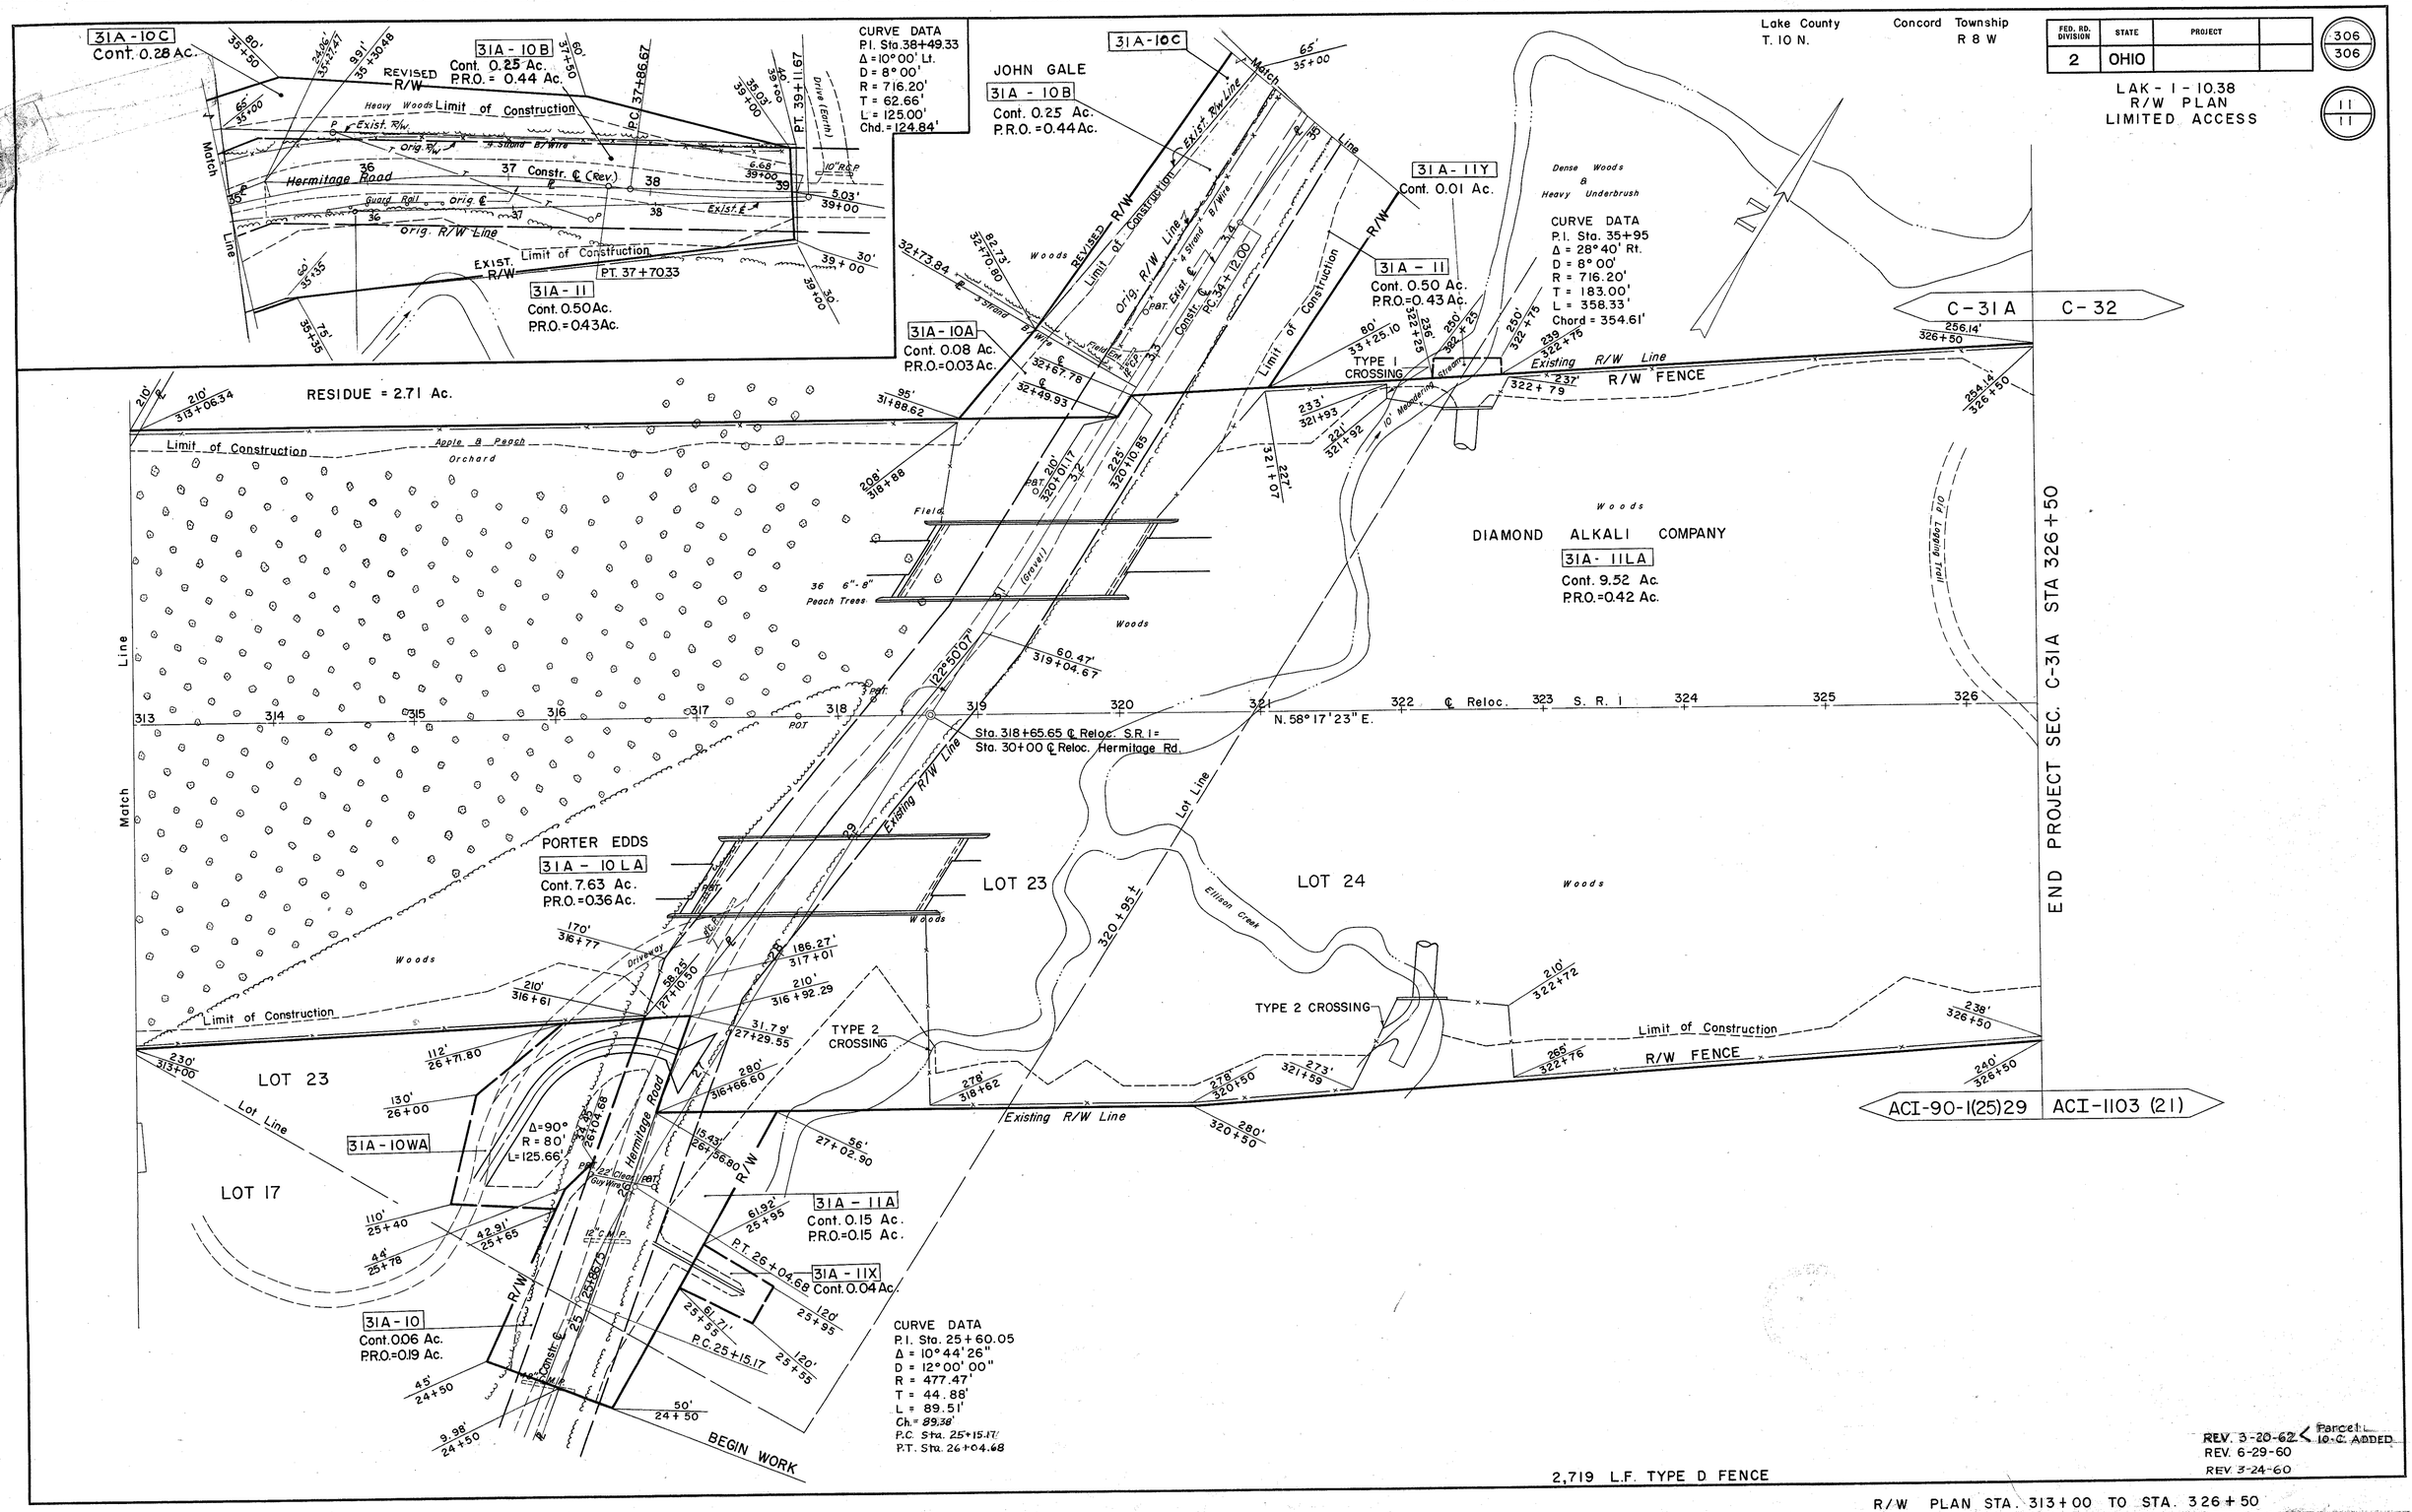

2,719 L.F. TYPE D FENCE

REV. 3-20-62 < Parcel 10-C ADDED
REV. 6-29-60
REV. 3-24-60

R/W PLAN STA. 313+00 TO STA. 326+50