


WILLOUGHBY TWP.
O.L. 8 TRACT 10
T9N RIOW

FED. RD. DIVISION	STATE	PROJECT
2	OHIO	I-1103 (19)

305
312

LAKE COUNTY
LAK-1-2.16
LIMITED ACCESS

R/W
9 of 17

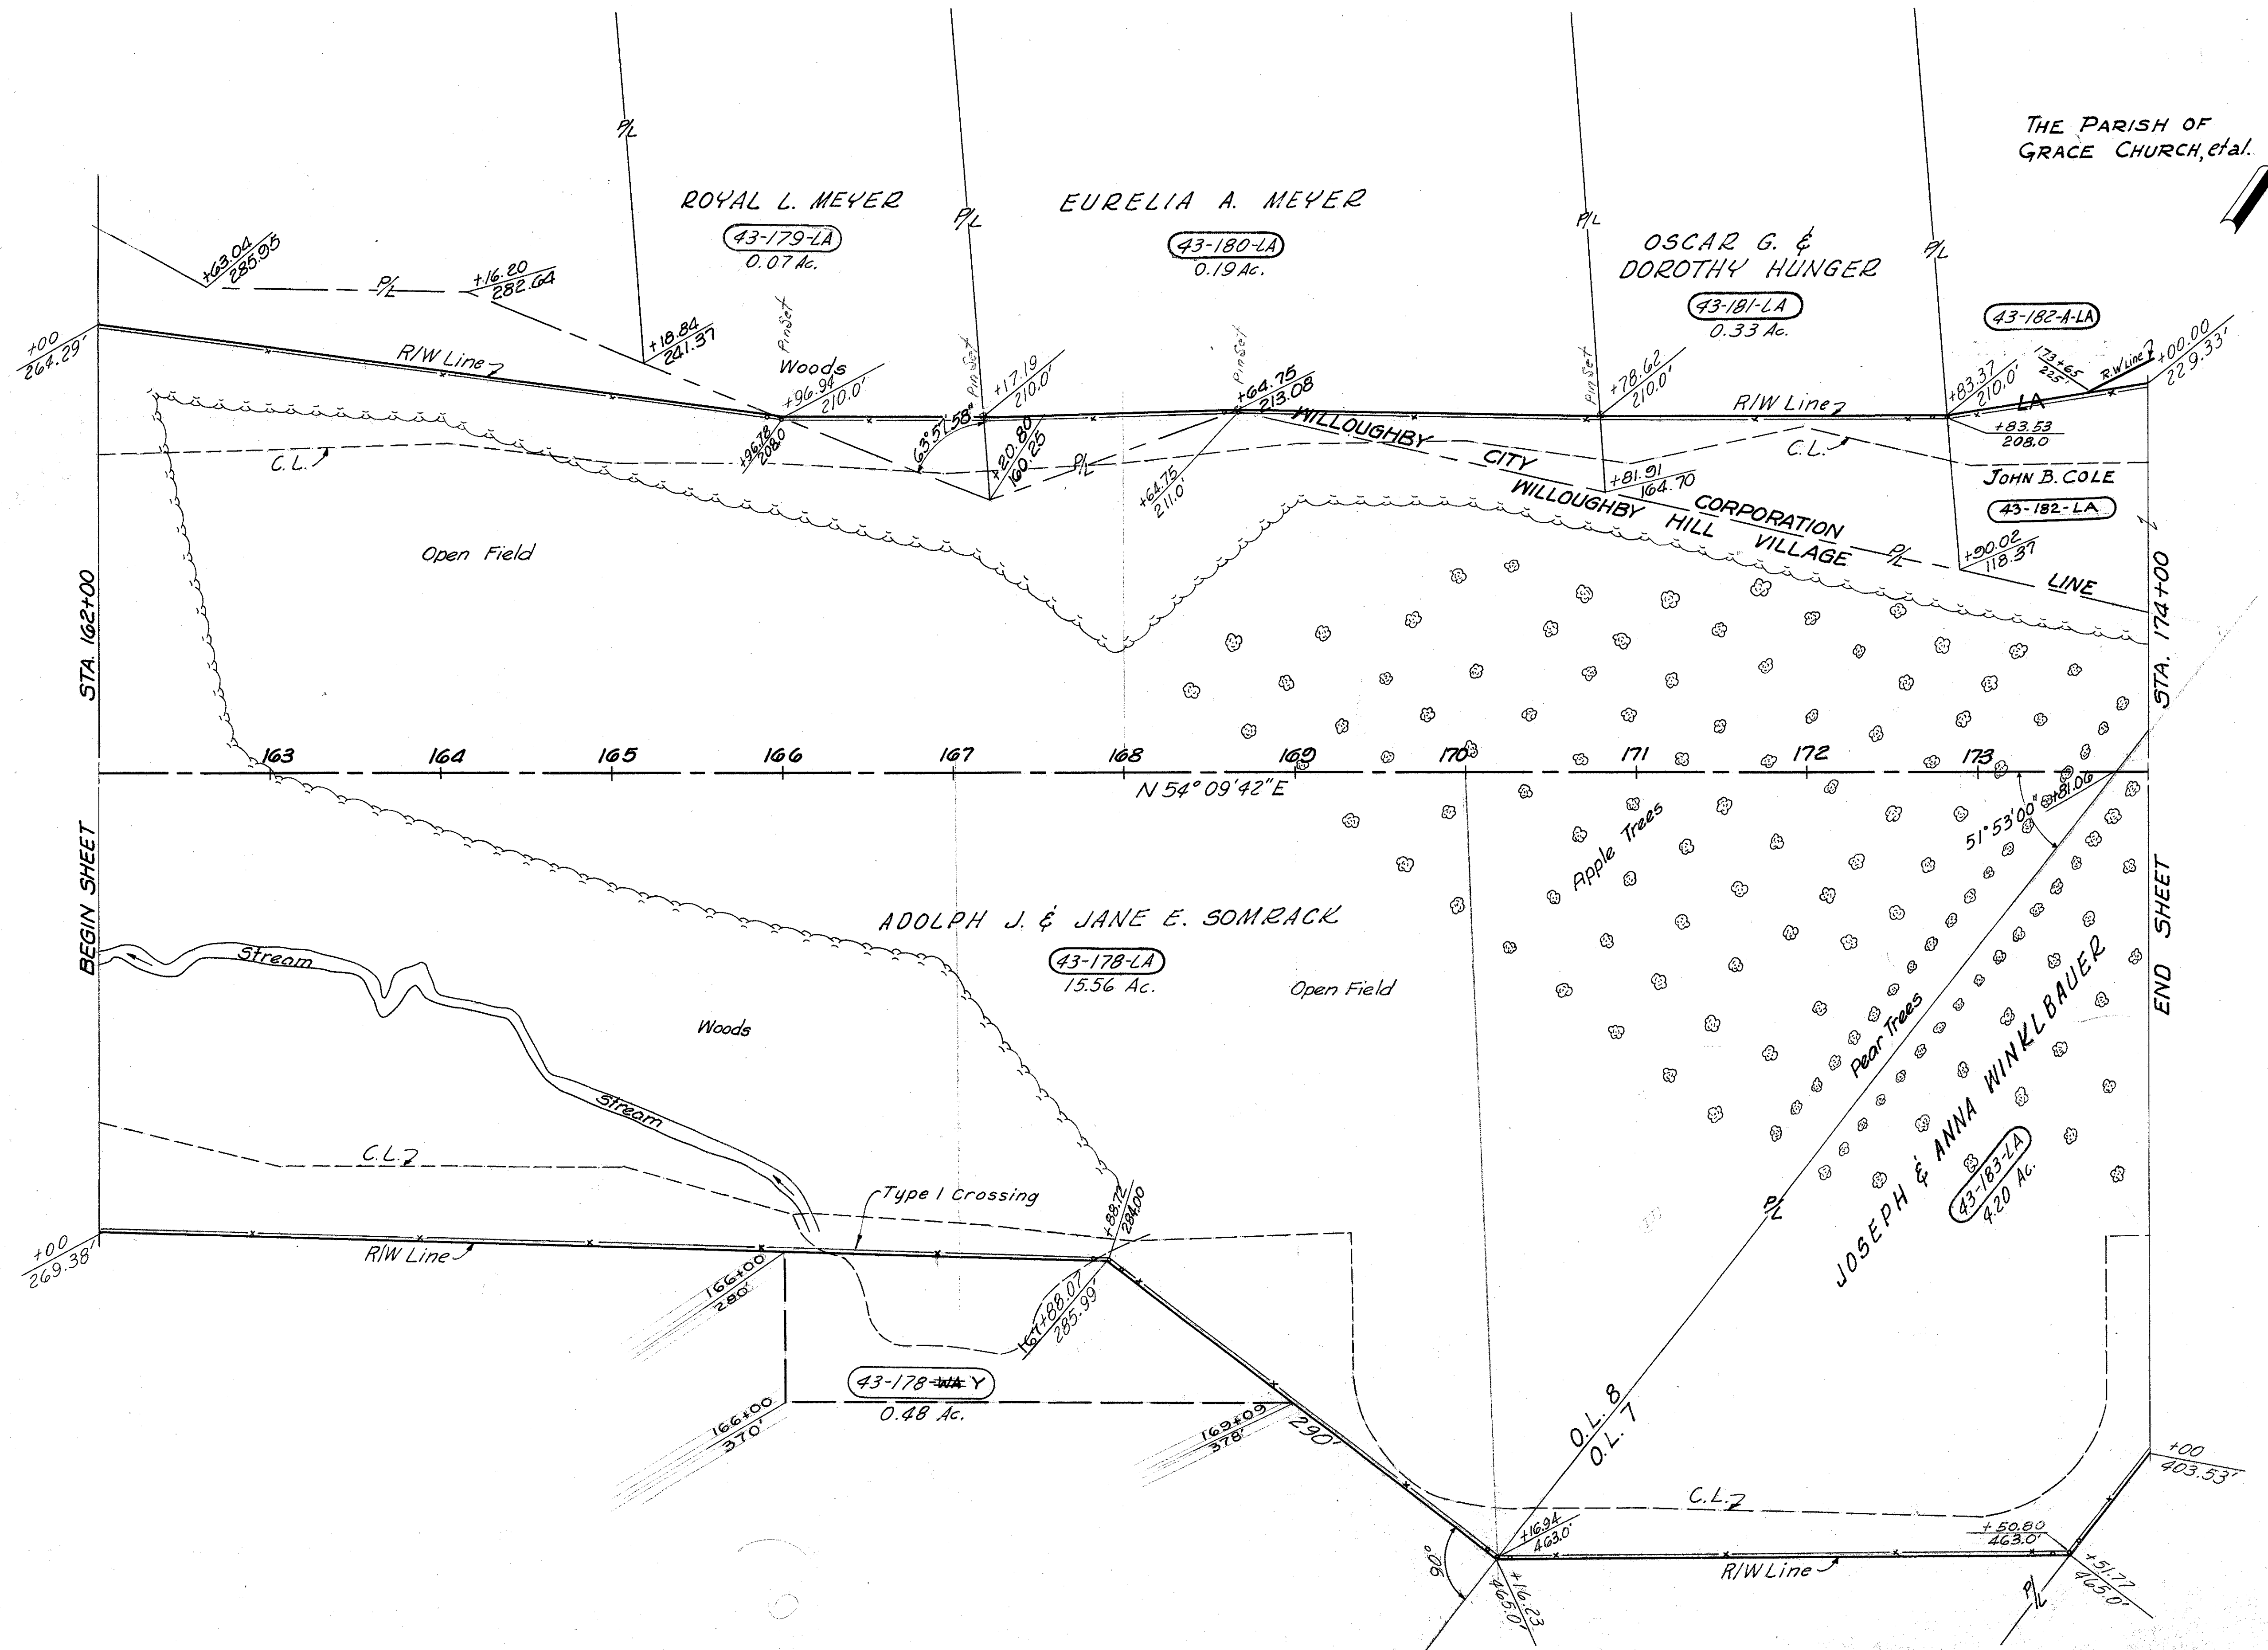

AM:	Added Parcel 43-182-A-LA	9-27-60
NAME:	REVISIONS	DATE

2504 L.F. Type "D" Fence

MICHAEL BAKER JR., CONSULTING ENGINEERS ROCHESTER, PENNSYLVANIA					
STATE OF OHIO DEPARTMENT OF HIGHWAYS RIGHT OF WAY PLANS STATE HIGHWAY NO. 1 C-43 STA. 162+00 TO STA. 174+00					
DATE:	3-25-59	9-9-59			
Designed	Drawn	Traced	Checked	Reviewed	Date
J.P.	A.L.H.	K.G.	B.P.		