


WILLOUGHBY TWP
 O.L. 5 TRACT 10
 T 9 N R 10 W

FED. RD. DIVISION	STATE	PROJECT
2	OHIO	I-1103 (19)

308
3/2

LAKE COUNTY
 LAK-1-2.16
 LIMITED ACCESS

R / W
 12 of 17

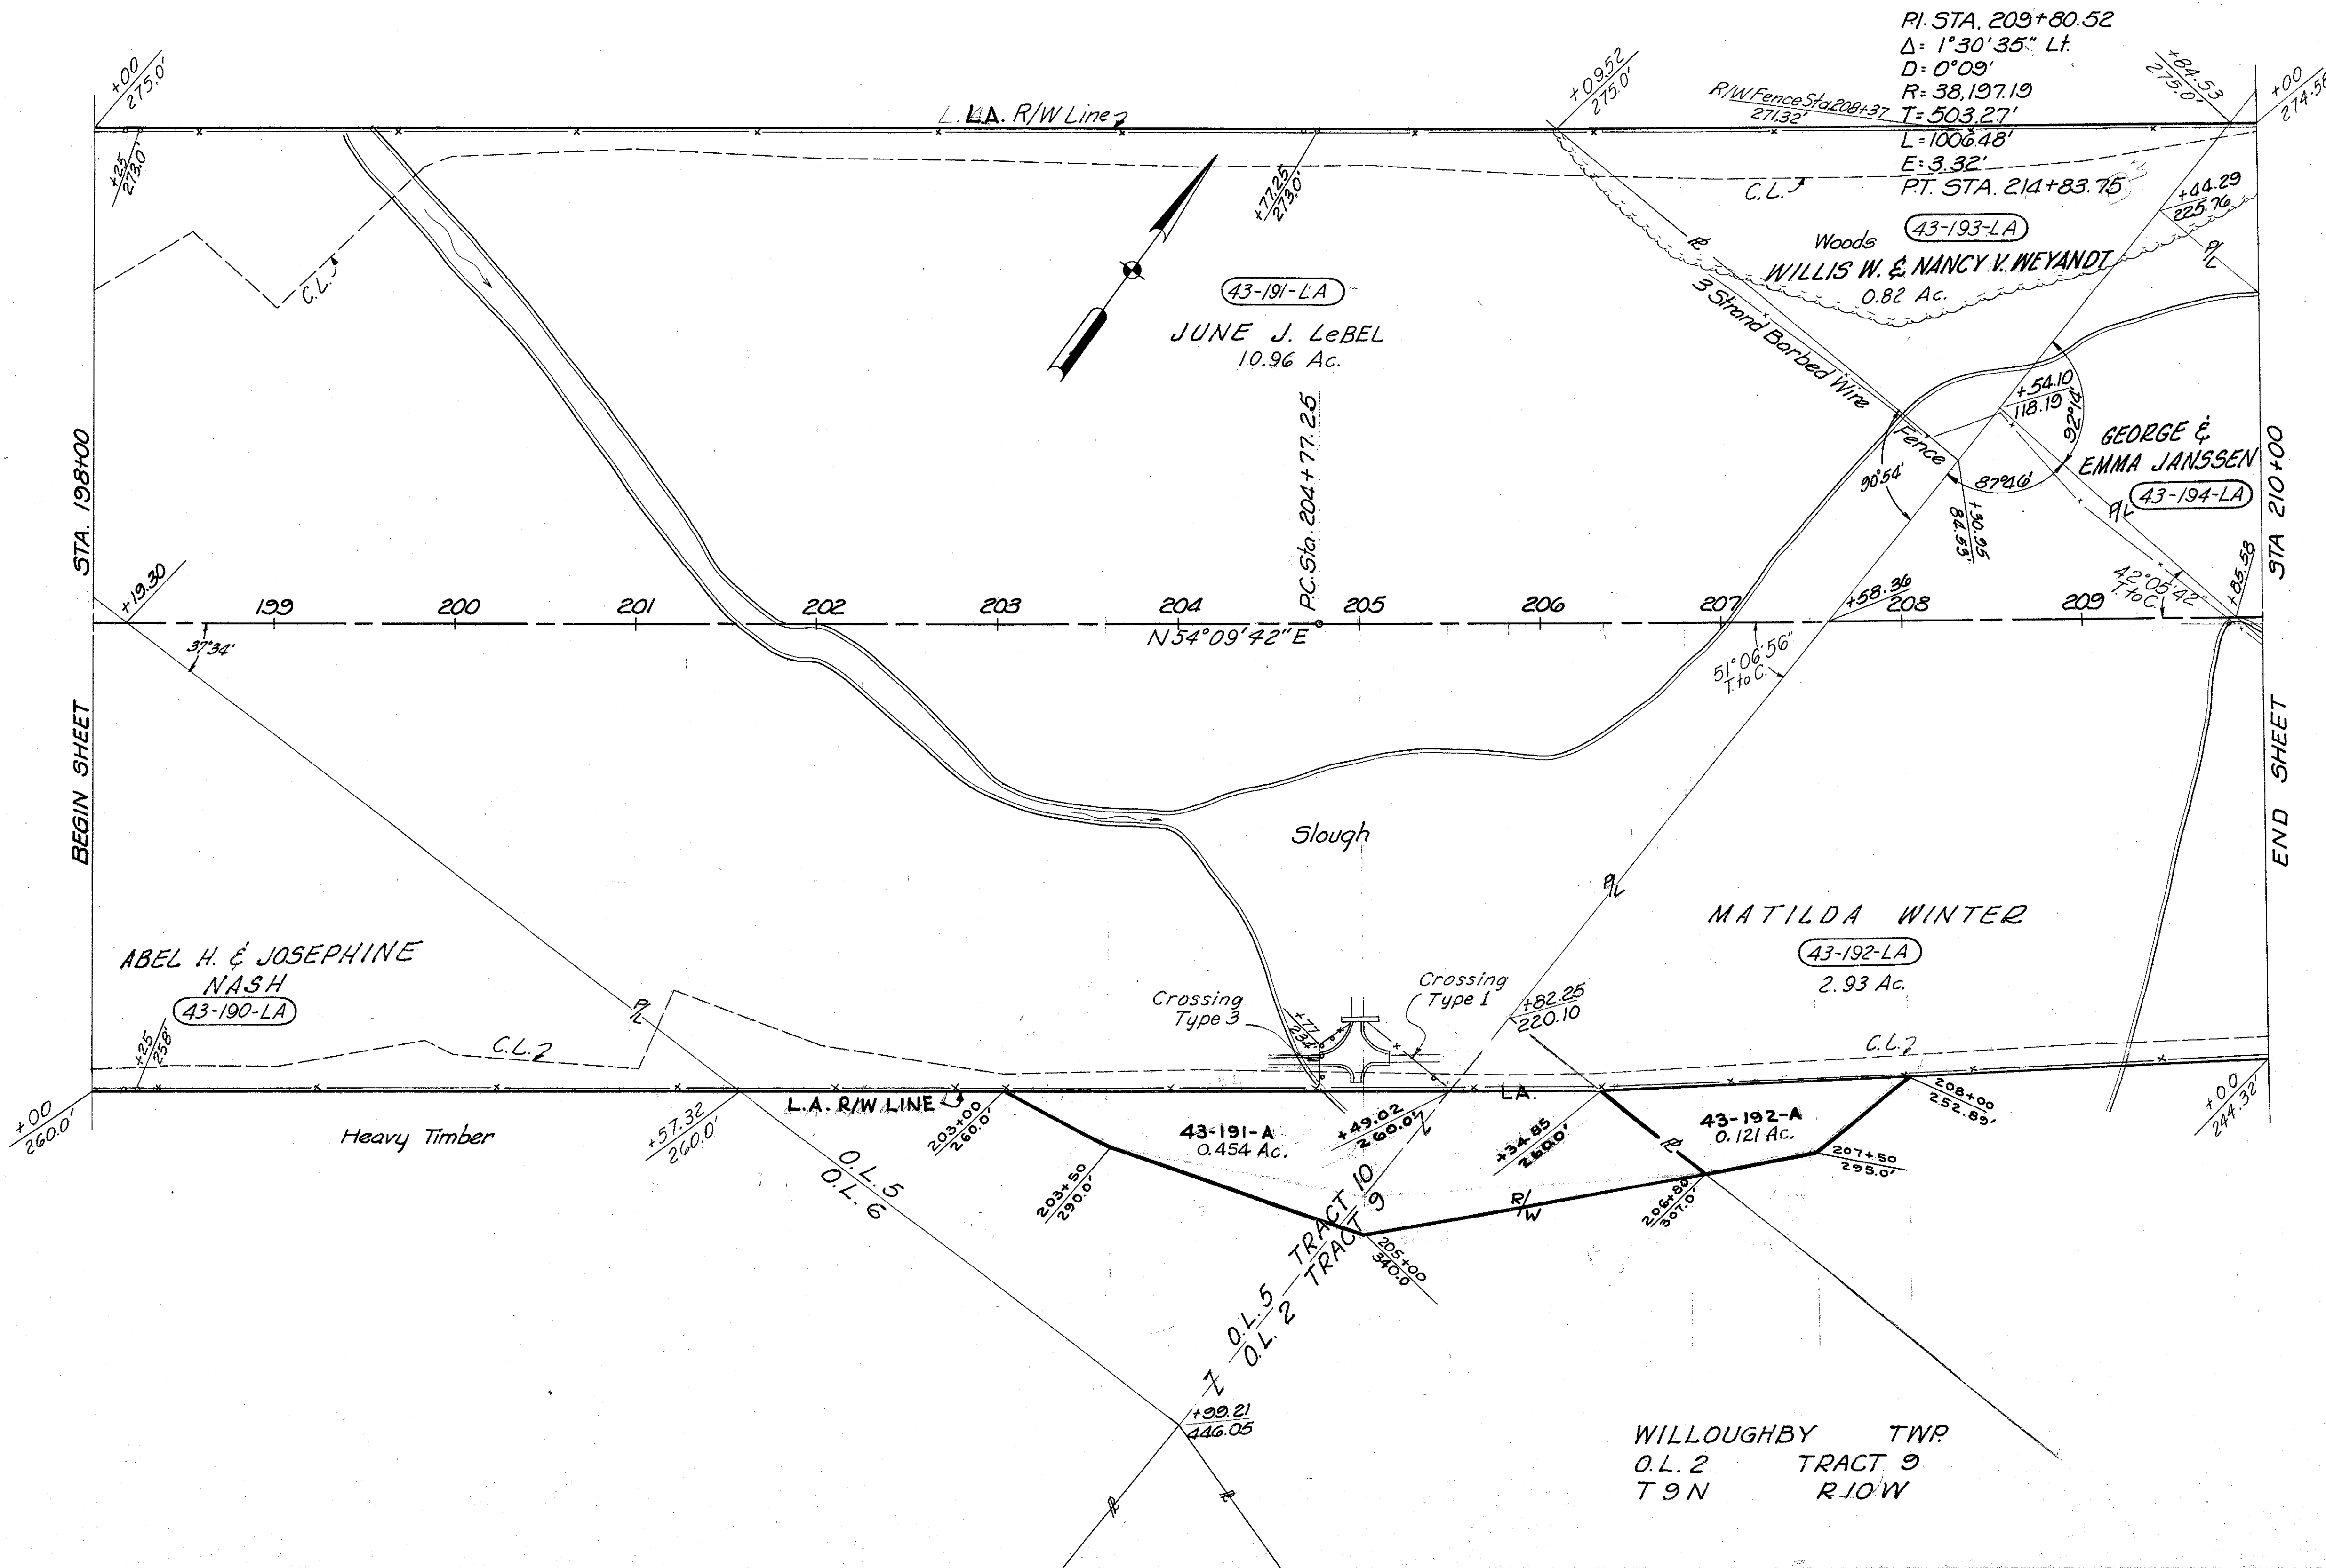

2433 L.F. Type "D" Fence

MICHAEL BAKER JR., CONSULTING ENGINEERS ROCHESTER, PENNSYLVANIA						
DATE:	3-25-59					
REVISIONS:	191-A & 192-A ADDED 9-14-61					
STATE OF OHIO DEPARTMENT OF HIGHWAYS RIGHT OF WAY PLANS STATE HIGHWAY NO. 1 C-43 STA. 198+00 TO STA. 210+00						
Designed	Drawn	Traced	Checked	Reviewed	Date	Revised
J.P.	K.A.	K.G.	B.P.			

WILLOUGHBY TWP
 O.L. 2 TRACT 9
 T 9 N R 10 W