
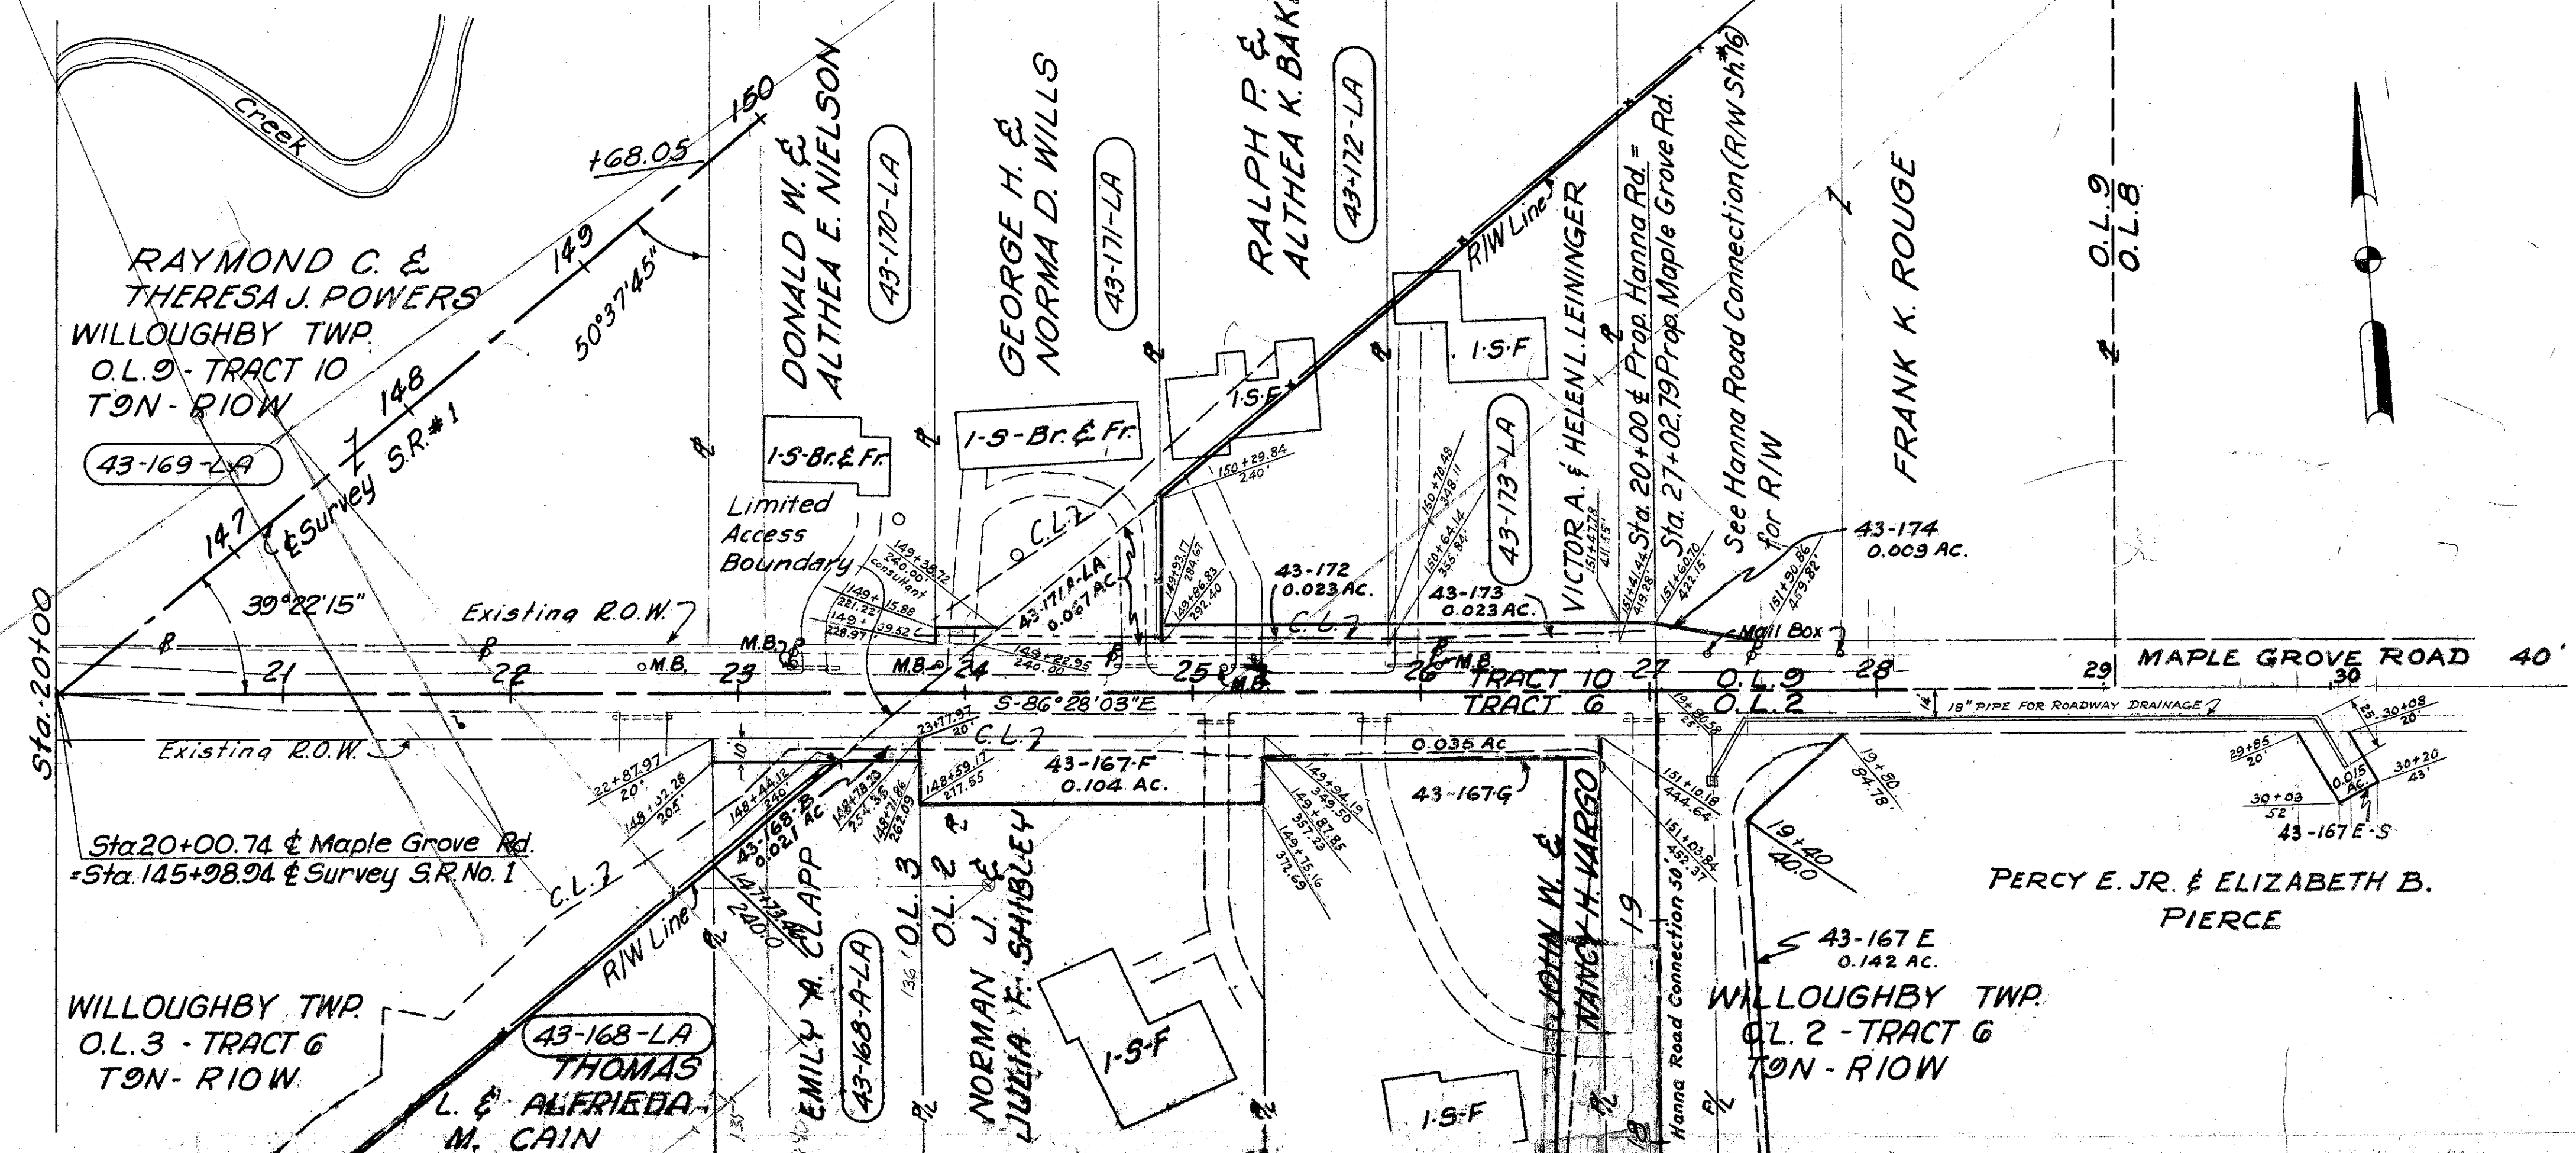


FED. RD. DIVISION	STATE	PROJECT	
2	OHIO	T-1103 (19)	

313
312

LAKE COUNTY
LAK-1-2.16
LIMITED ACCESS

R/W
17 of 17

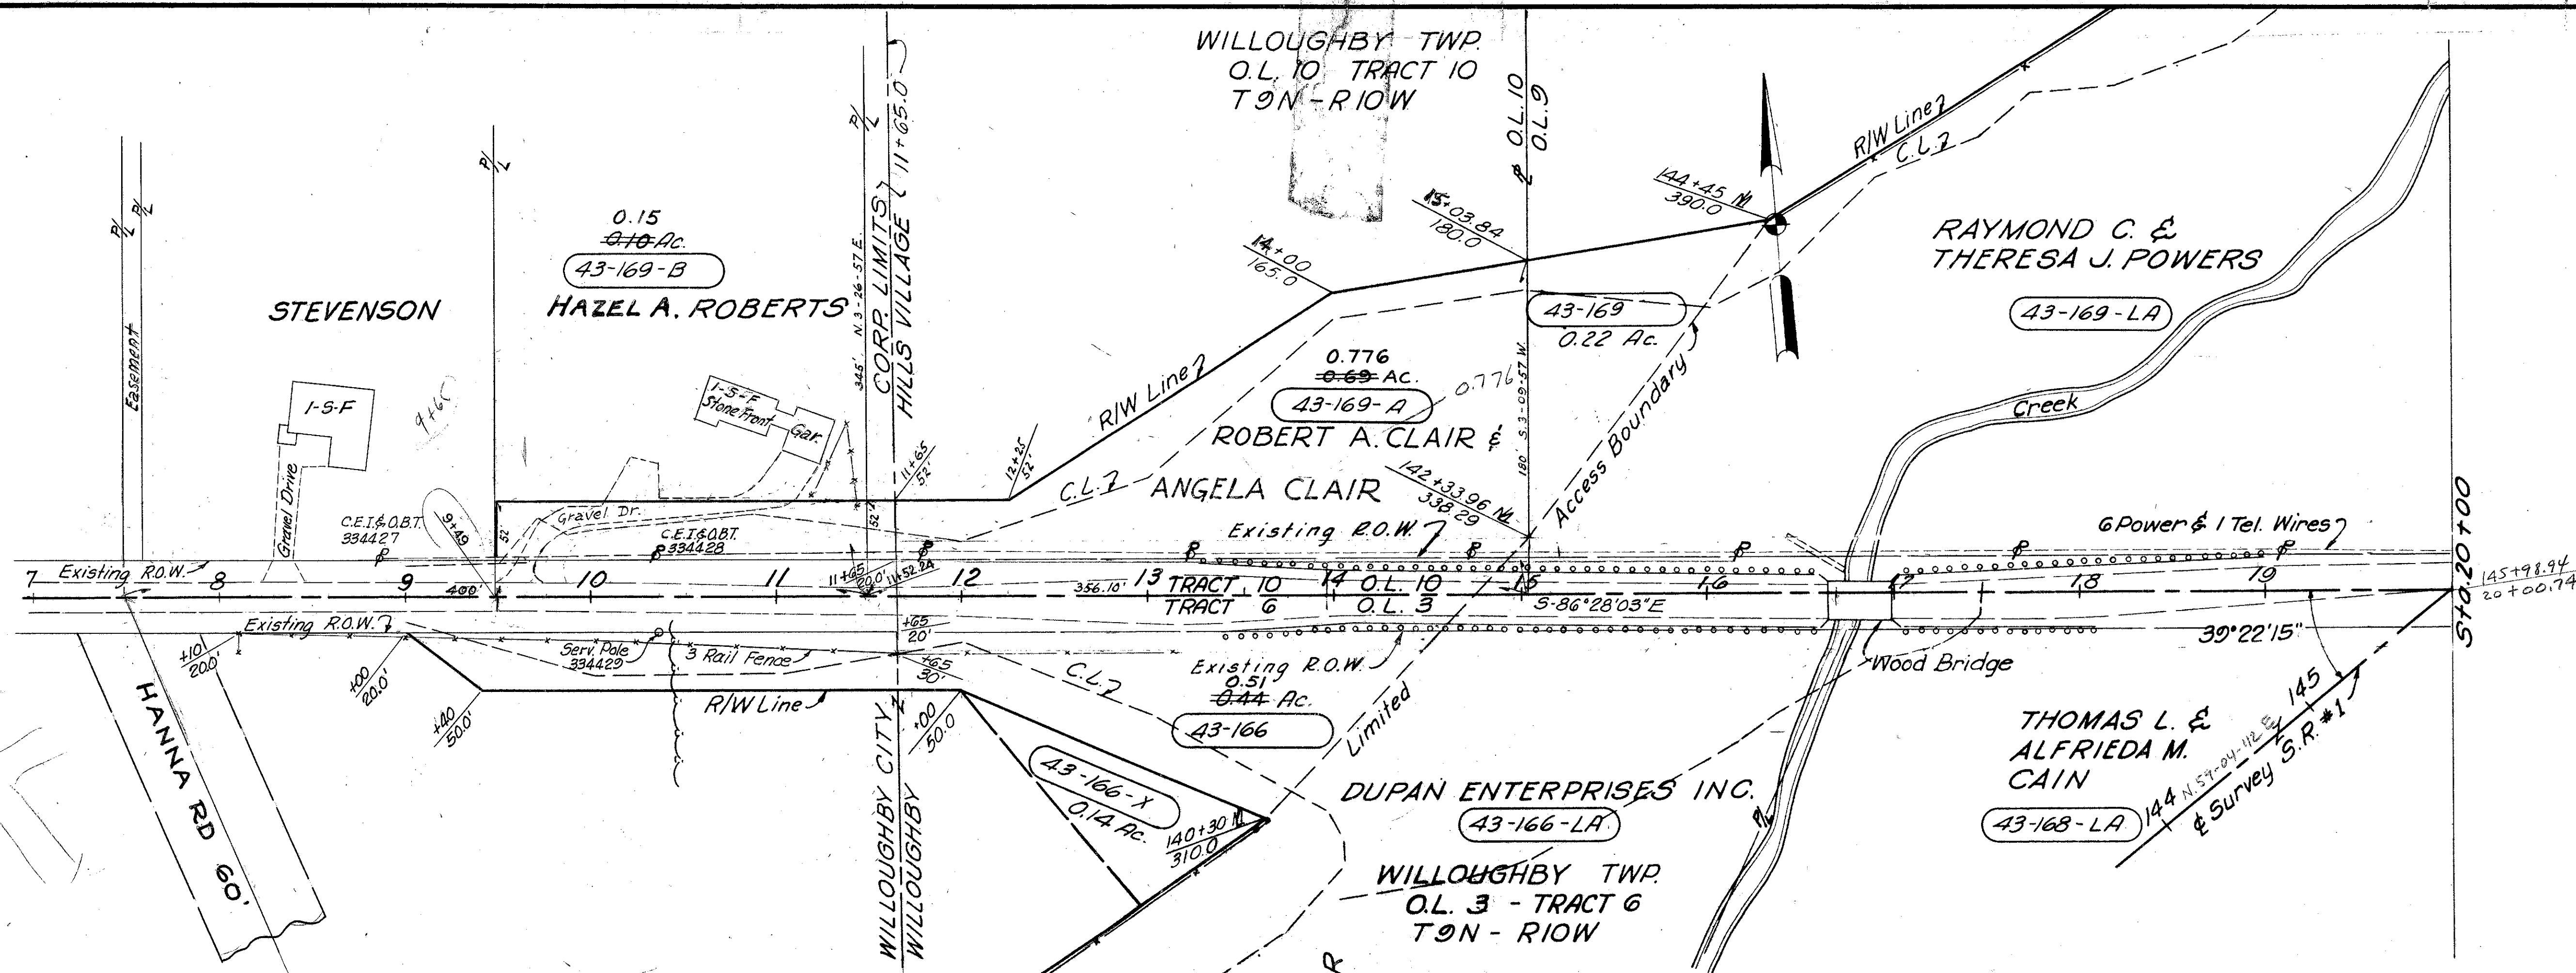

MICHAEL BAKER JR., CONSULTING ENGINEERS ROCHESTER, PENNSYLVANIA					
DATE:					
3-25-59					
Revised:					
6-5-59					
9-9-59					
10-26-59					
4-6-60					
5-2-60					
STATE OF OHIO DEPARTMENT OF HIGHWAYS RIGHT OF WAY PLANS STATE HIGHWAY NO. 1 C-43 MAPLE GROVE ROAD					
Designed	Drawn	Traced	Checked	Reviewed Date	Revised
W.T.P.	A.L.H.	K.L.G.	J.P.		

✓ B.A.P. Dec. 2/59

2.549 sq. ft.
Total = 3.364 Ac.