


SEEDING  
 100 LBS.  
 100 YDS.

REV. NO.	DATE	PROJECT
2	OHIO	

204  
277

LAKE COUNTY  
 LAK-1-6.97

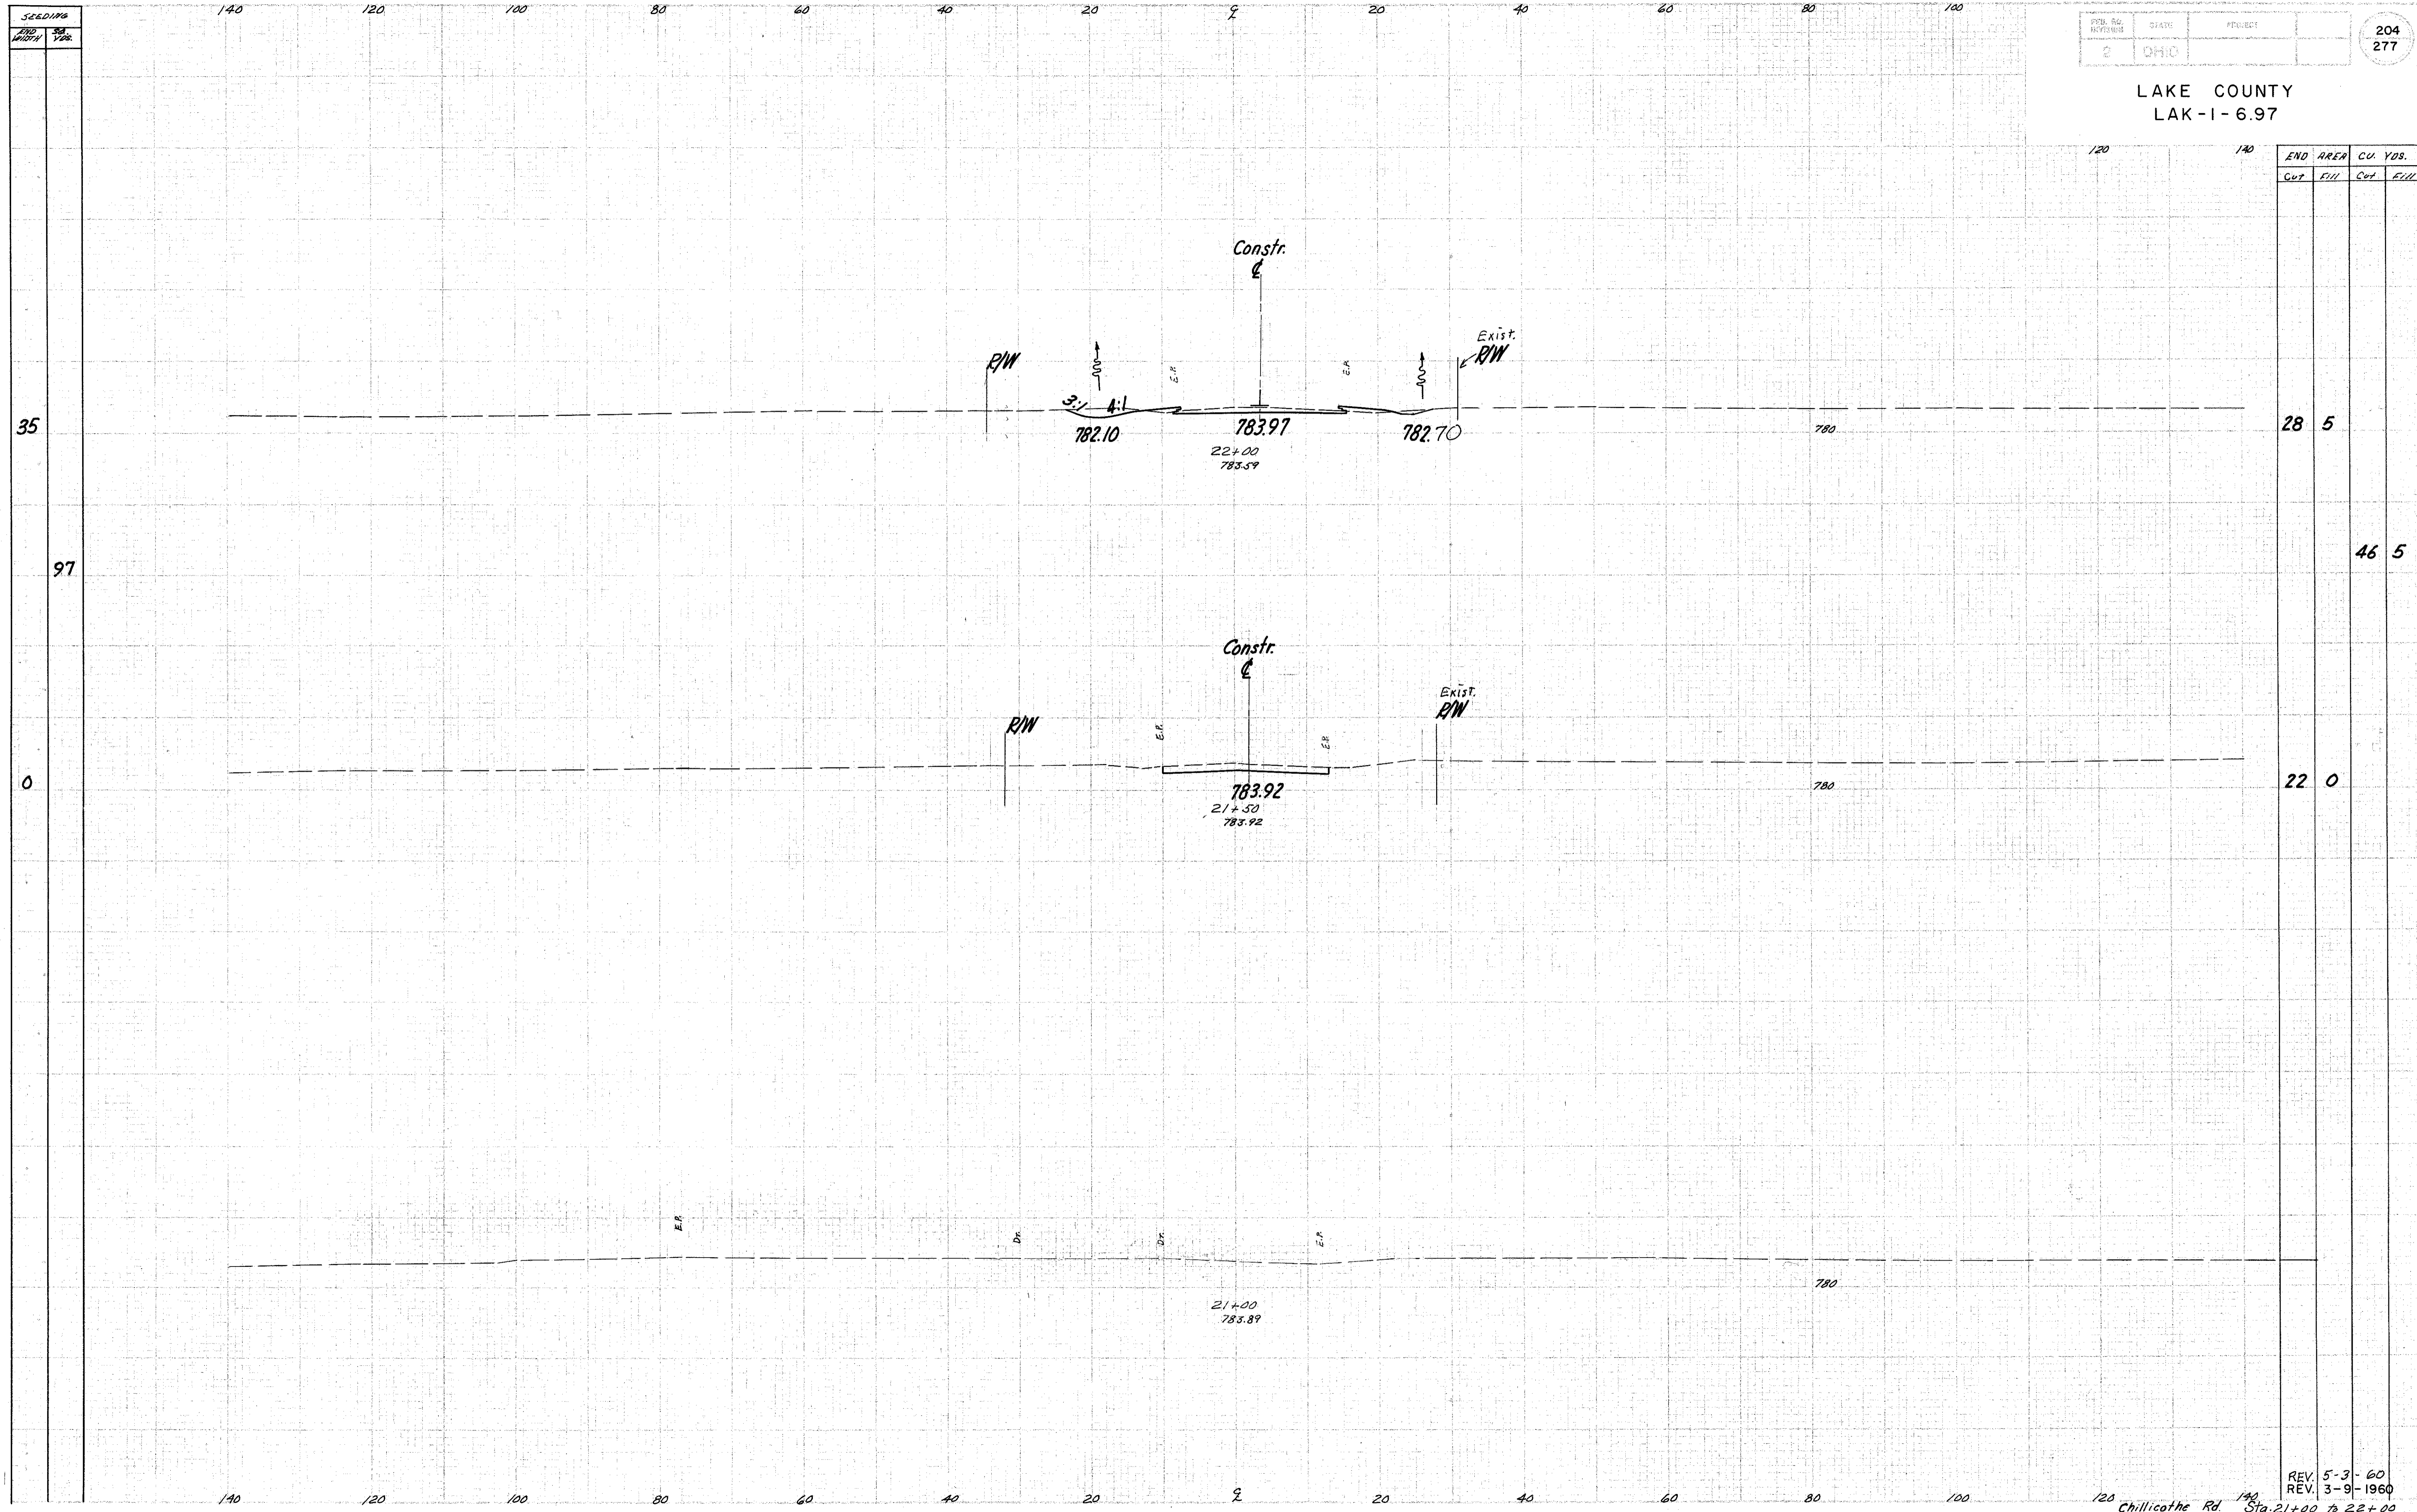

END AREA		CU. YDS.	
CUT	FILL	CUT	FILL

28	5		
		46	5
22	0		

REV. 5-3-60  
 REV. 3-9-1960

Chillicothe Rd. Sta. 21+00 to 22+00