



PER. NO. DIVISION	STATE	PROJECT	
2	OHIO		

227
277

LAKE COUNTY
LAK-1-6.97

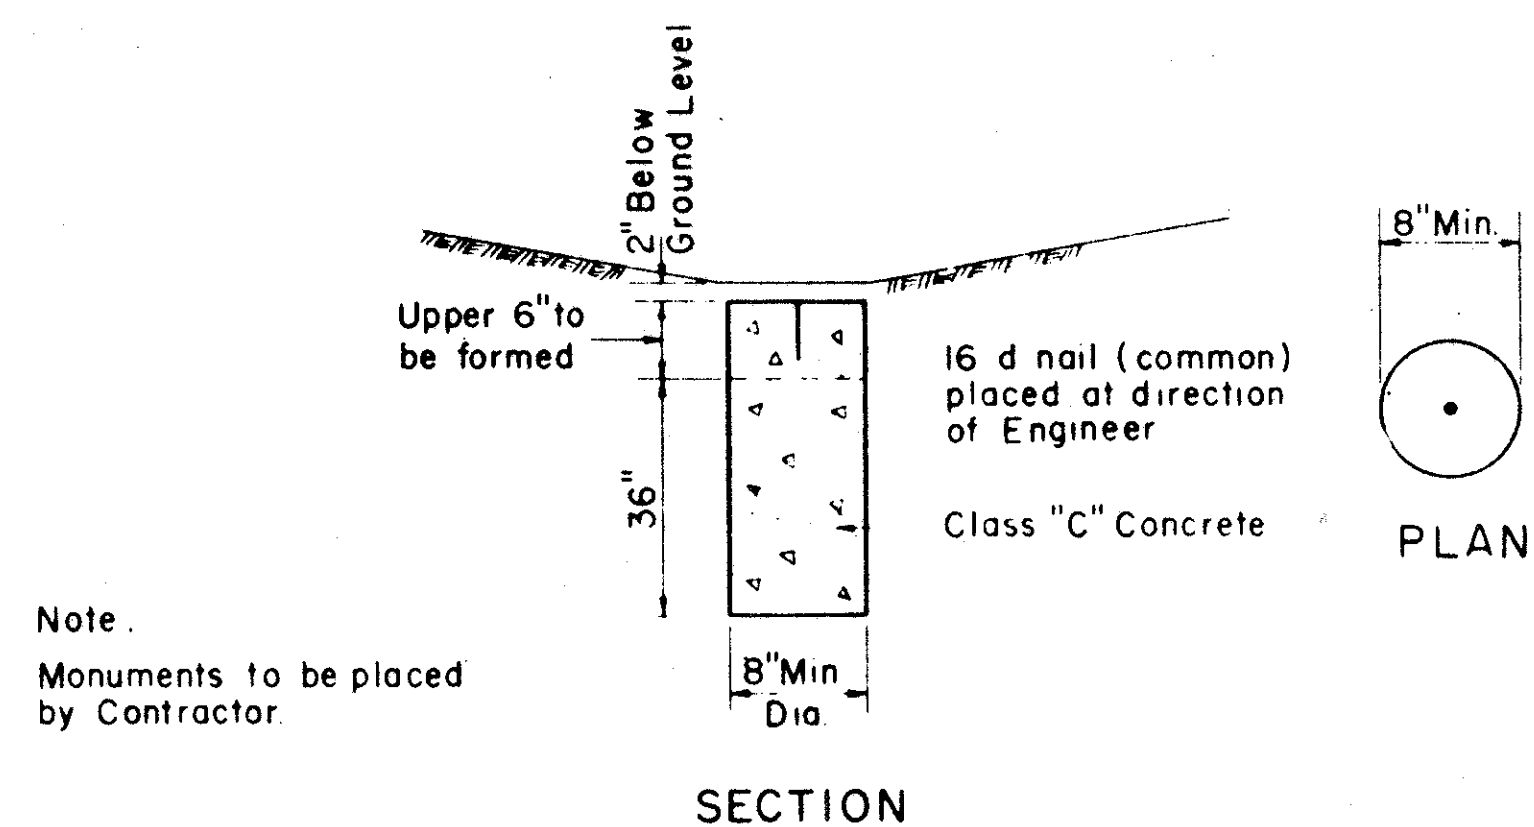


DETAIL OF CENTERLINE REFERENCE MONUMENTS

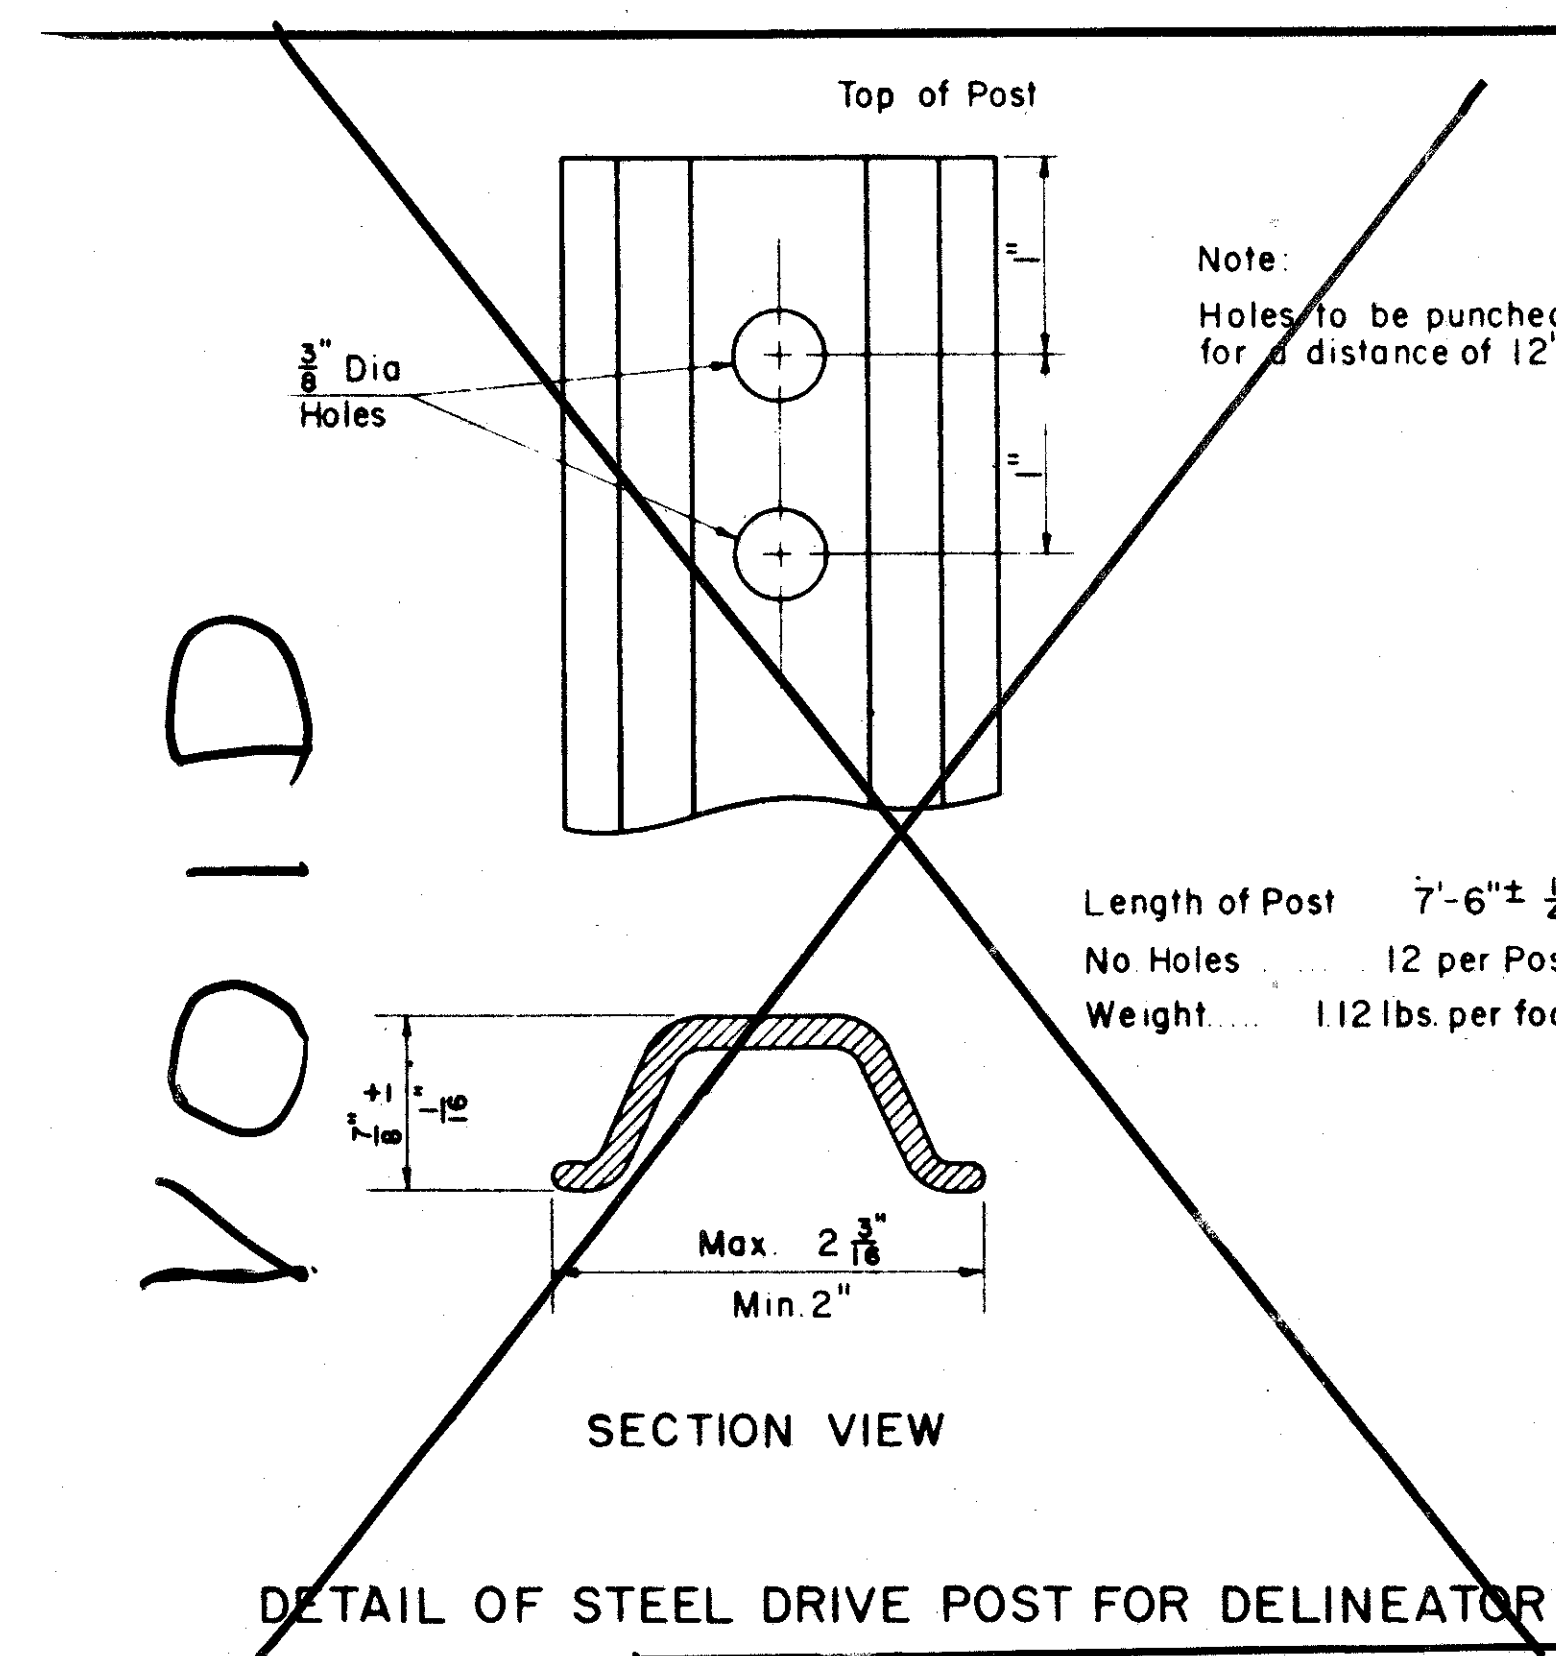

DETAIL OF STEEL DRIVE POST FOR DELINEATOR

NOTE:
Delineators shall be located at intervals of 200 lin. ft. along the right side of each pavement. (in relation to traffic flow)

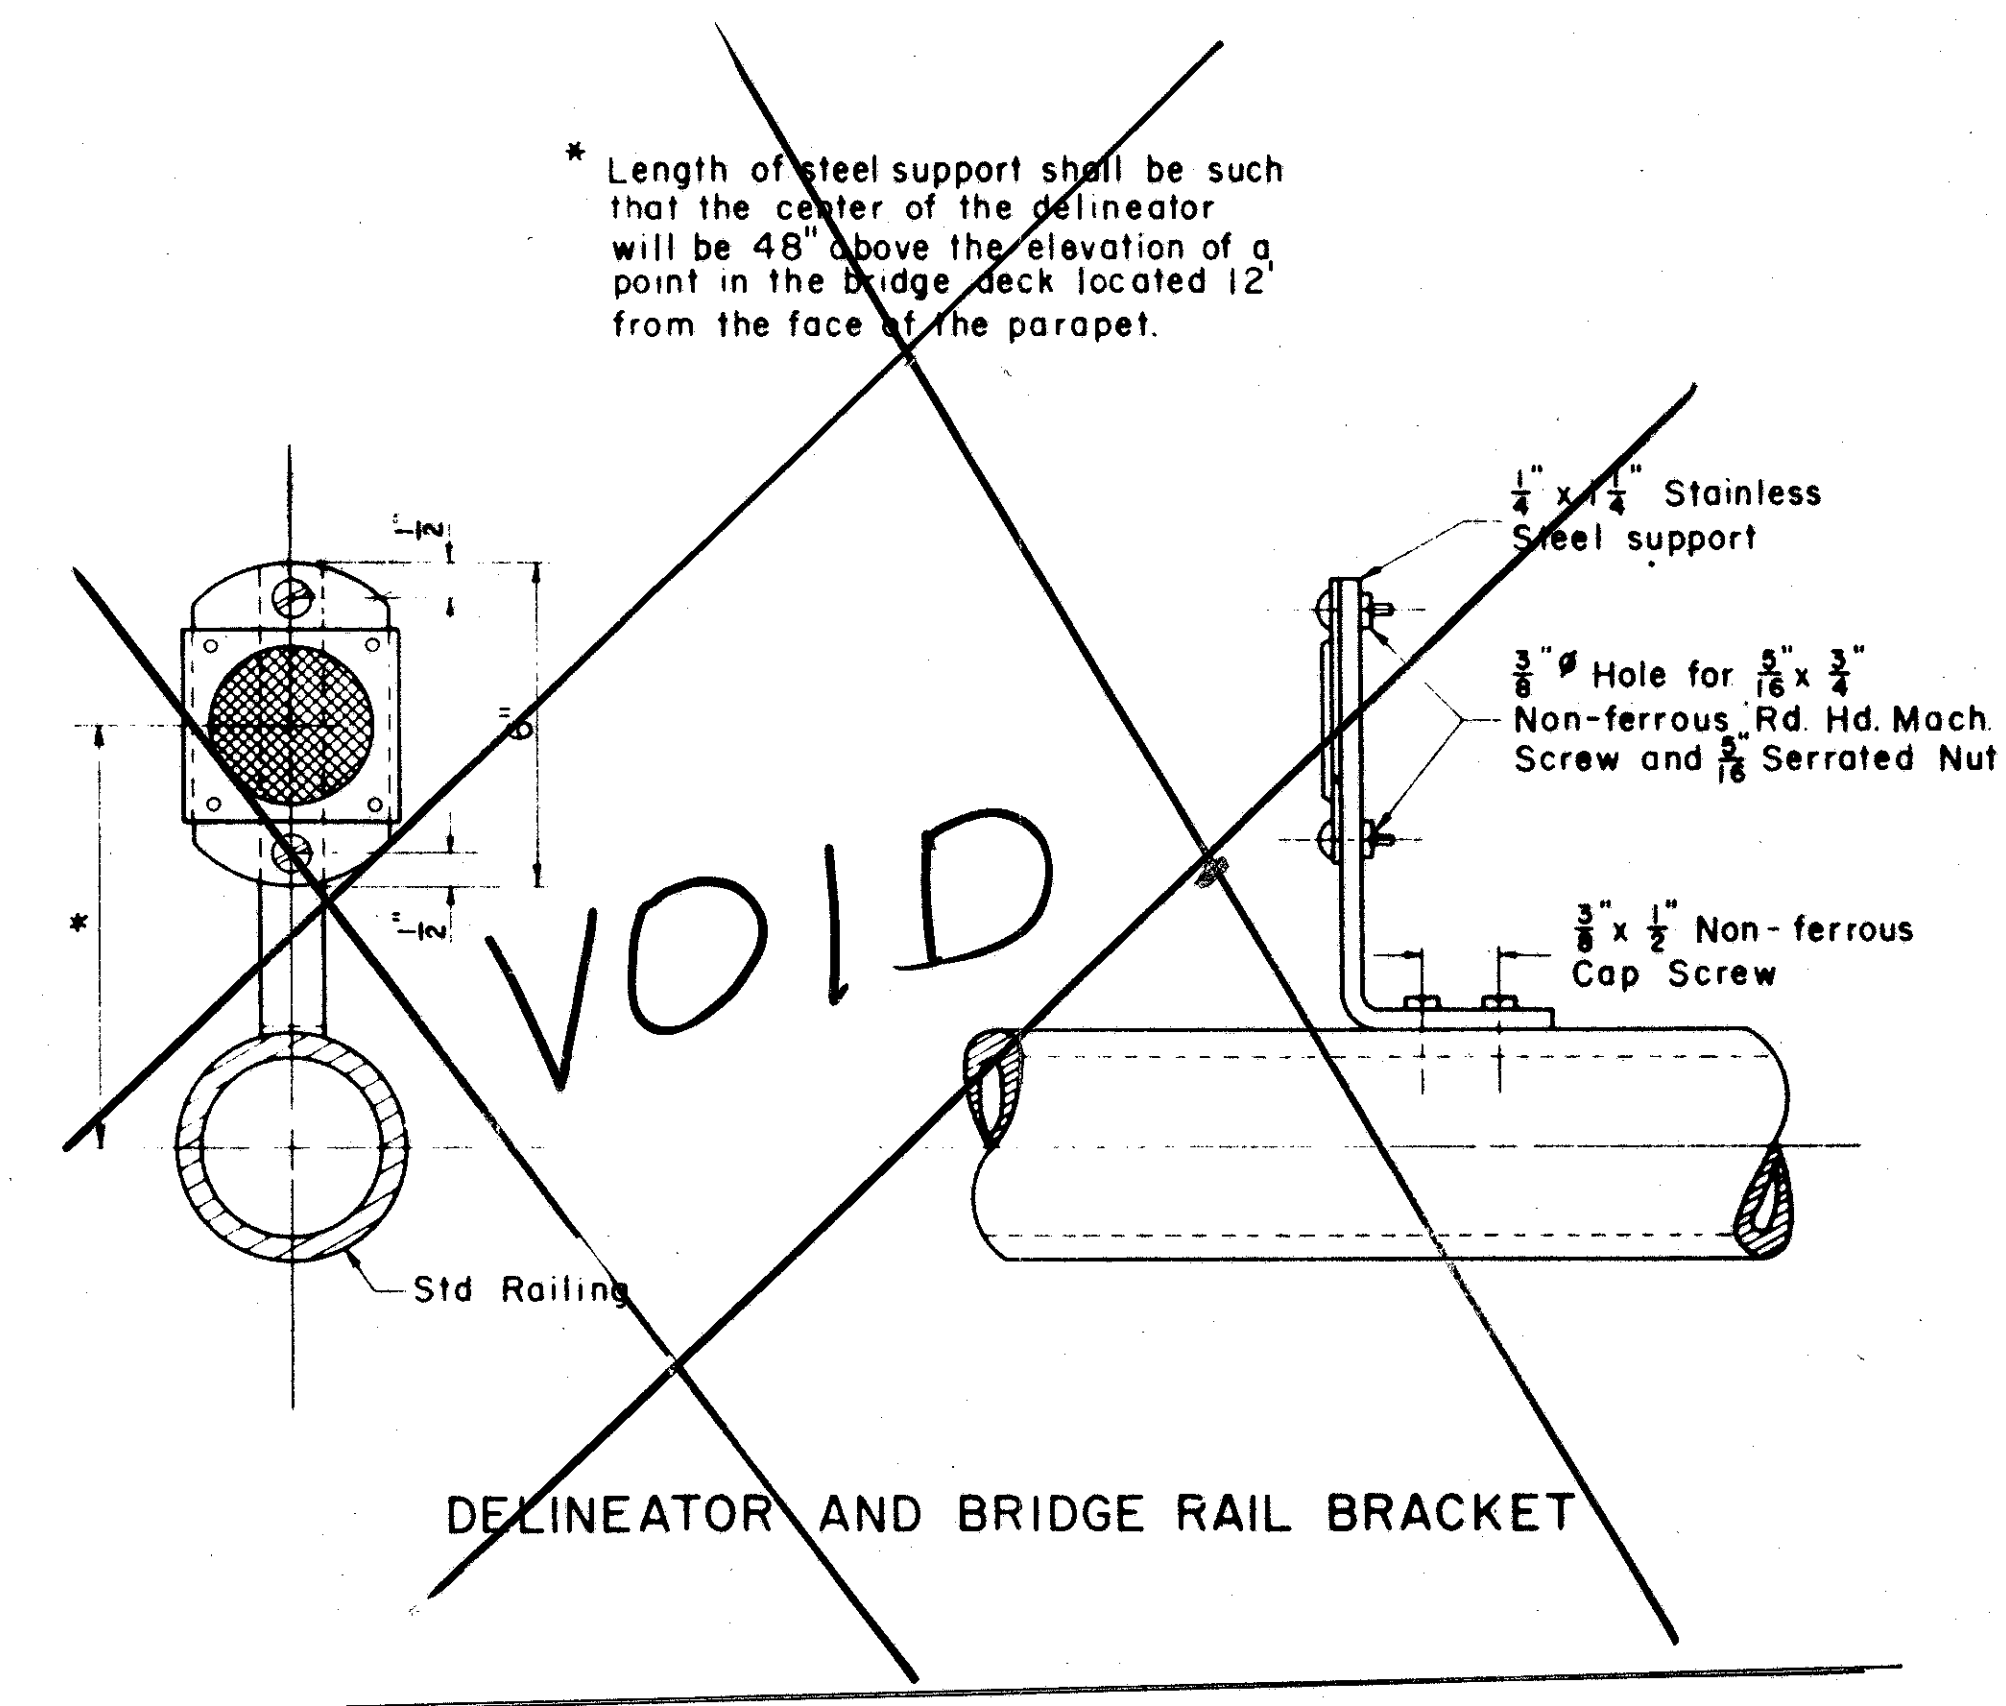

DELINEATOR AND BRIDGE RAIL BRACKET

ITEM I-127 POST MOUNTED DELINEATORS, TYPE B1, AS PER PLAN
The weight of the steel posts furnished for this item shall be 2.00 lbs per foot in lieu of the 1.12 lbs. per foot called for in Supplemental Specification No. I-127.