


FED. RD. DIVISION	STATE	PROJECT	
2	OHIO		

269
277

LAK-1-6.97
R/W PLAN
LIMITED ACCESS

8
16

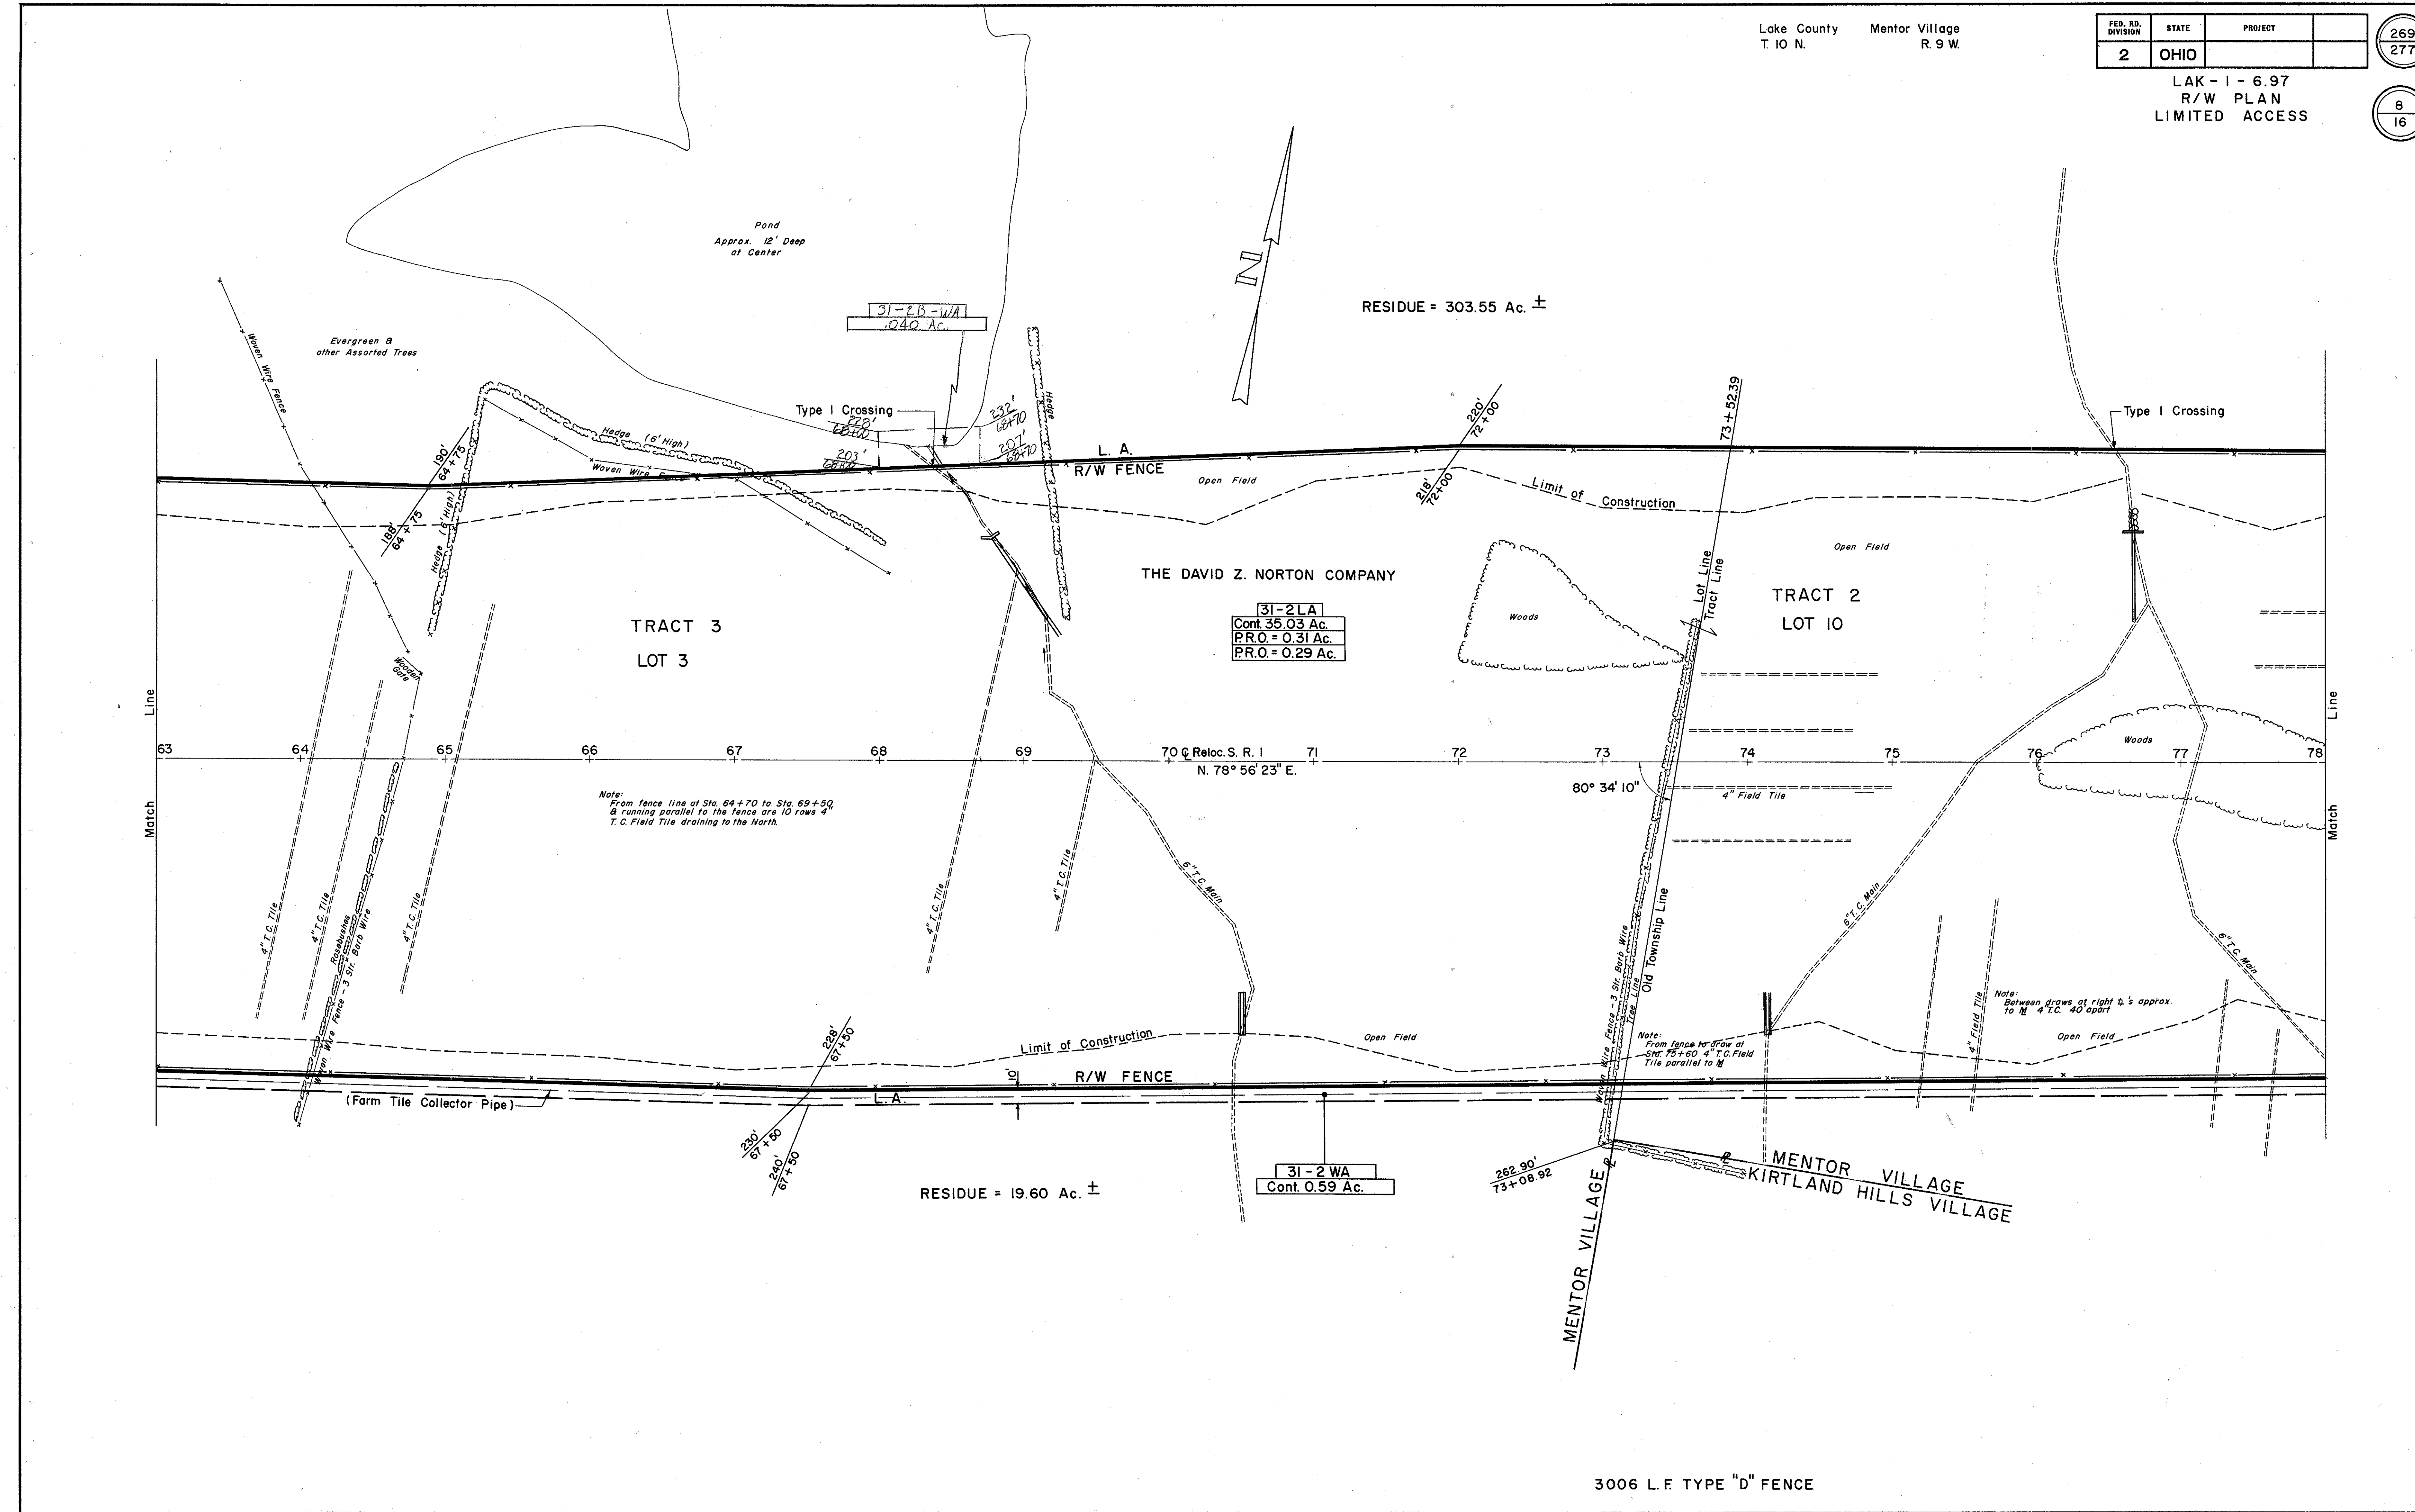

3006 L.F. TYPE "D" FENCE