


LAK - 1 - 6.97
R/W PLAN
LIMITED ACCESS

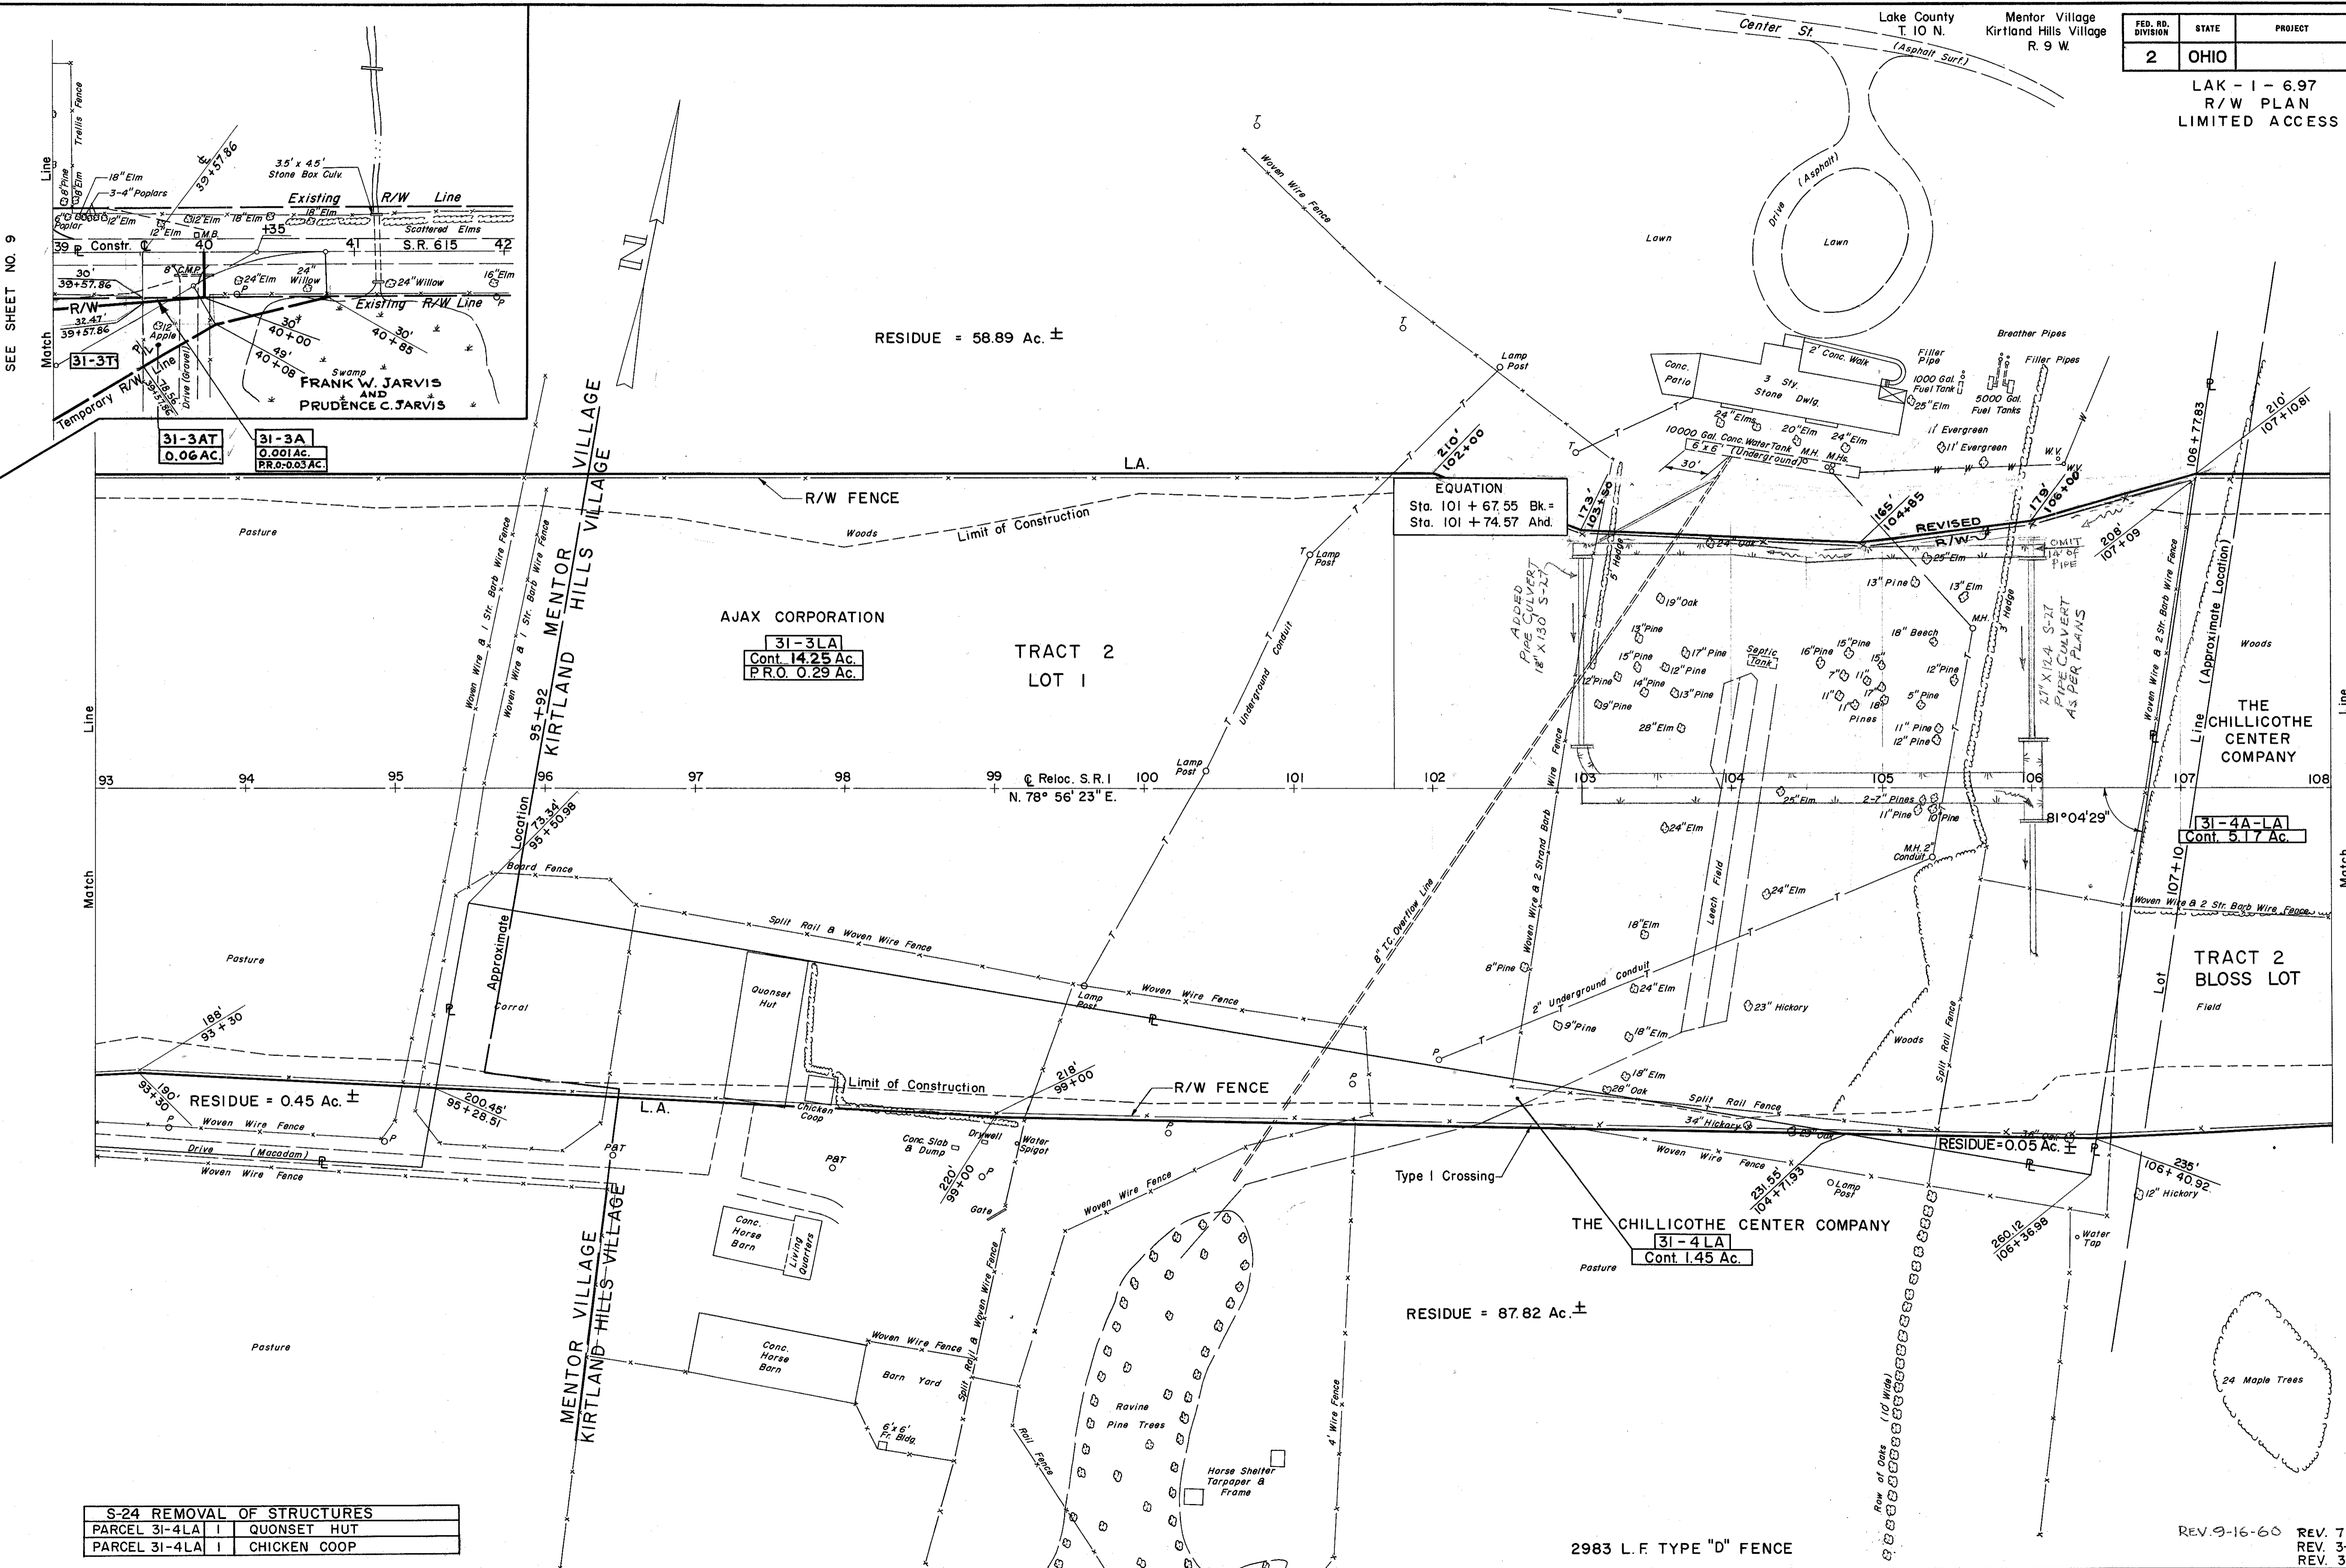

SEE SHEET NO. 9

| S-24 REMOVAL OF STRUCTURES | | |
|----------------------------|---|--------------|
| PARCEL 31-4LA | 1 | QUONSET HUT |
| PARCEL 31-4LA | 1 | CHICKEN COOP |

2983 L.F. TYPE "D" FENCE

REV. 9-16-60 REV. 7-5-60
REV. 3-29-60 REV. 3-9-60