



(B1) RAMP B @ CURVE DATA

P.I. STA.	79+53.91
Δ	26° 00' 12" LT.
RP	6° 30' 00"
RS	881.47'
LS	199.89'
LT	6° 29' 48"
ST	133.35'
TS	66.71'
TS STA.	400.05'
TS ELEV.	353.87'
SC STA.	260.44'
SC ELEV.	37.67'
e_{max}	0.057
TS STA.	76+00.05
SC STA.	77+99.94
PT STA.	81+99.99

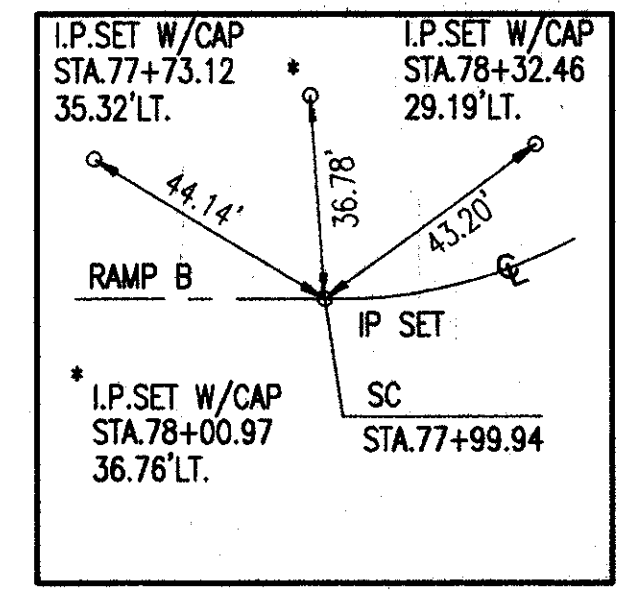

SWTIE#22

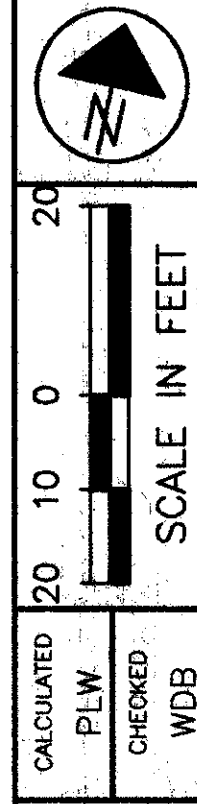

FOR TYPICAL SECTIONS, SEE SHEETS 5 THRU 15
 FOR CROSS SECTIONS AND PIPE PROFILES, SEE SHEETS 194 THRU 210
 FOR SUPERELEVATION TABLES, SEE SHEETS 246 THRU 254
 FOR INTERSECTION DETAILS, SEE SHEETS 255 THRU 262
 FOR SIGNING AND PAVEMENT MARKING PLAN, SEE SHEETS 308 THRU 310

780	763.60	763.60	763.60	763.60	763.57	763.52	763.46	763.38	763.28	763.17	763.05	762.90	762.74	762.57	762.38	780
775																775
765	0.00%	0.00%	0.00%	0.00%	0.04%	0.08%					0.16%	0.92%				765
760																760
755																755
750																750
745																745
76+00	77+00				78+00				79+00						80+00	

604	MANHOLE NO. 3, AS PER PLAN	EACH														1
603	36" CONDUIT, TYPE A, 706.02, AS PER PLAN	UN.FT.	23													23
602	CONCRETE MASONRY	CU.YD.	0.69													0.69
601	ROCK CHANNEL PROTECTION, TYPE C, WITH FILTER	CU.YD.	3.33													3.33
601	RIPRAP 6" REINFORCED CONCRETE SLAB	SQ.YD.	3.33													3.33
202	STRUCTURE REMOVED, AS PER PLAN	EACH														1
TOTALS																1

RAMP B
 RAMP B - PLAN AND PROFILE STA. 76+00 TO STA. 80+00

LAK-IR90/SR615-9.26/1.51

