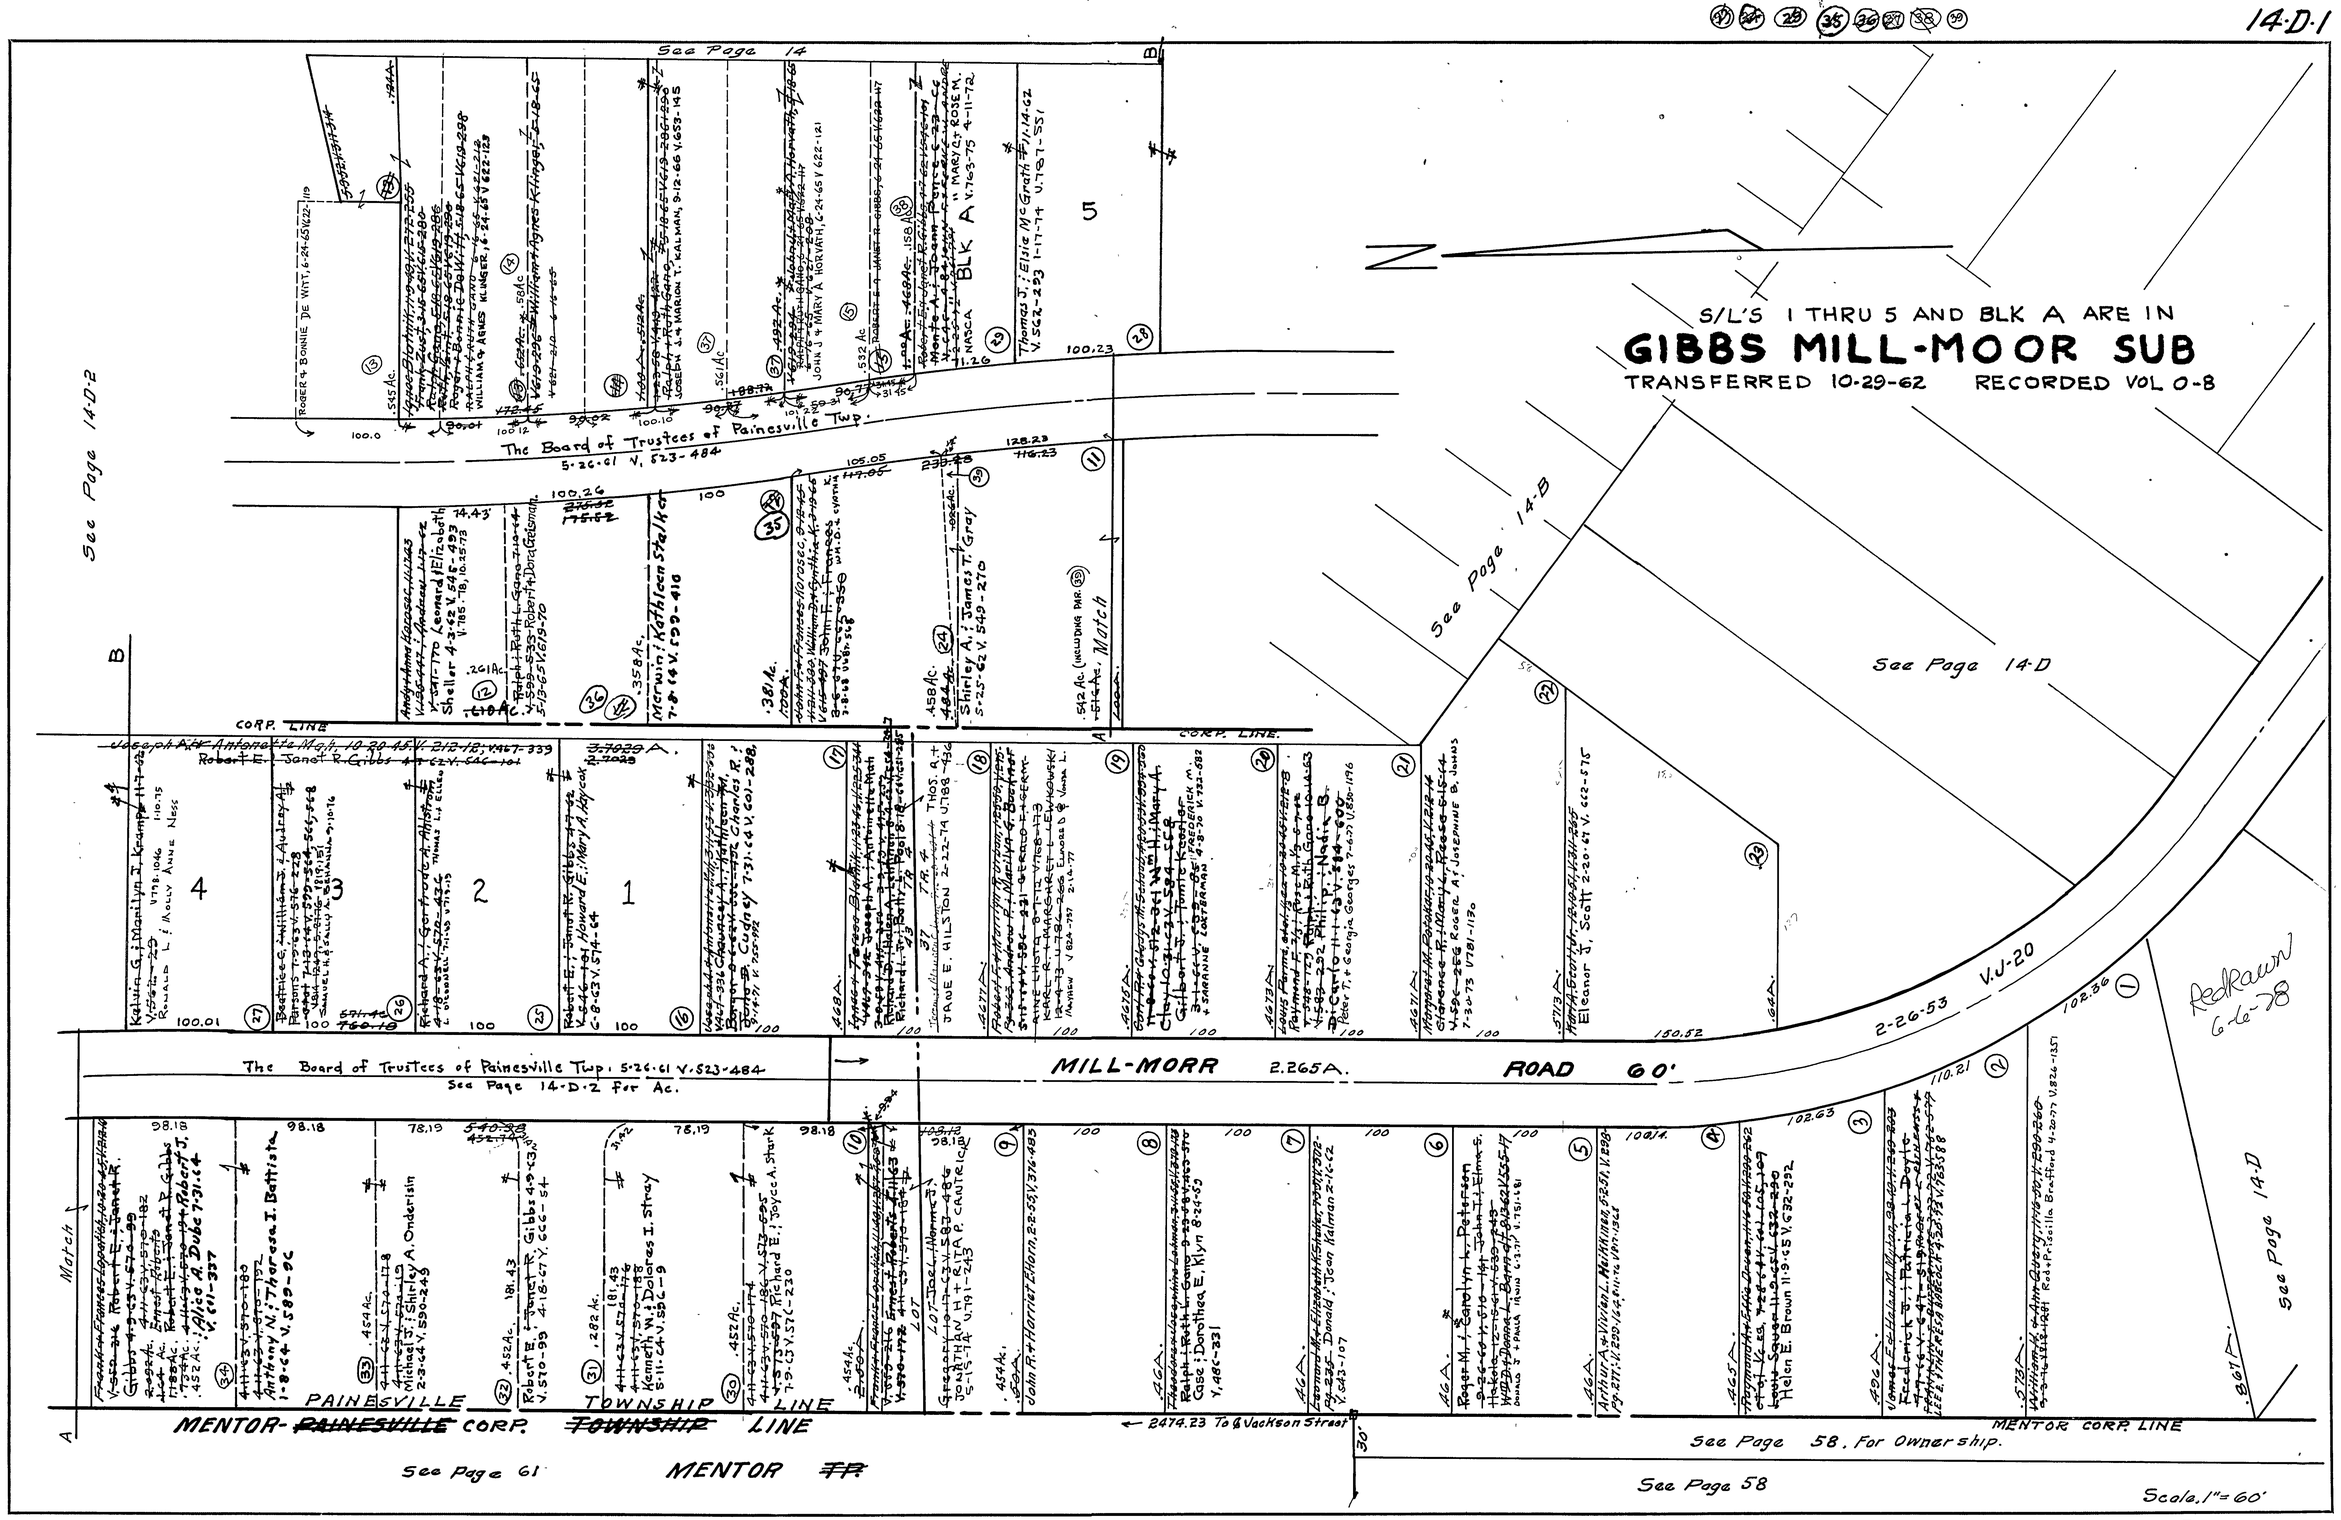
S/L'S 1 THRU 5 AND BLK A ARE IN
GIBBS MILL-MOOR SUB
TRANSFERRED 10-29-62 RECORDED VOL 0-8
See Page 14
See Page 14-D-2
See Page 14-B
See Page 14-D
See Page 14-D
The Board of Trustees of Painesville Twp.
5-26-61 V. 523-484
CORP. LINE
MILL-MORR 2.265A. ROAD 60'
2-26-53 V.J-20
The Board of Trustees of Painesville Twp. 5-26-61 V. 523-484
See Page 14-D-2 for Ac.
PAINESVILLE TOWNSHIP LINE
MENTOR-~~PAINESVILLE~~ CORP. ~~TOWNSHIP~~ LINE
MENTOR ~~TP.~~
See Page 61
MENTOR CORP. LINE
See Page 58. For Ownership.
See Page 58
Scale, 1" = 60'
Redrawn 6-6-78